PARENT PARCEL: 04-00-014-106-005

CHILD PARCEL: 04-00-014-106-054 & -055 33-WD LOR-83-16.76

STARTING POINT: I.P. MON. BOX, CL OF WYNDEMERE WAY & EAST R.O.W. OF CENTER RD. (S.R. 83)

25-00865

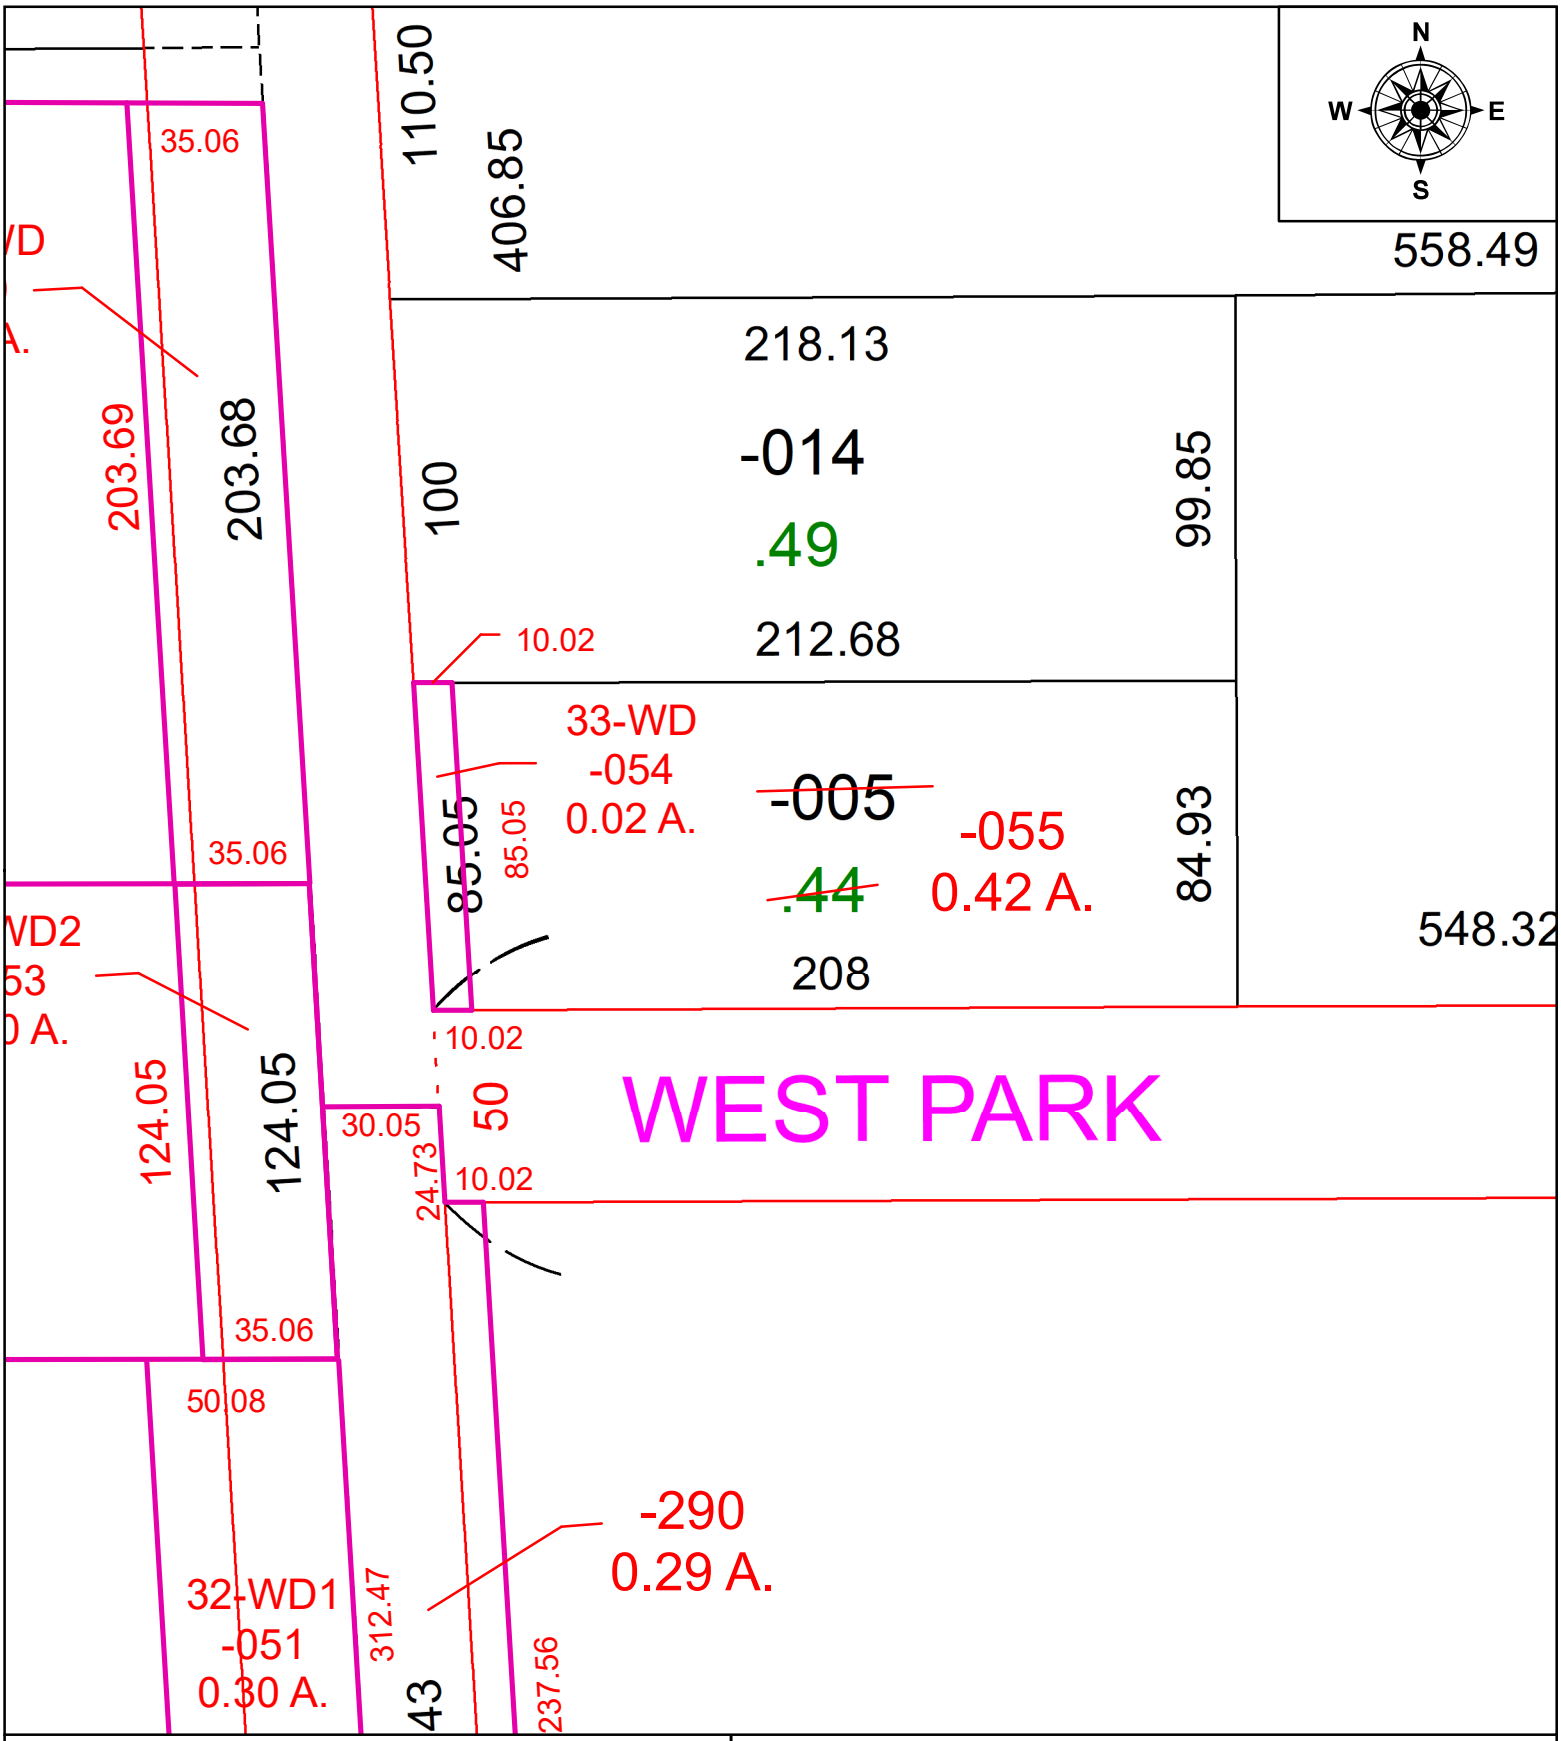

SPLITS/DEEDS PROCESSED

LORAIN COUNTY TAX MAP DEPARTMENT
226 MIDDLE AVE. ELYRIA, OH

SURVEYED BY: DONALD SHEEHY
CLOSURE: 1: INF
MAP PAGE(S): 04-00-014
APPOVED BY: TJS **DATE:** 5/12/2025
SCALE: 1" = 50' **PRIOR INSTRUMENT:** 2012-0416772