PARENT PARCEL: 04-00-016-102-025

CHILD PARCEL: 04-00-016-102-010 & -011

STARTING POINT: 5/8" I.P. FD. S.E. CORNER OF ORIGINAL AVON SEC. 16

25-05111

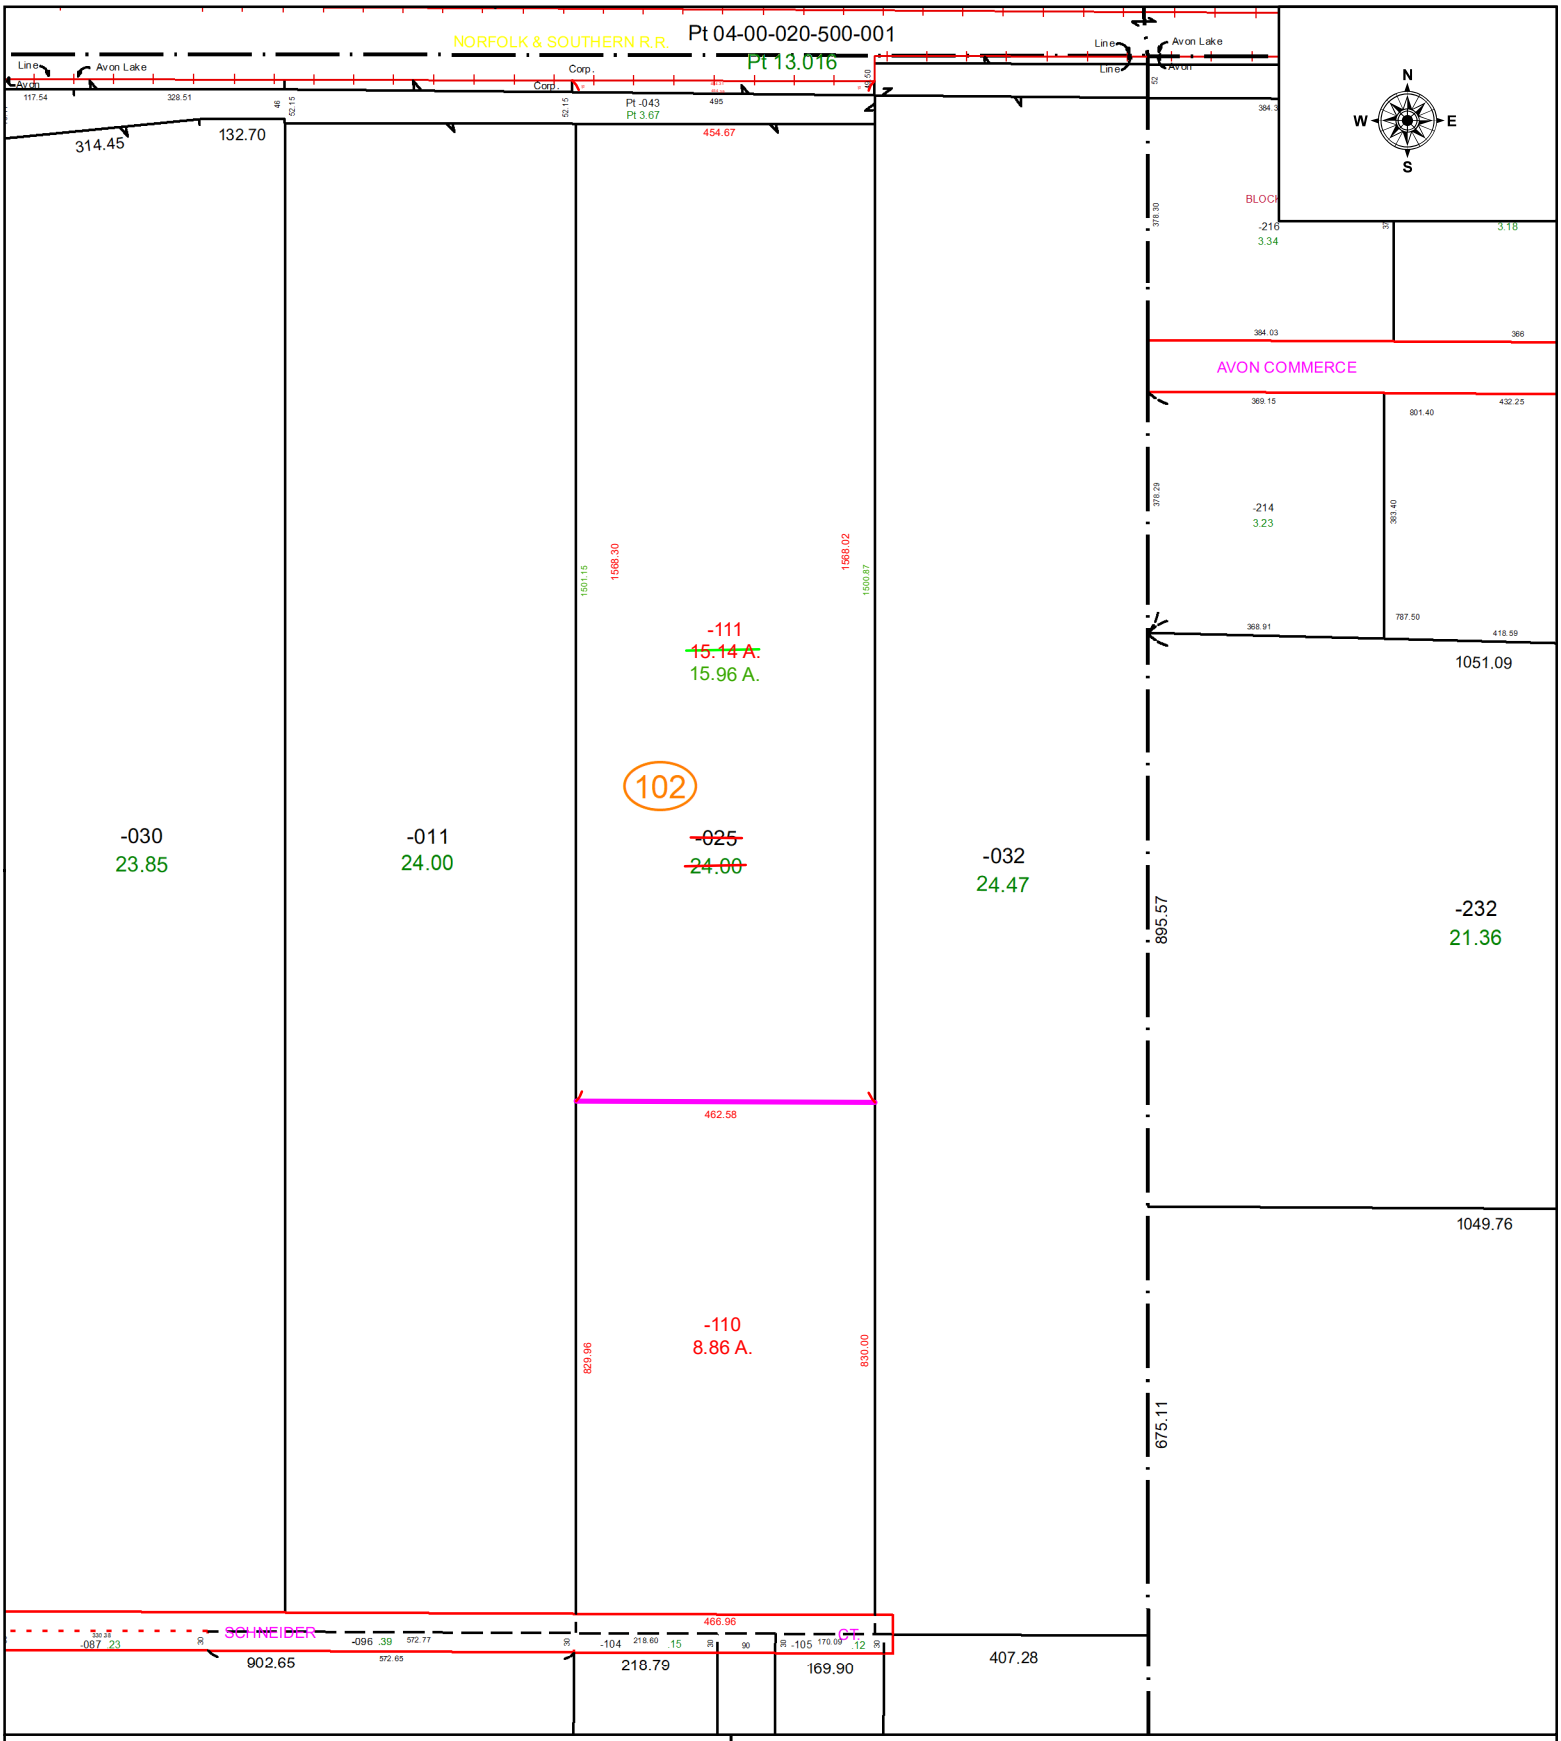

SPLITS/DEEDS PROCESSED

LORAIN COUNTY TAX MAP DEPARTMENT
226 MIDDLE AVE. ELYRIA, OH

SURVEYED BY: AMY KELLY

SURVEY # 51624

CLOSURE: 1: 67696

MAP PAGE(S): 4-00-016

APPOVED BY: TJS **DATE:** 12/30/2025

SCALE: 1" = 300' **PRIOR INSTRUMENT:** 2025-0052991