



SEE 4-00-021-H

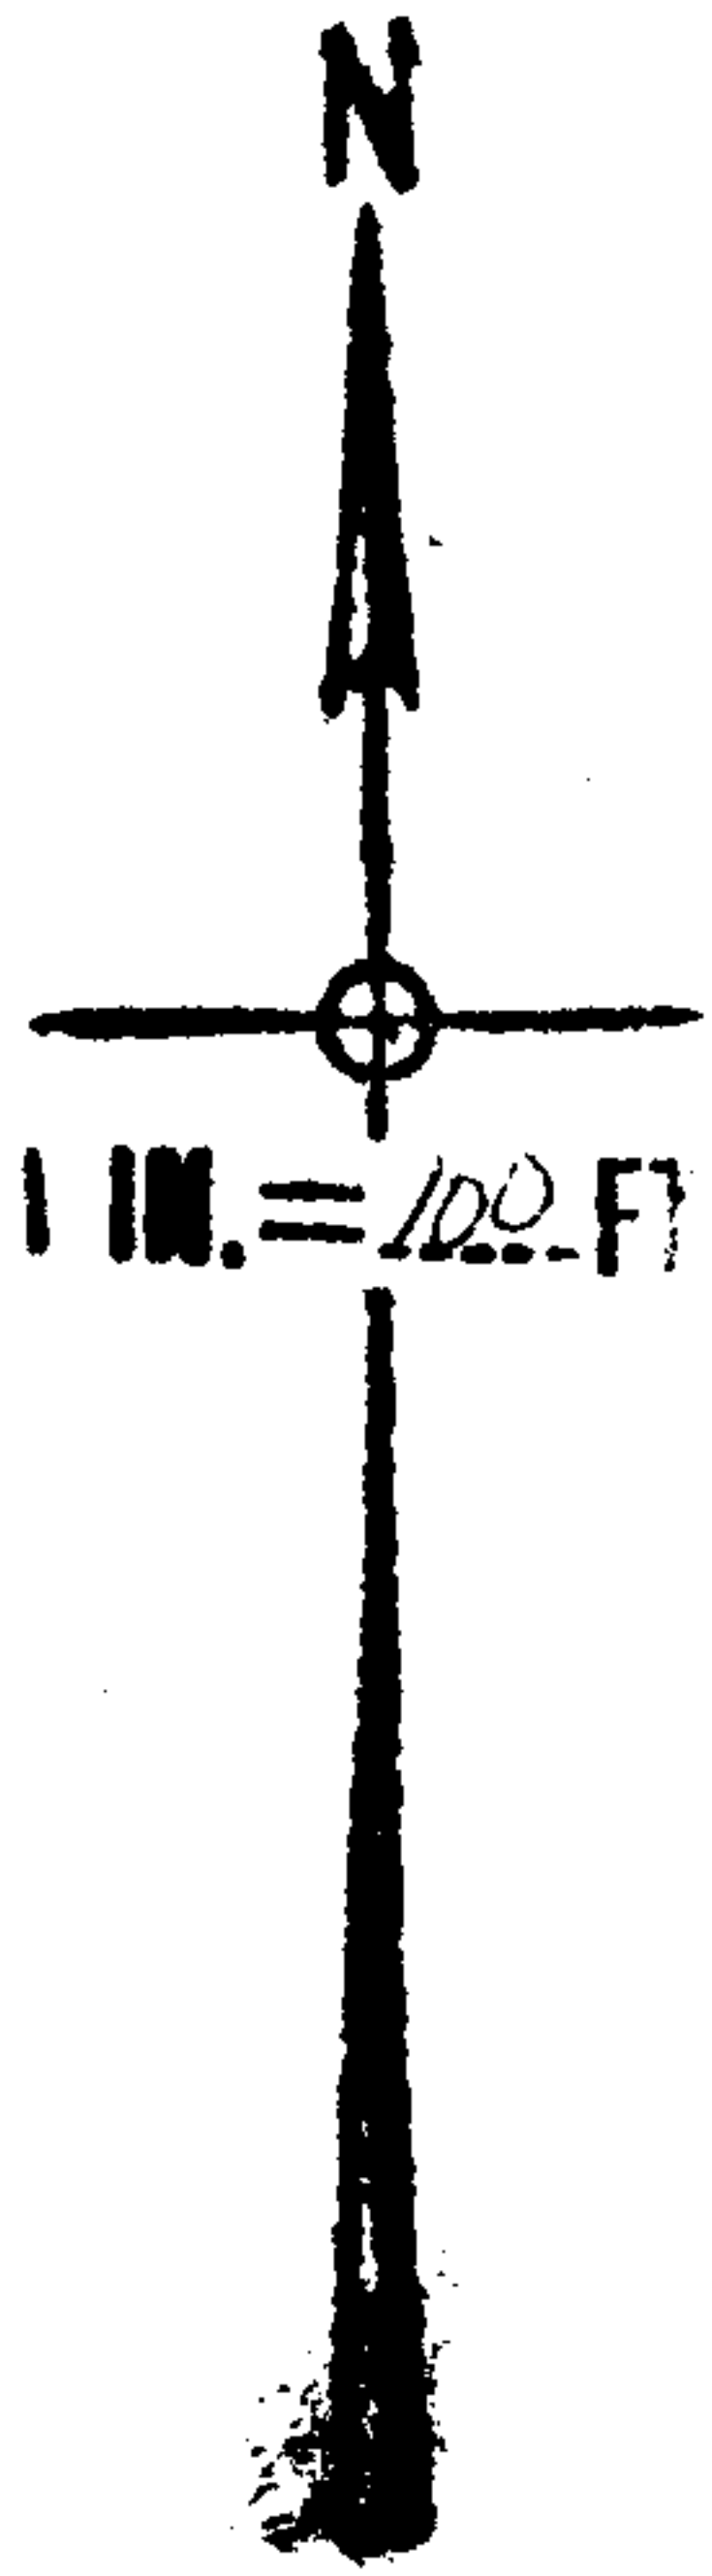

2508
APR 28 1959

APPROVED
LORAIN CO.
MAP DEPT.
DATE 3-10-69
4-00-028-E
BY *Holler*

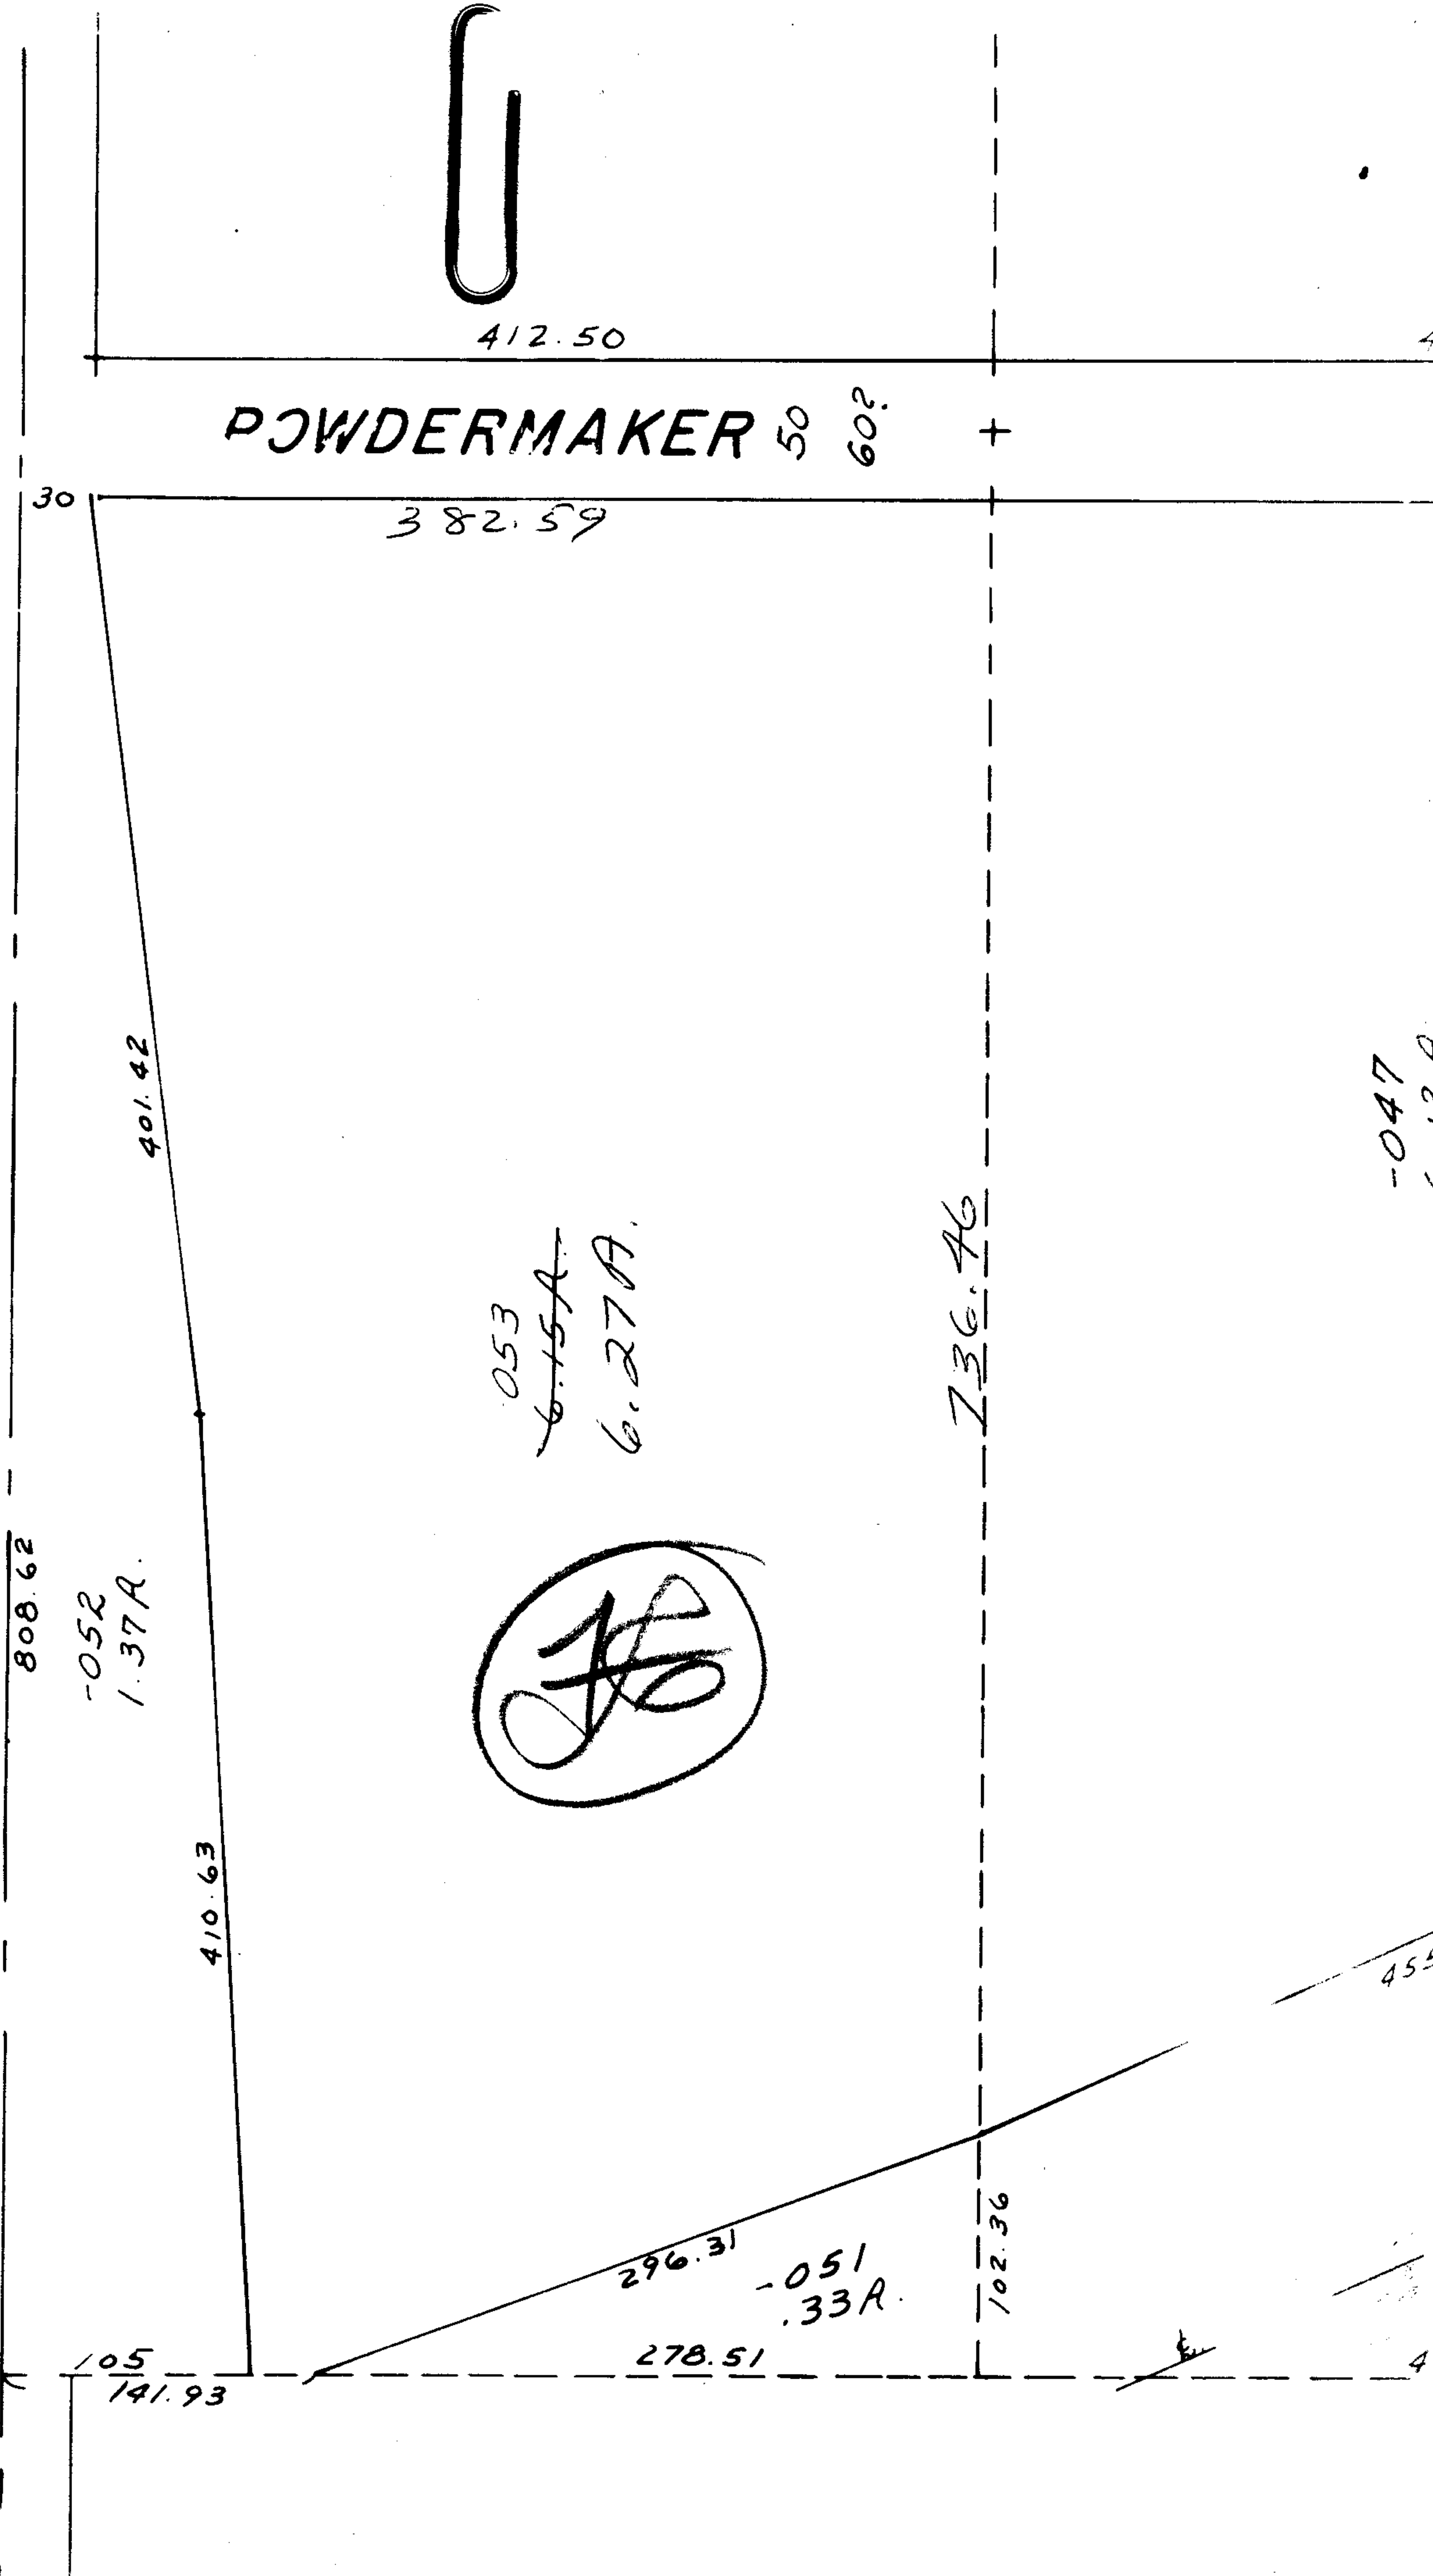

-047
6.12A

455