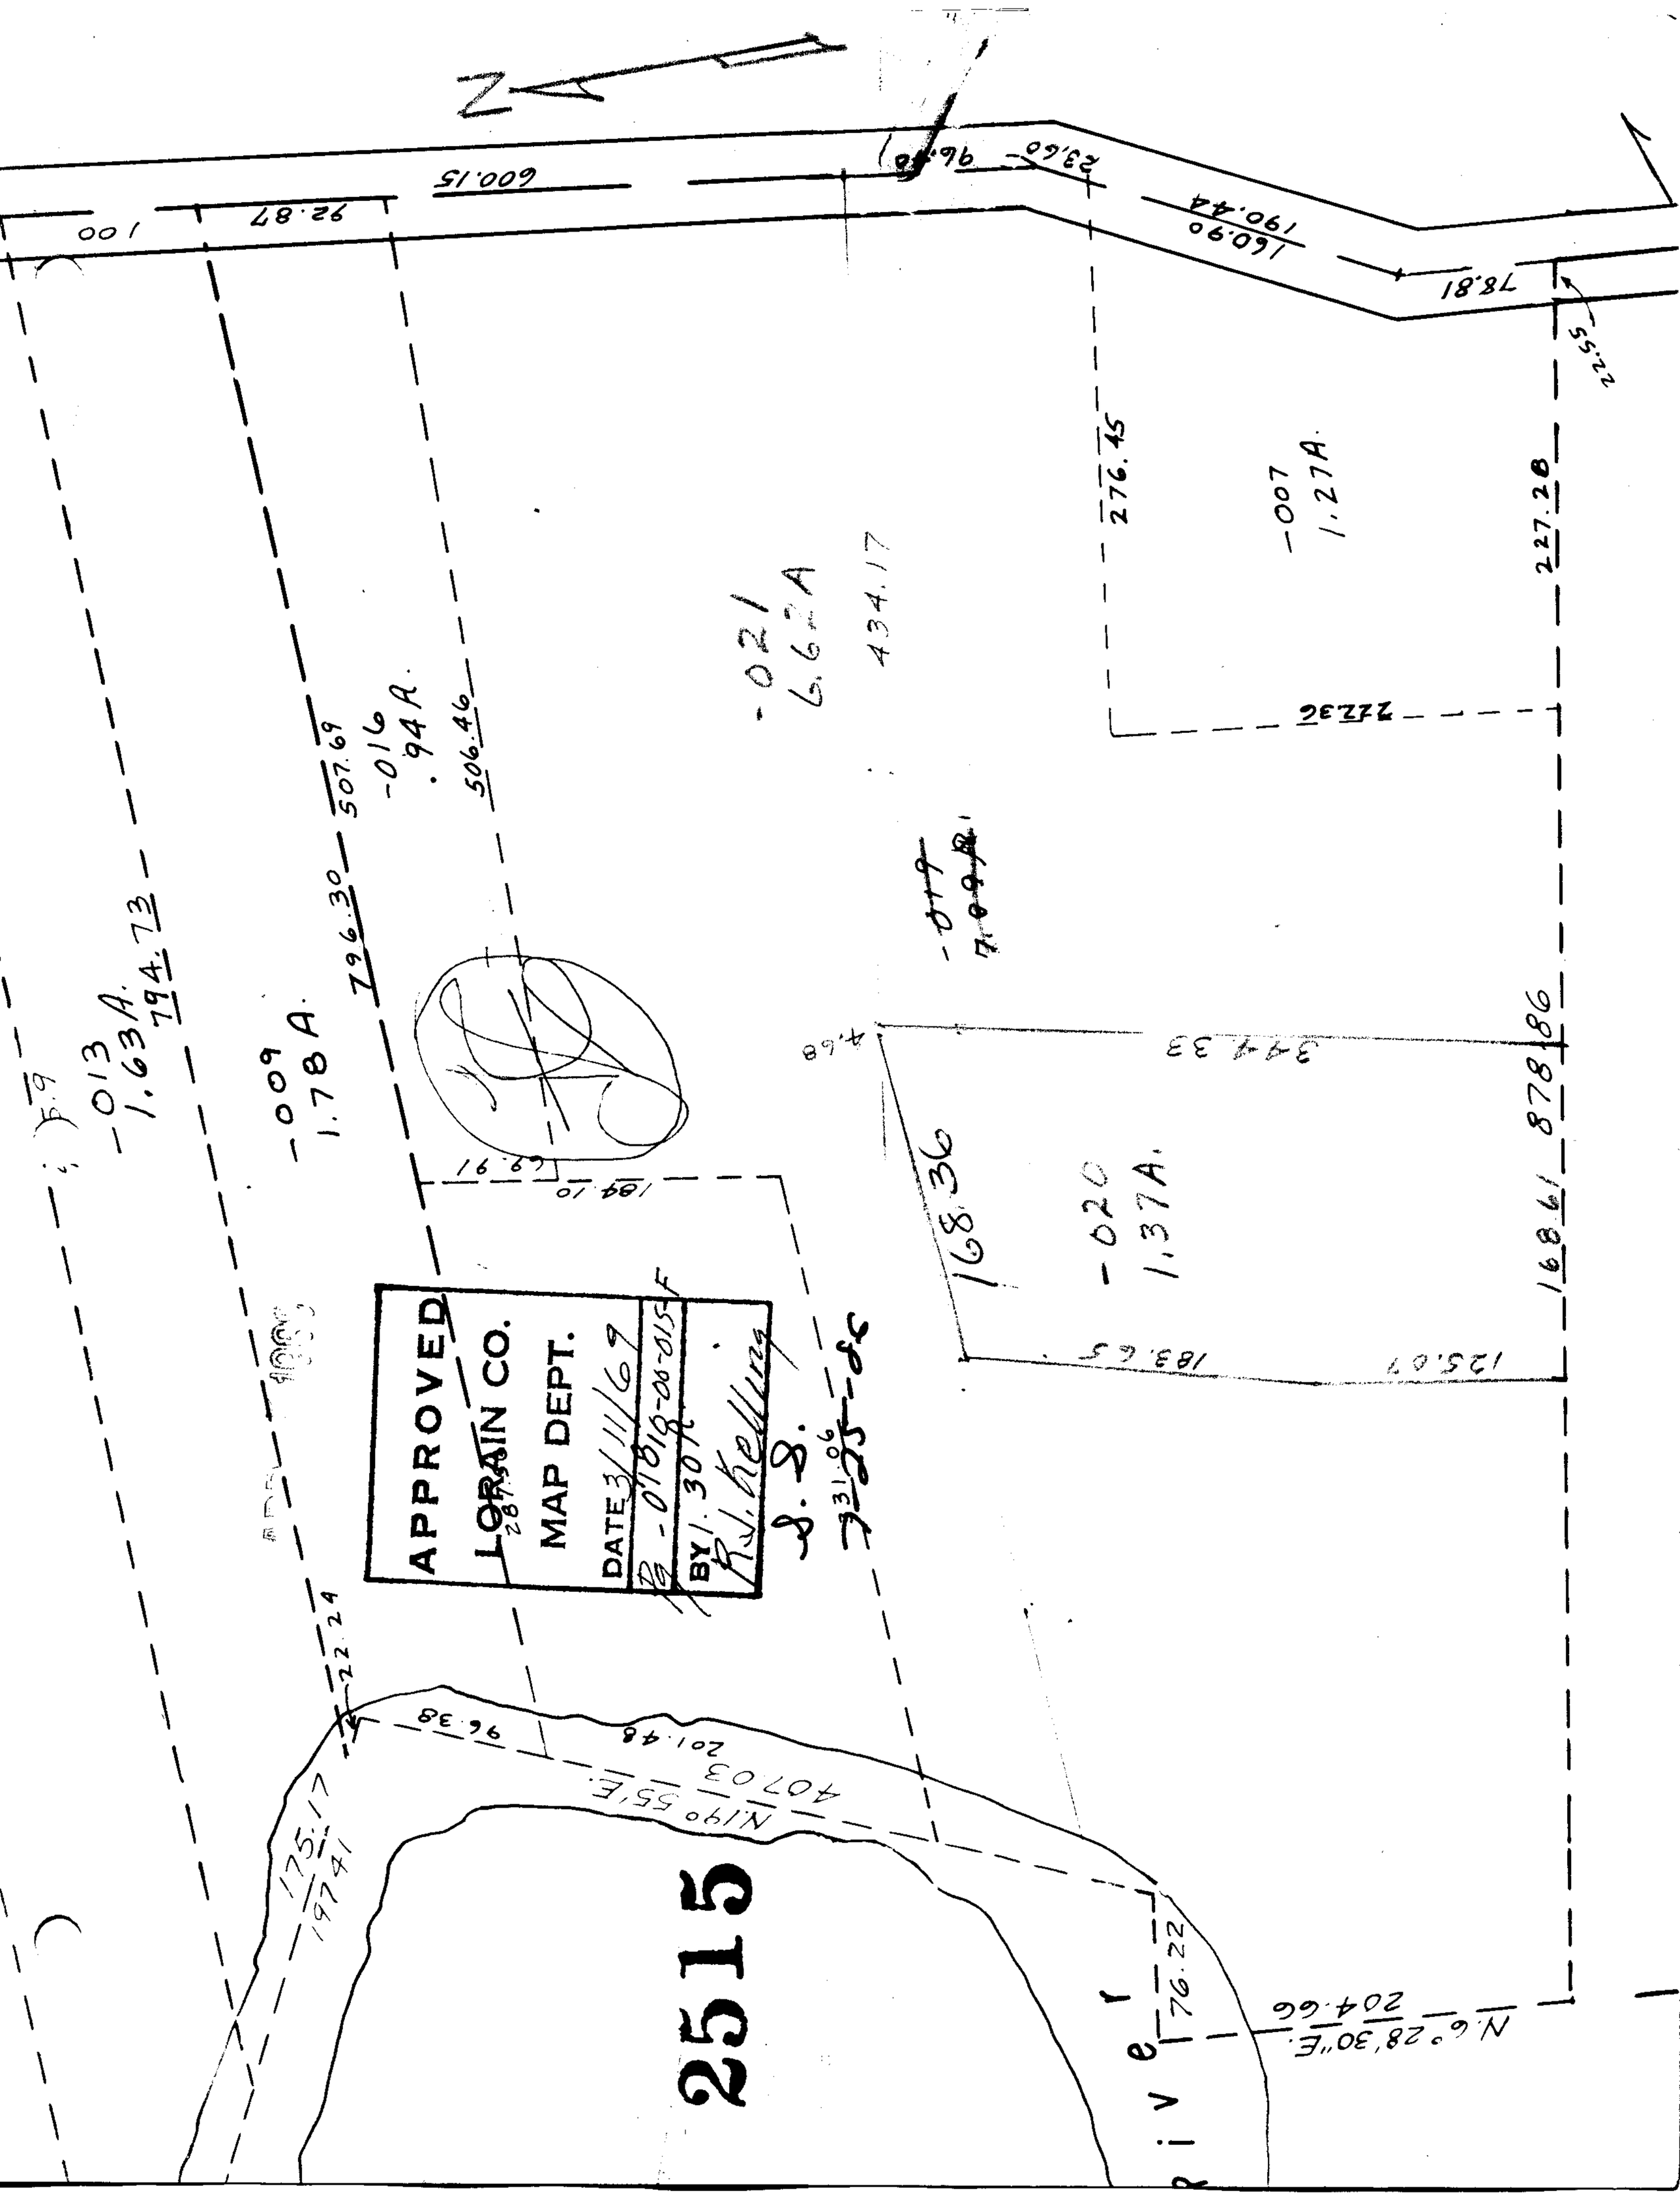

N
APPROVED
LORAIN CO.
MAP DEPT.
DATE 3/11/69
BY
2515
River