



2516 AVE.

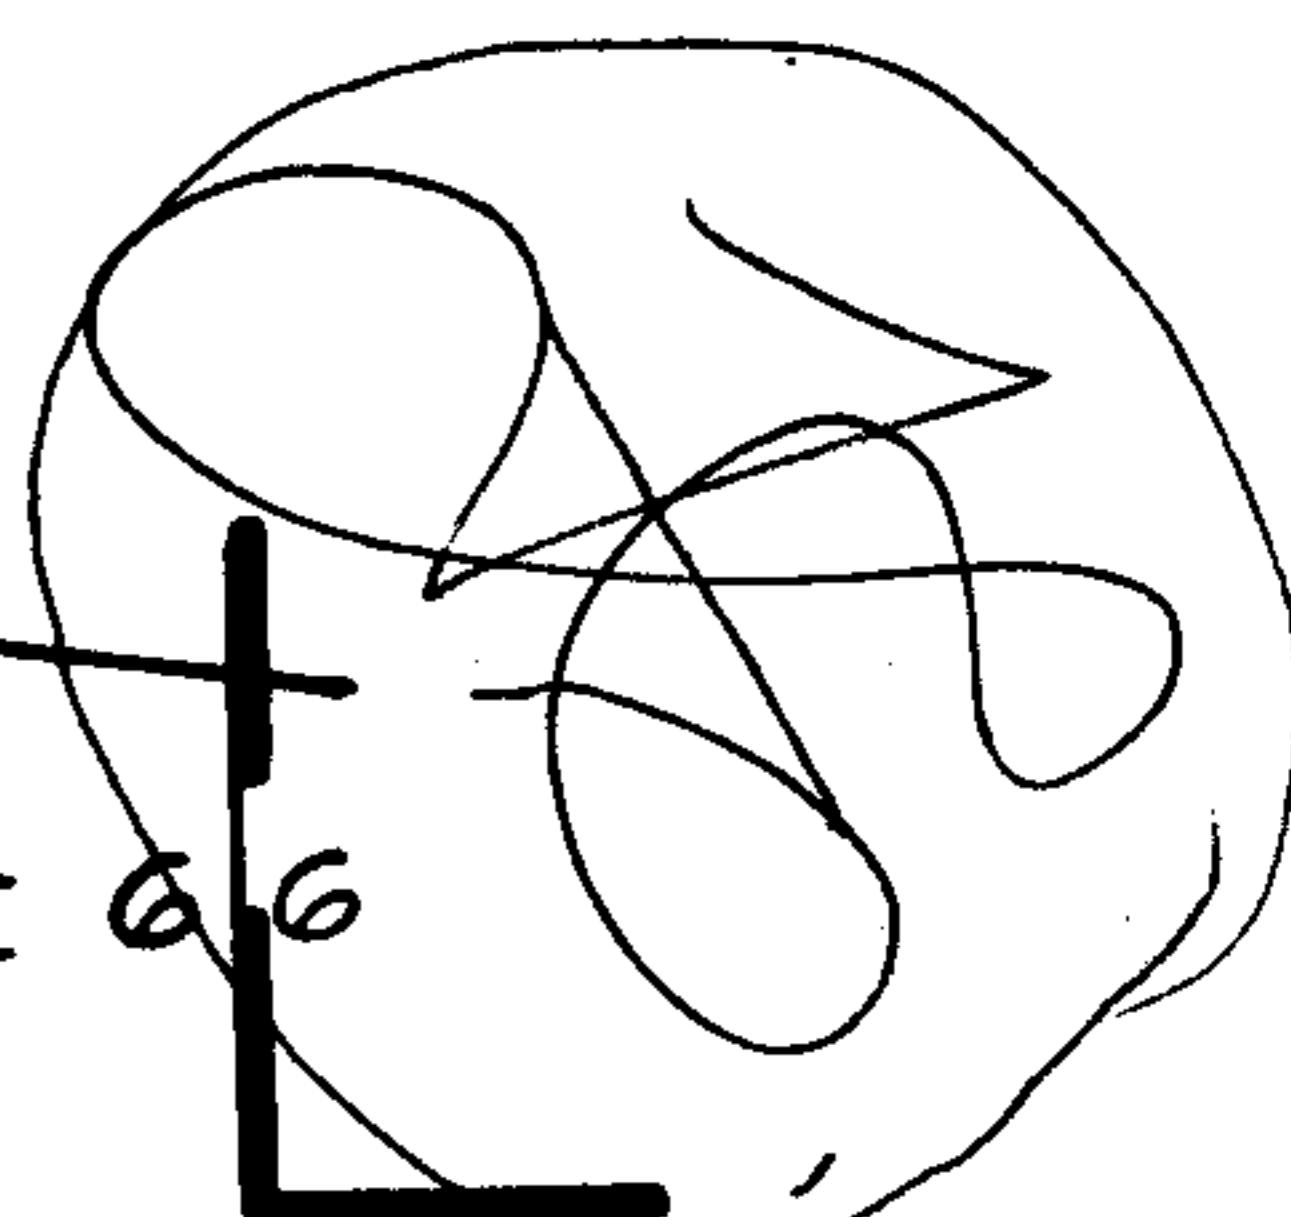

APPROVED
LORAIN CO.
MAP DEPT.
DATE 3/11/69
BY [Signature]

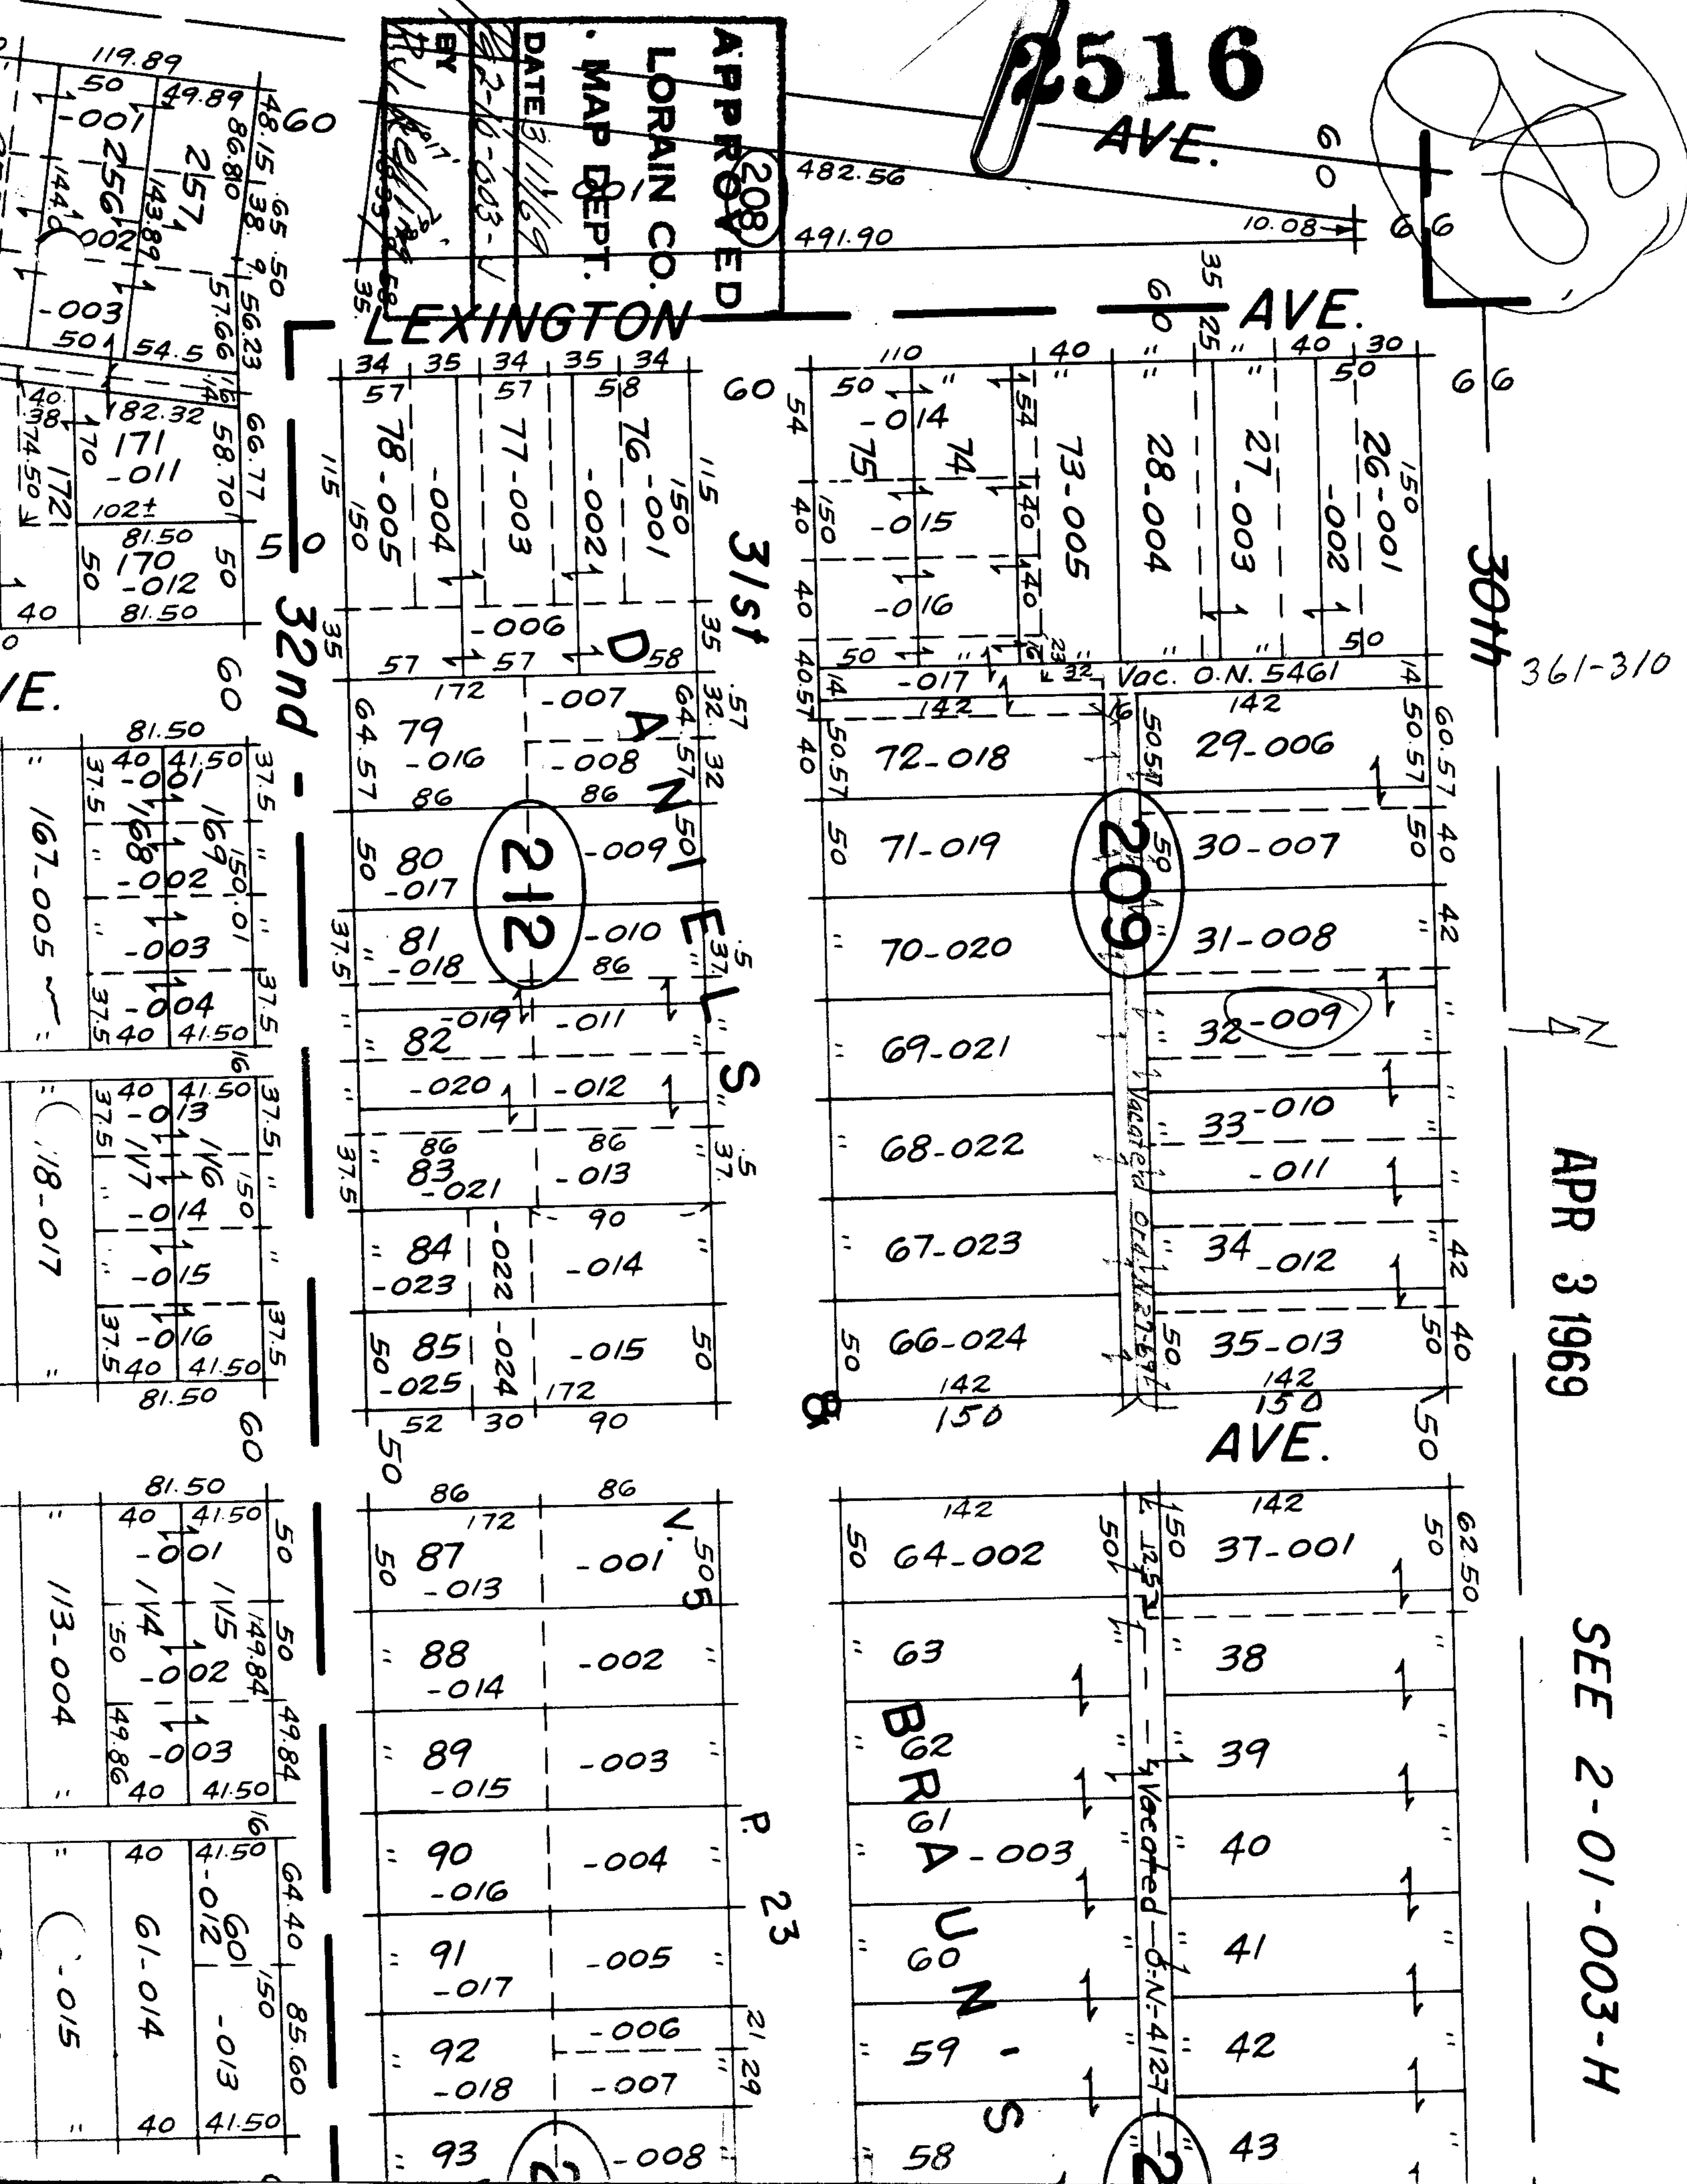

361-310

APR 3 1969

SEE 2-01-003-H