


SEE 11-JOY-099-B

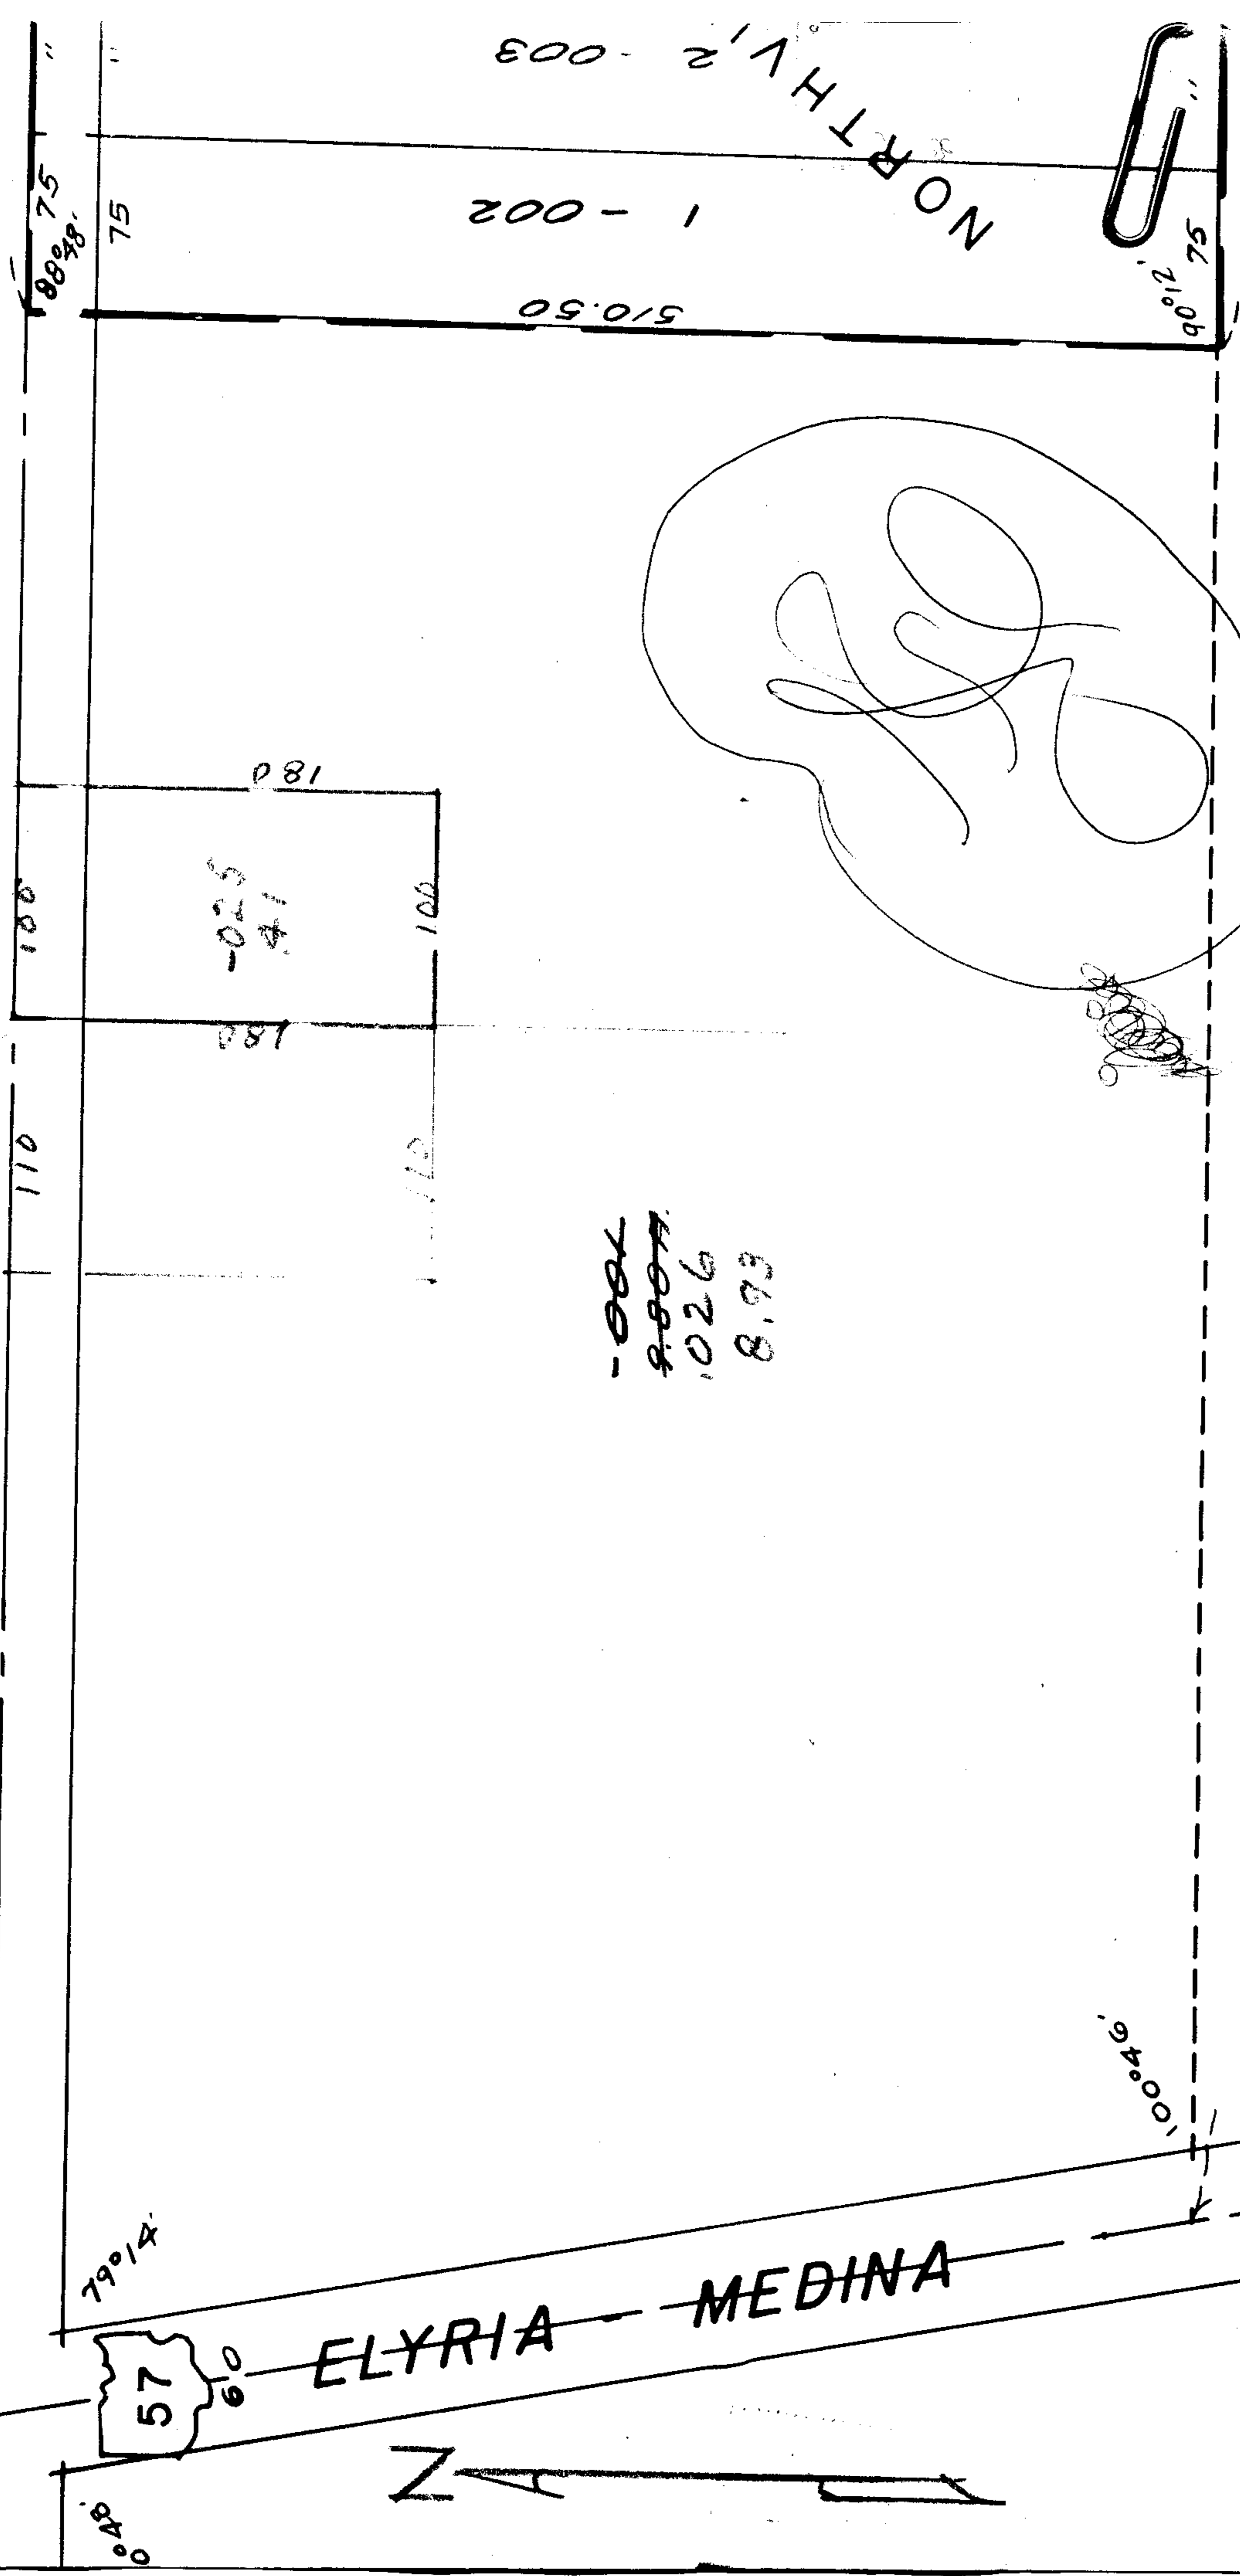

-08X  
9.887  
0.26  
8.93

APPROVED  
 LORAIN CO.  
 MAP DEPT.  
 DATE 3/2/69  
 Pg 11-00-100-B  
 BY Bob Kelling

APR 3 1969

-021  
5.94 A

2518



ELYRIA - MEDINA

