


643.03
208
135.03

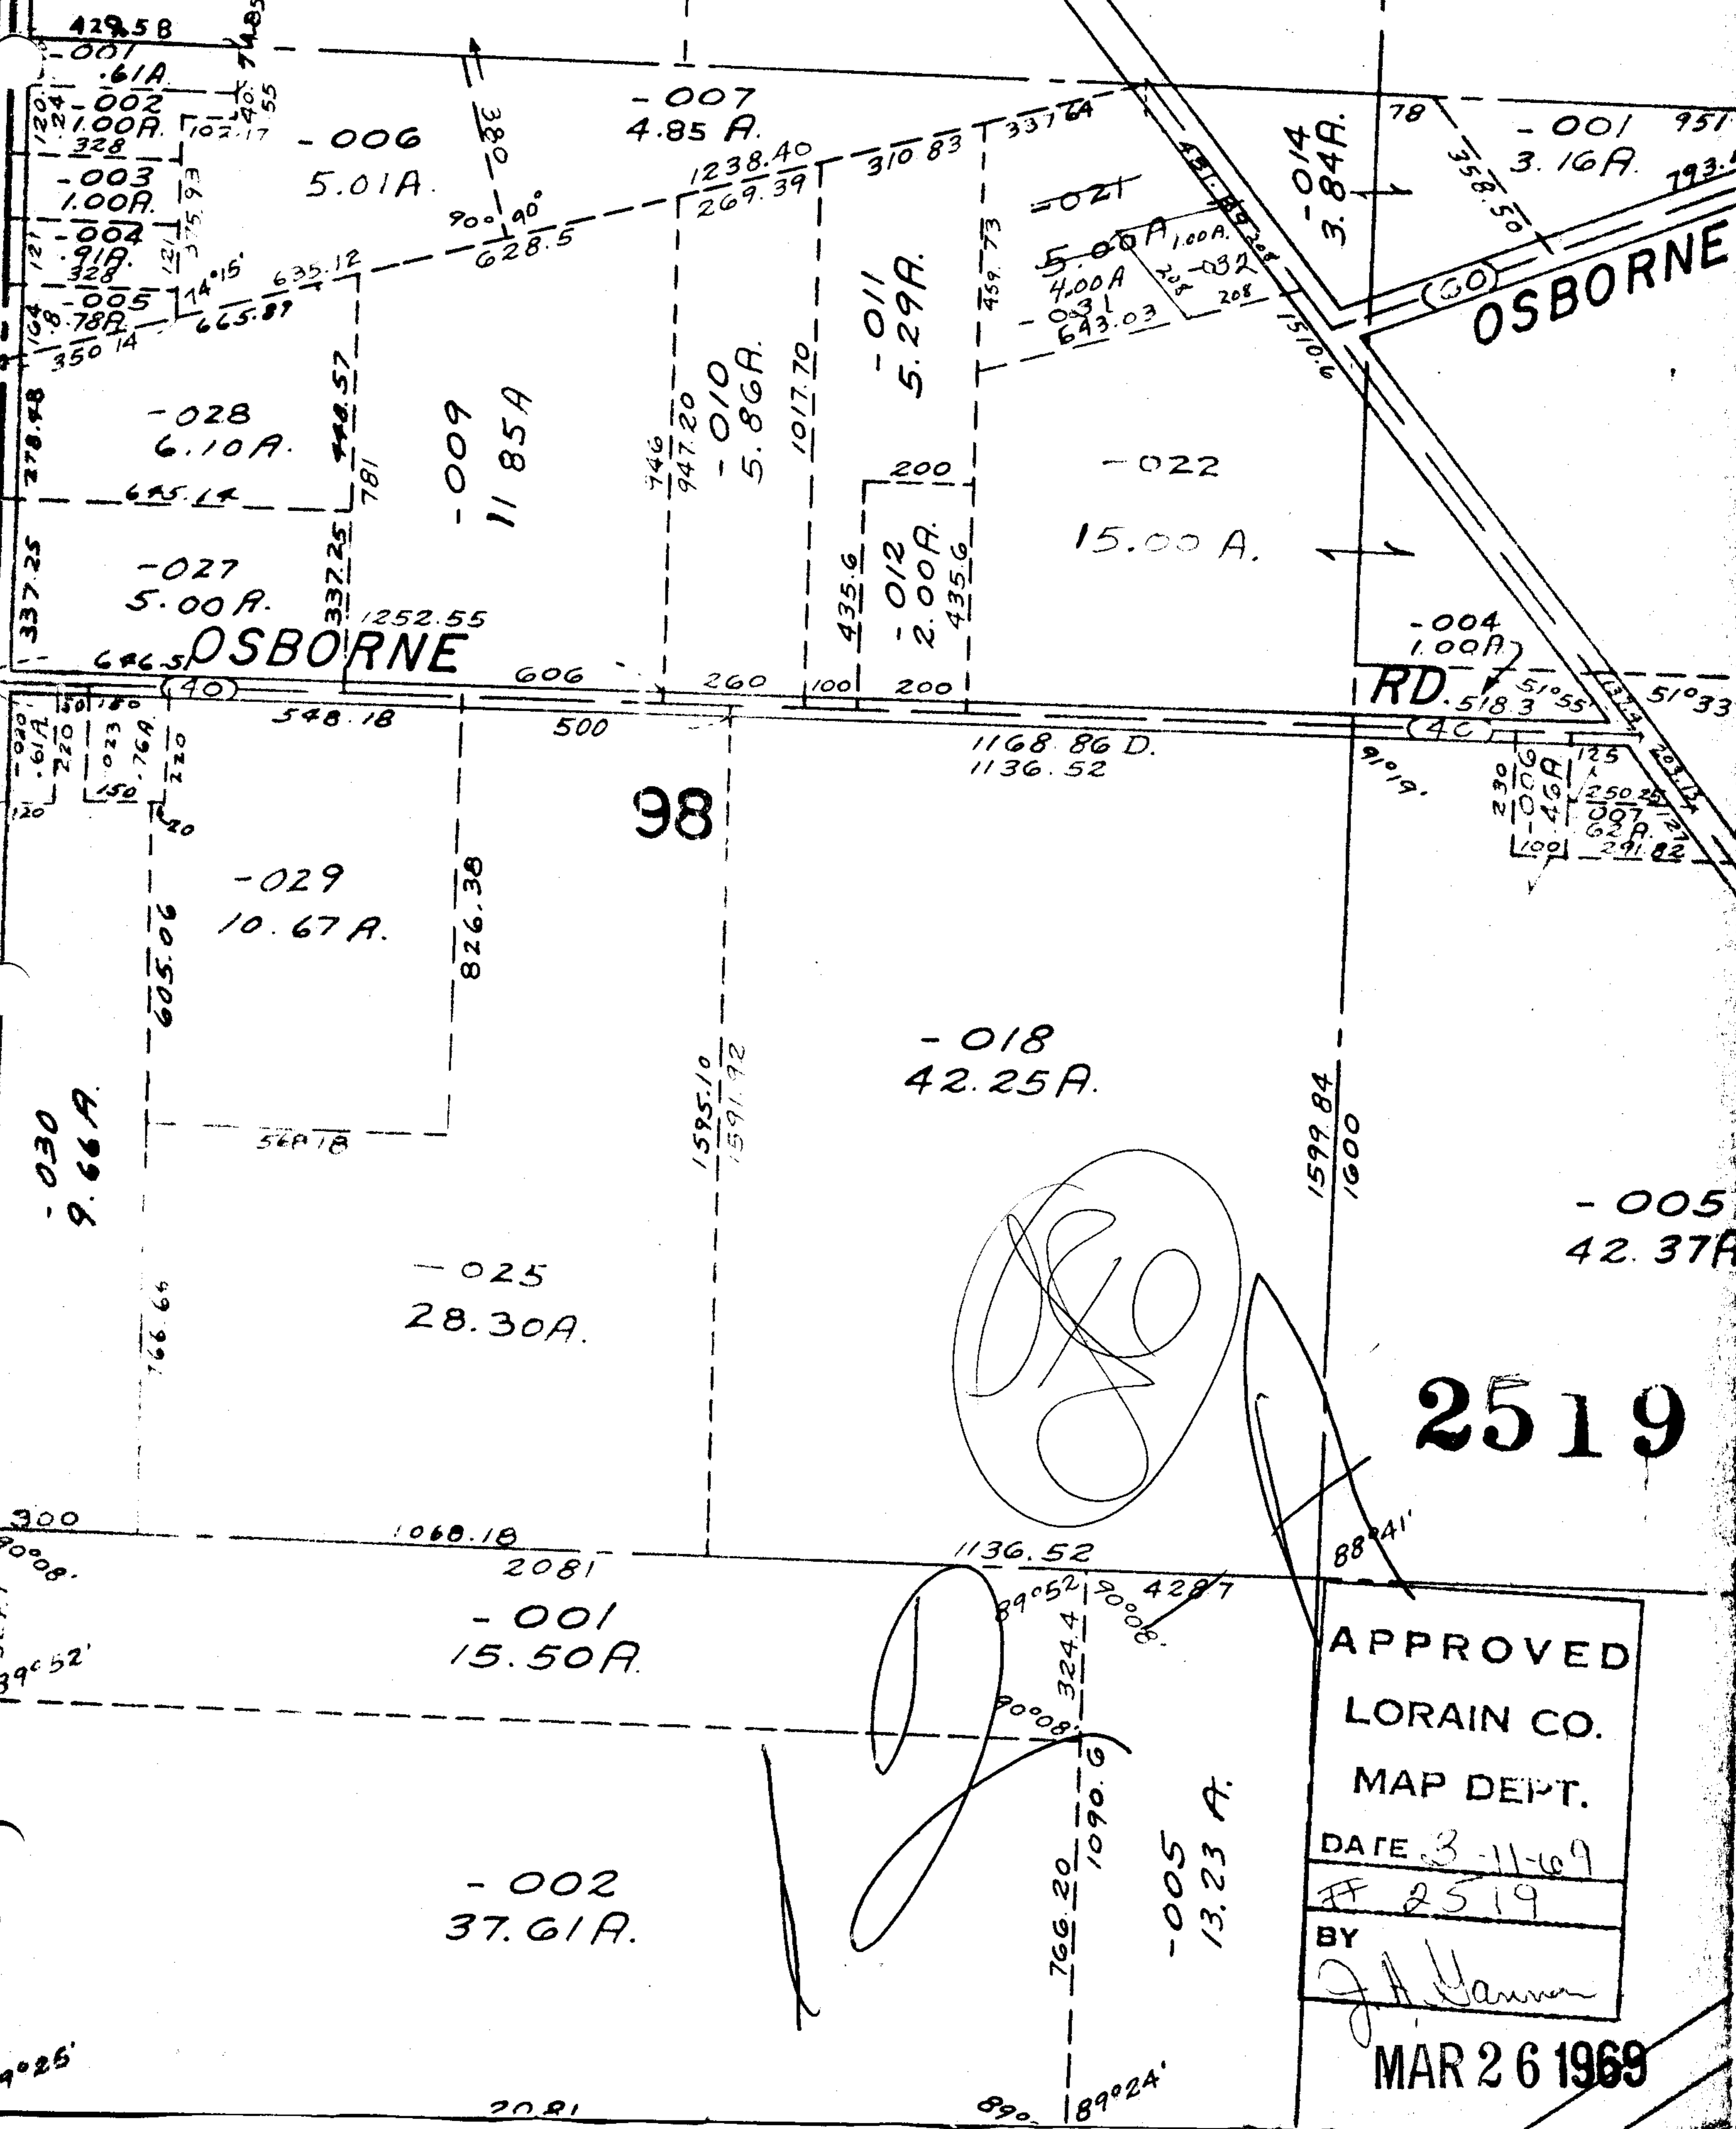

OSBORNE

RD.

98

2519

APPROVED
LORAIN CO.
MAP DEPT.
DATE 3-11-69
2519
BY J.A. Yarrow

MAR 26 1969