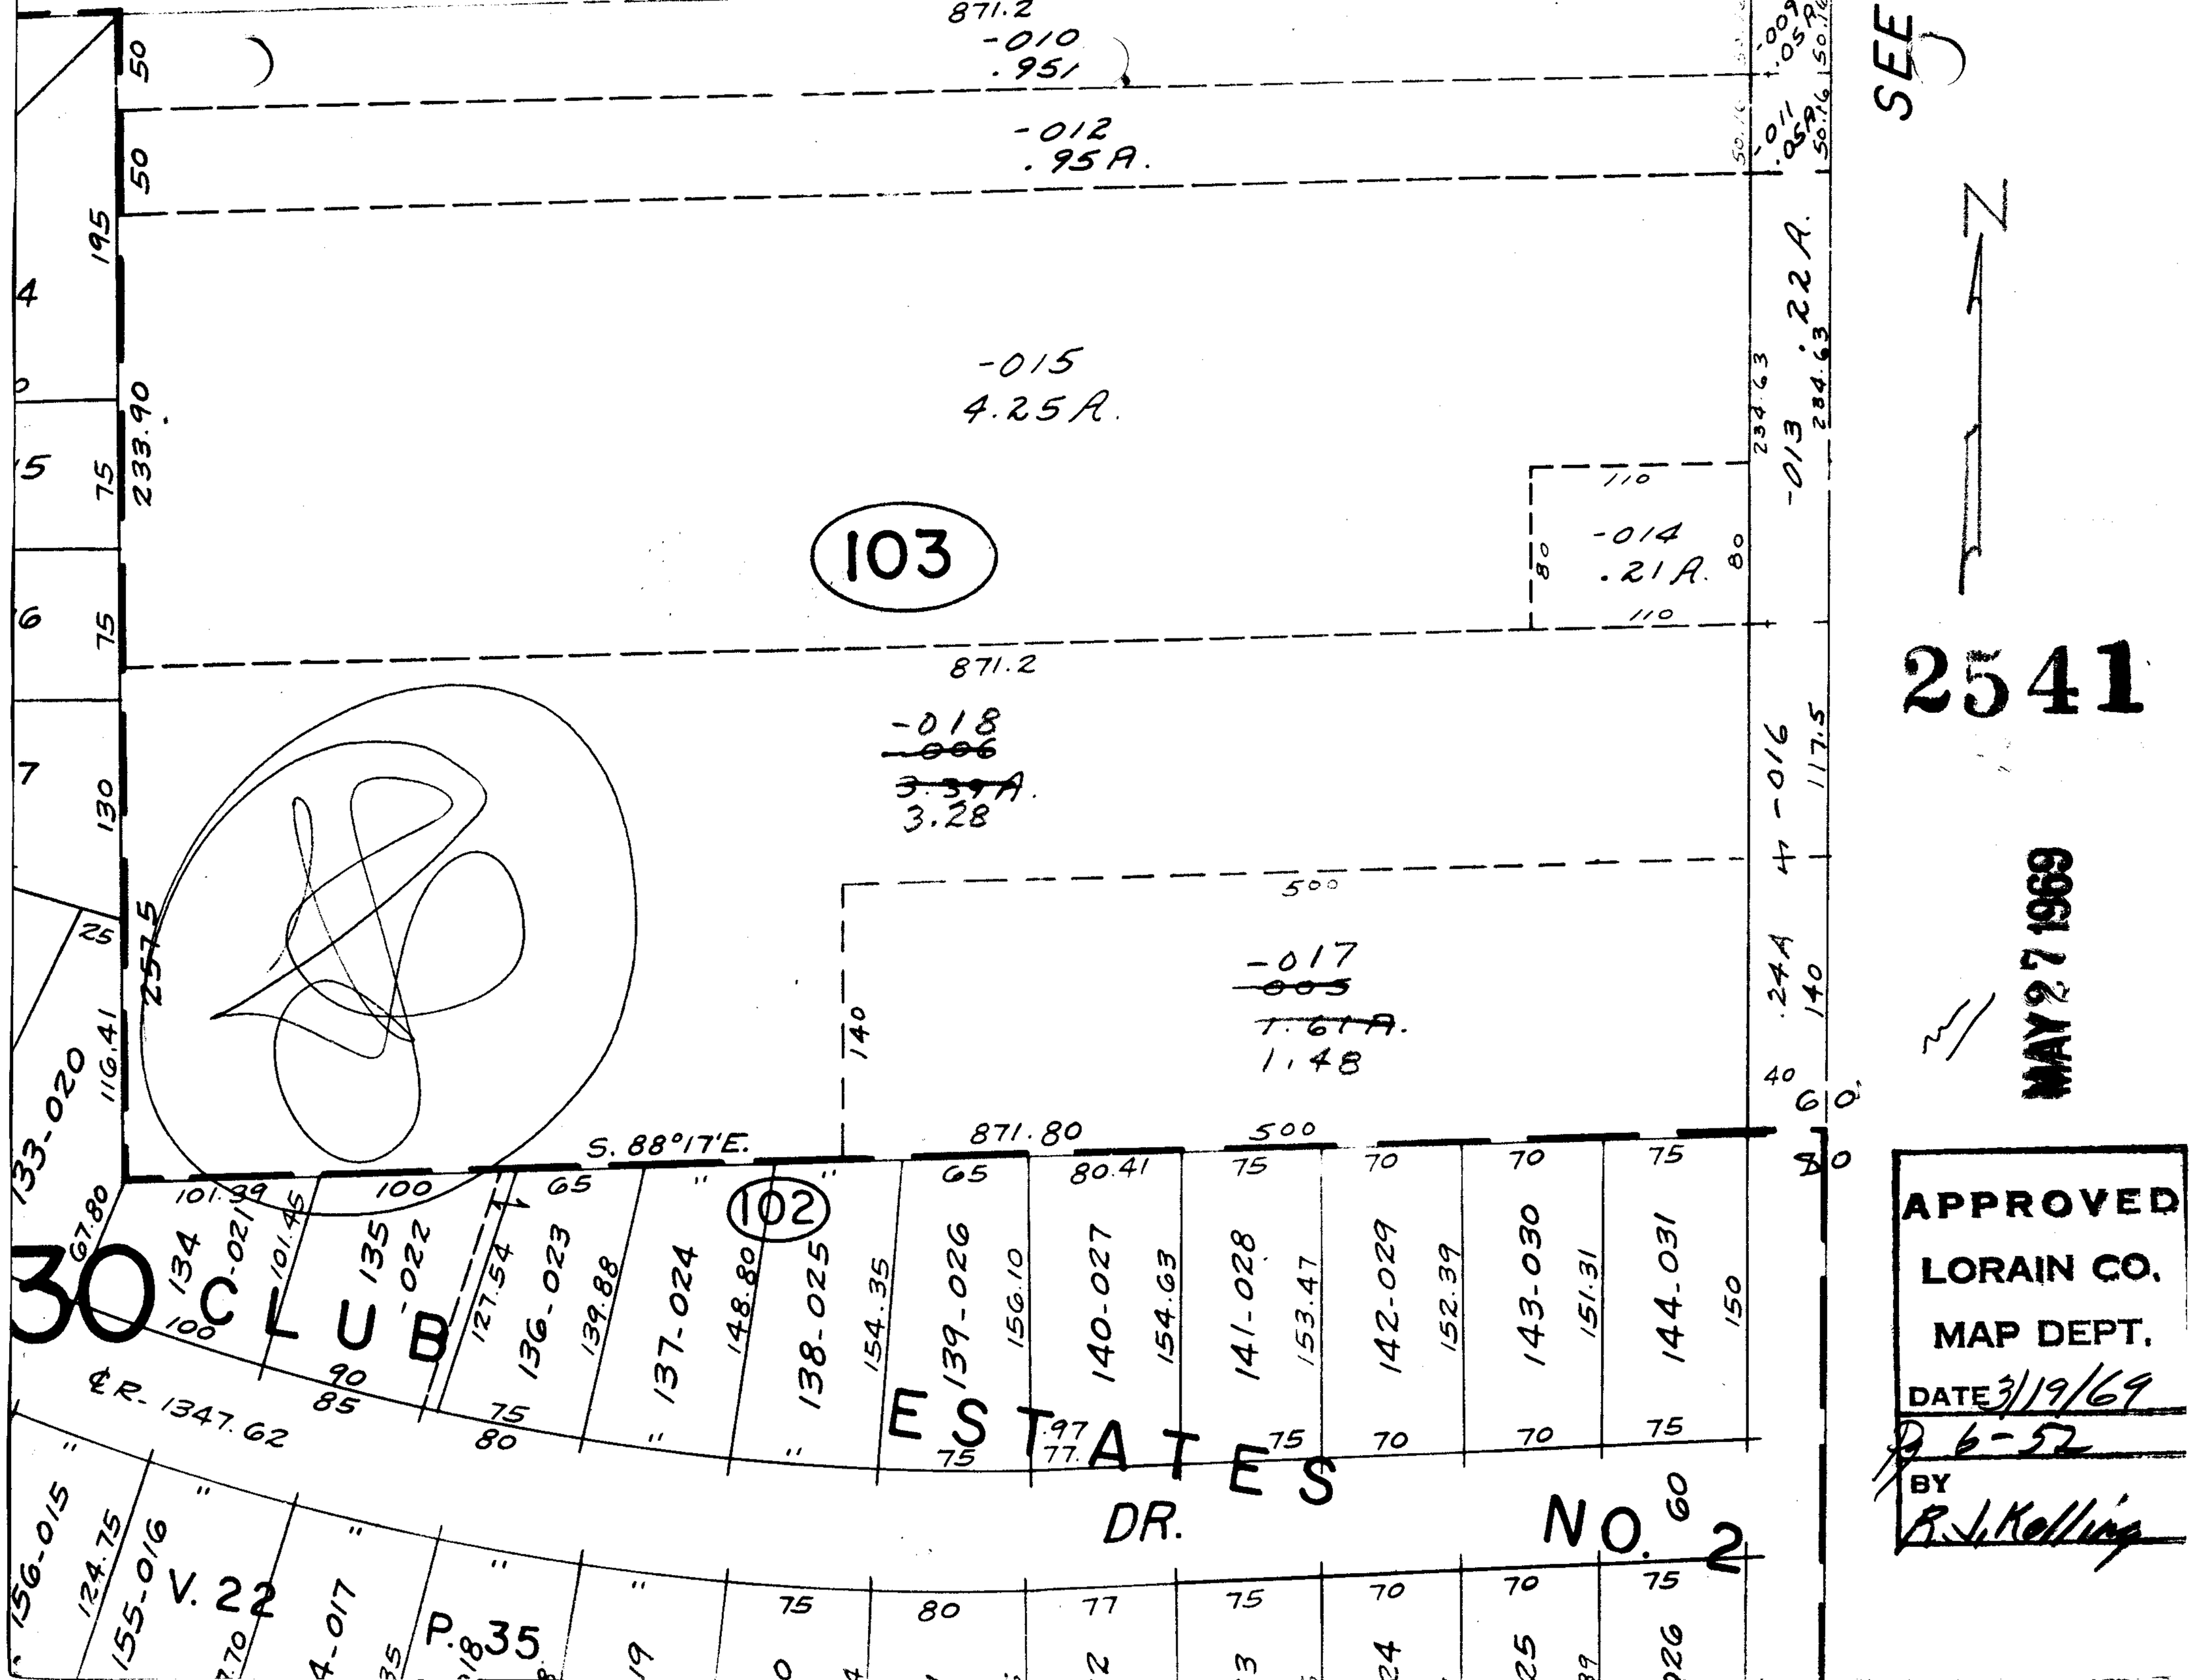

871.2
-010
.951
-012
.95A.
-015
4.25A.
103
-014
.21A.
871.2
-018
~~.006~~
~~3.39A.~~
3.28
-017
~~.005~~
~~1.61A.~~
1.48
S. 88°17'E.
871.80
500
102
30 CLUB ESTATES
DR.
NO. 2
V. 22
P. 35
℄ R. 1347.62
SEE
N
2541
MAY 27 1969
APPROVED
LORAIN CO.
MAP DEPT.
DATE 3/19/69
6-52
BY
R. J. Kelling