




008  
50 A. Dup #1  
30 A. Dup #2  
08 A. Dup #3  
88 A. Total  
185

007

006

101°50'

254

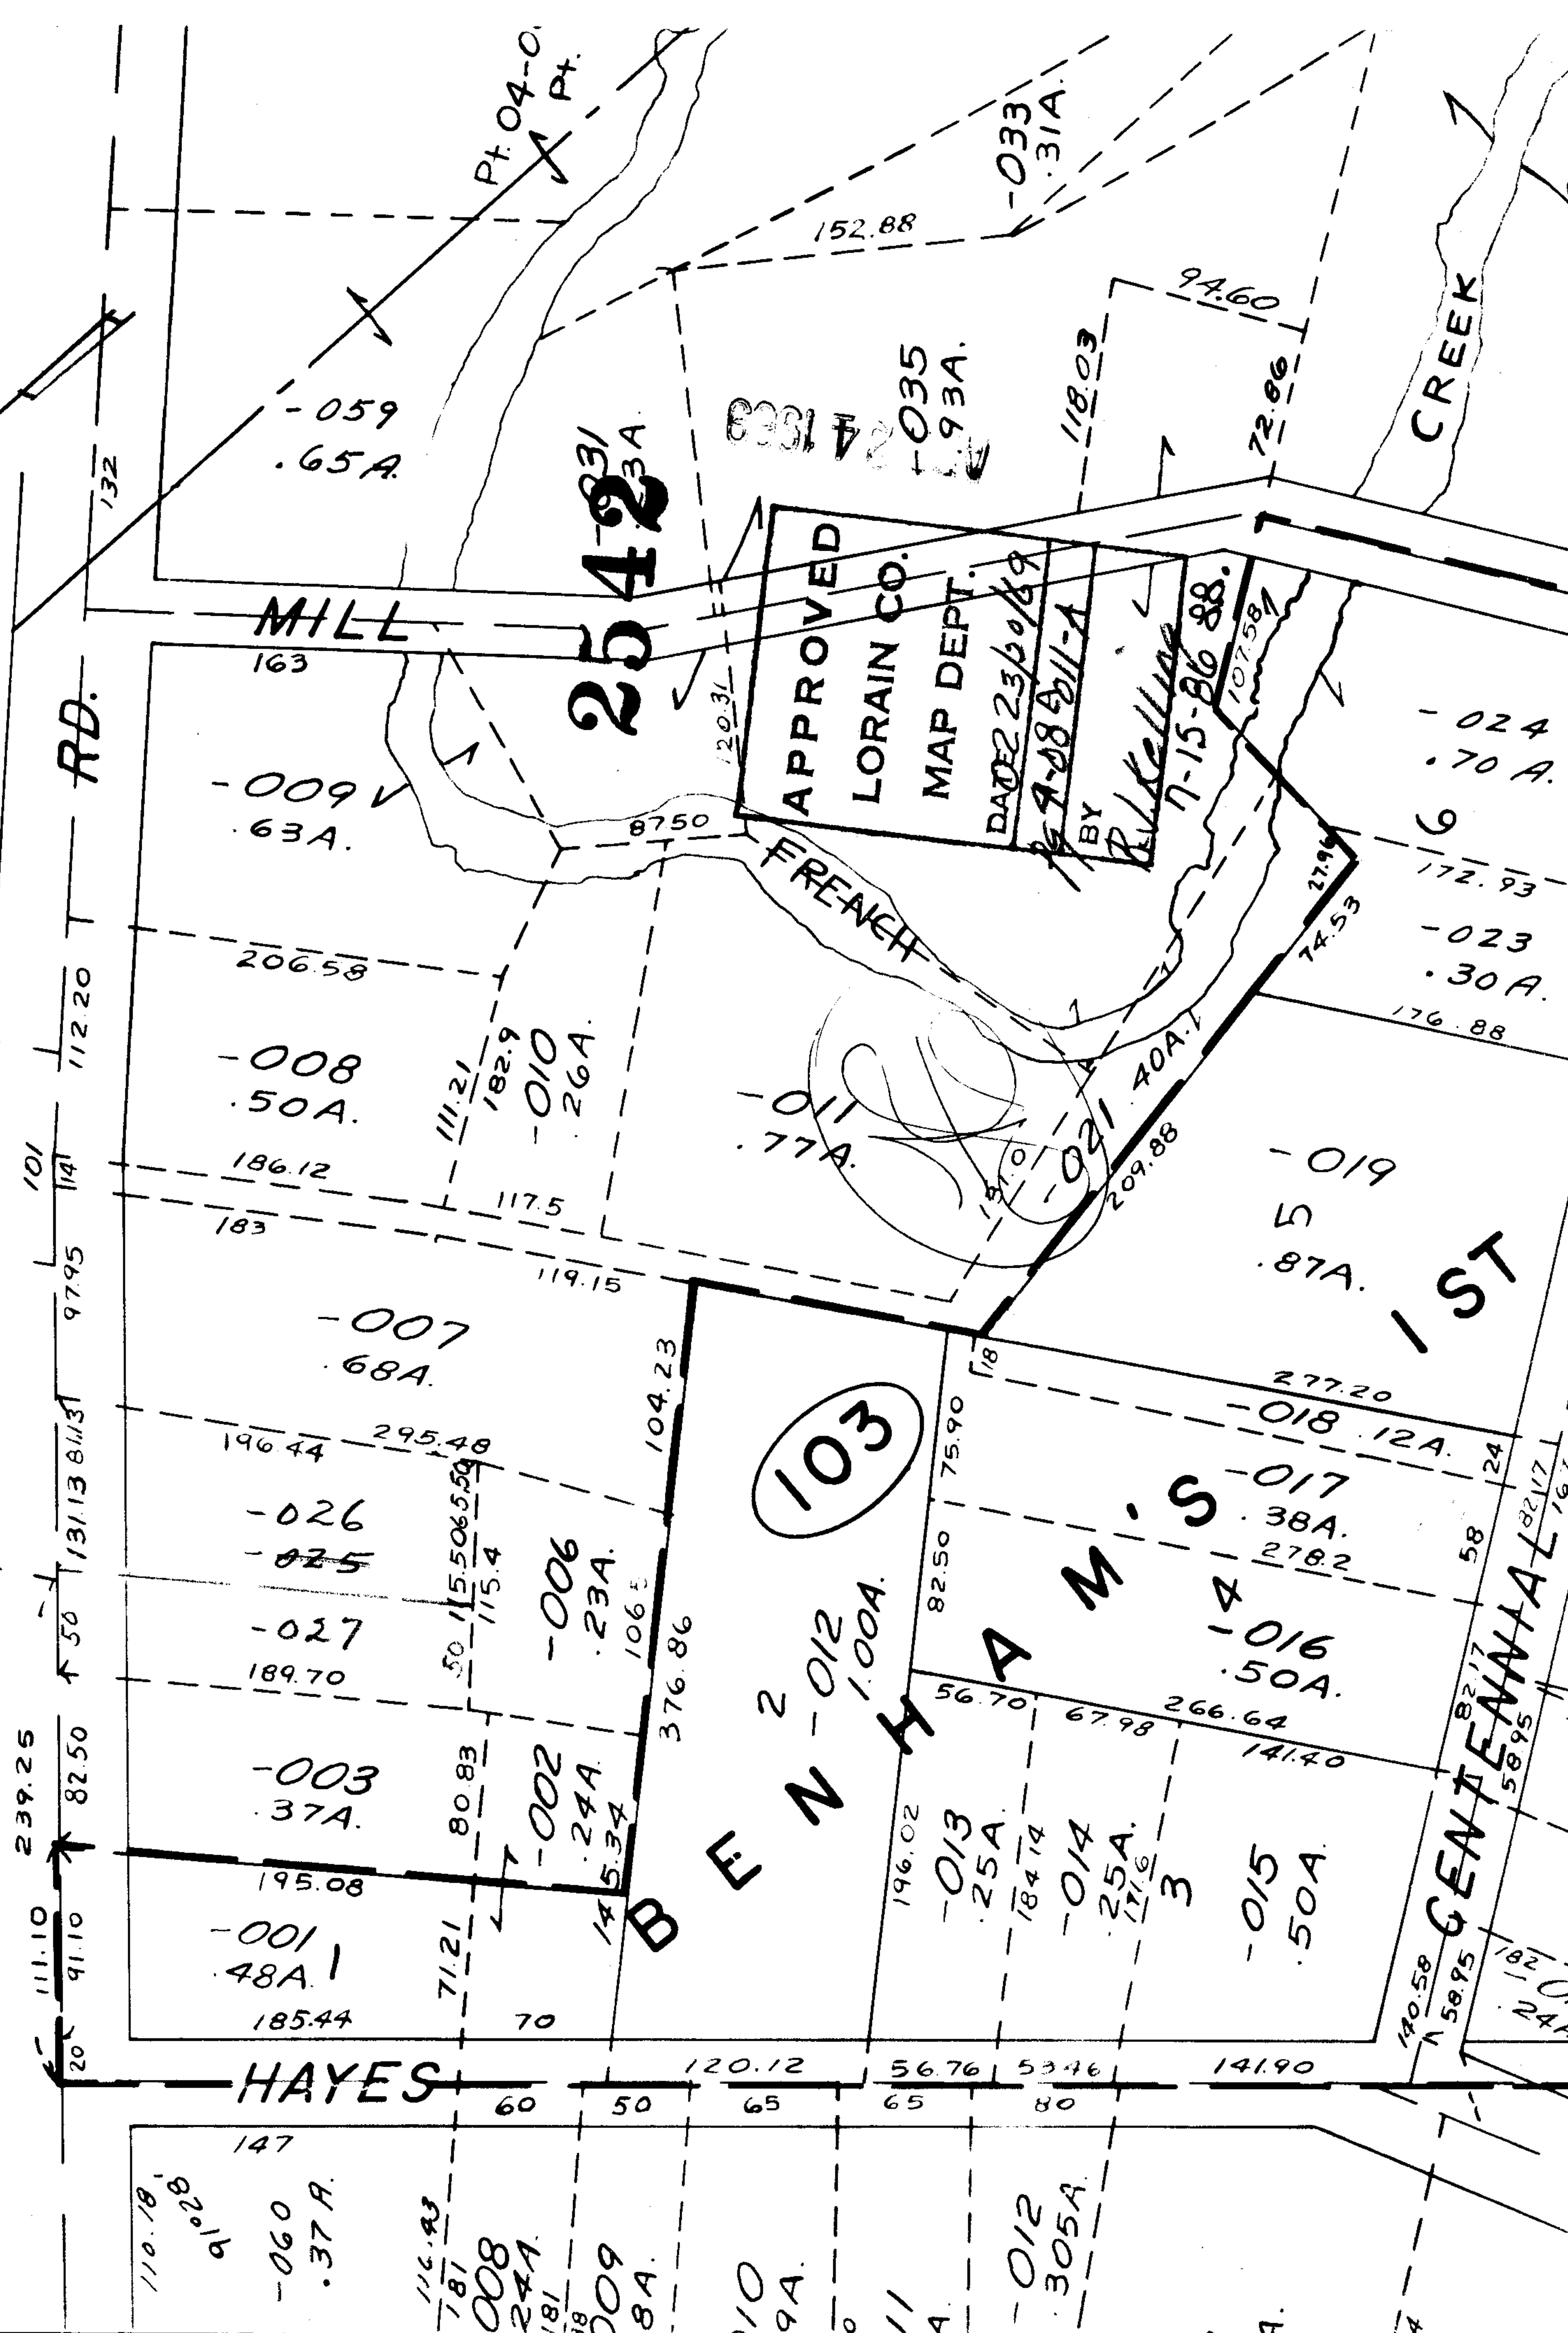

RD.

MILL

254231  
23A

APPROVED  
LORAIN CO.  
MAP DEPT.  
DATE 2/3/60/69  
BY [Signature]

FRENCH

CREEK

103

2-012  
1.00A.

HAYES

HAYES

ST

