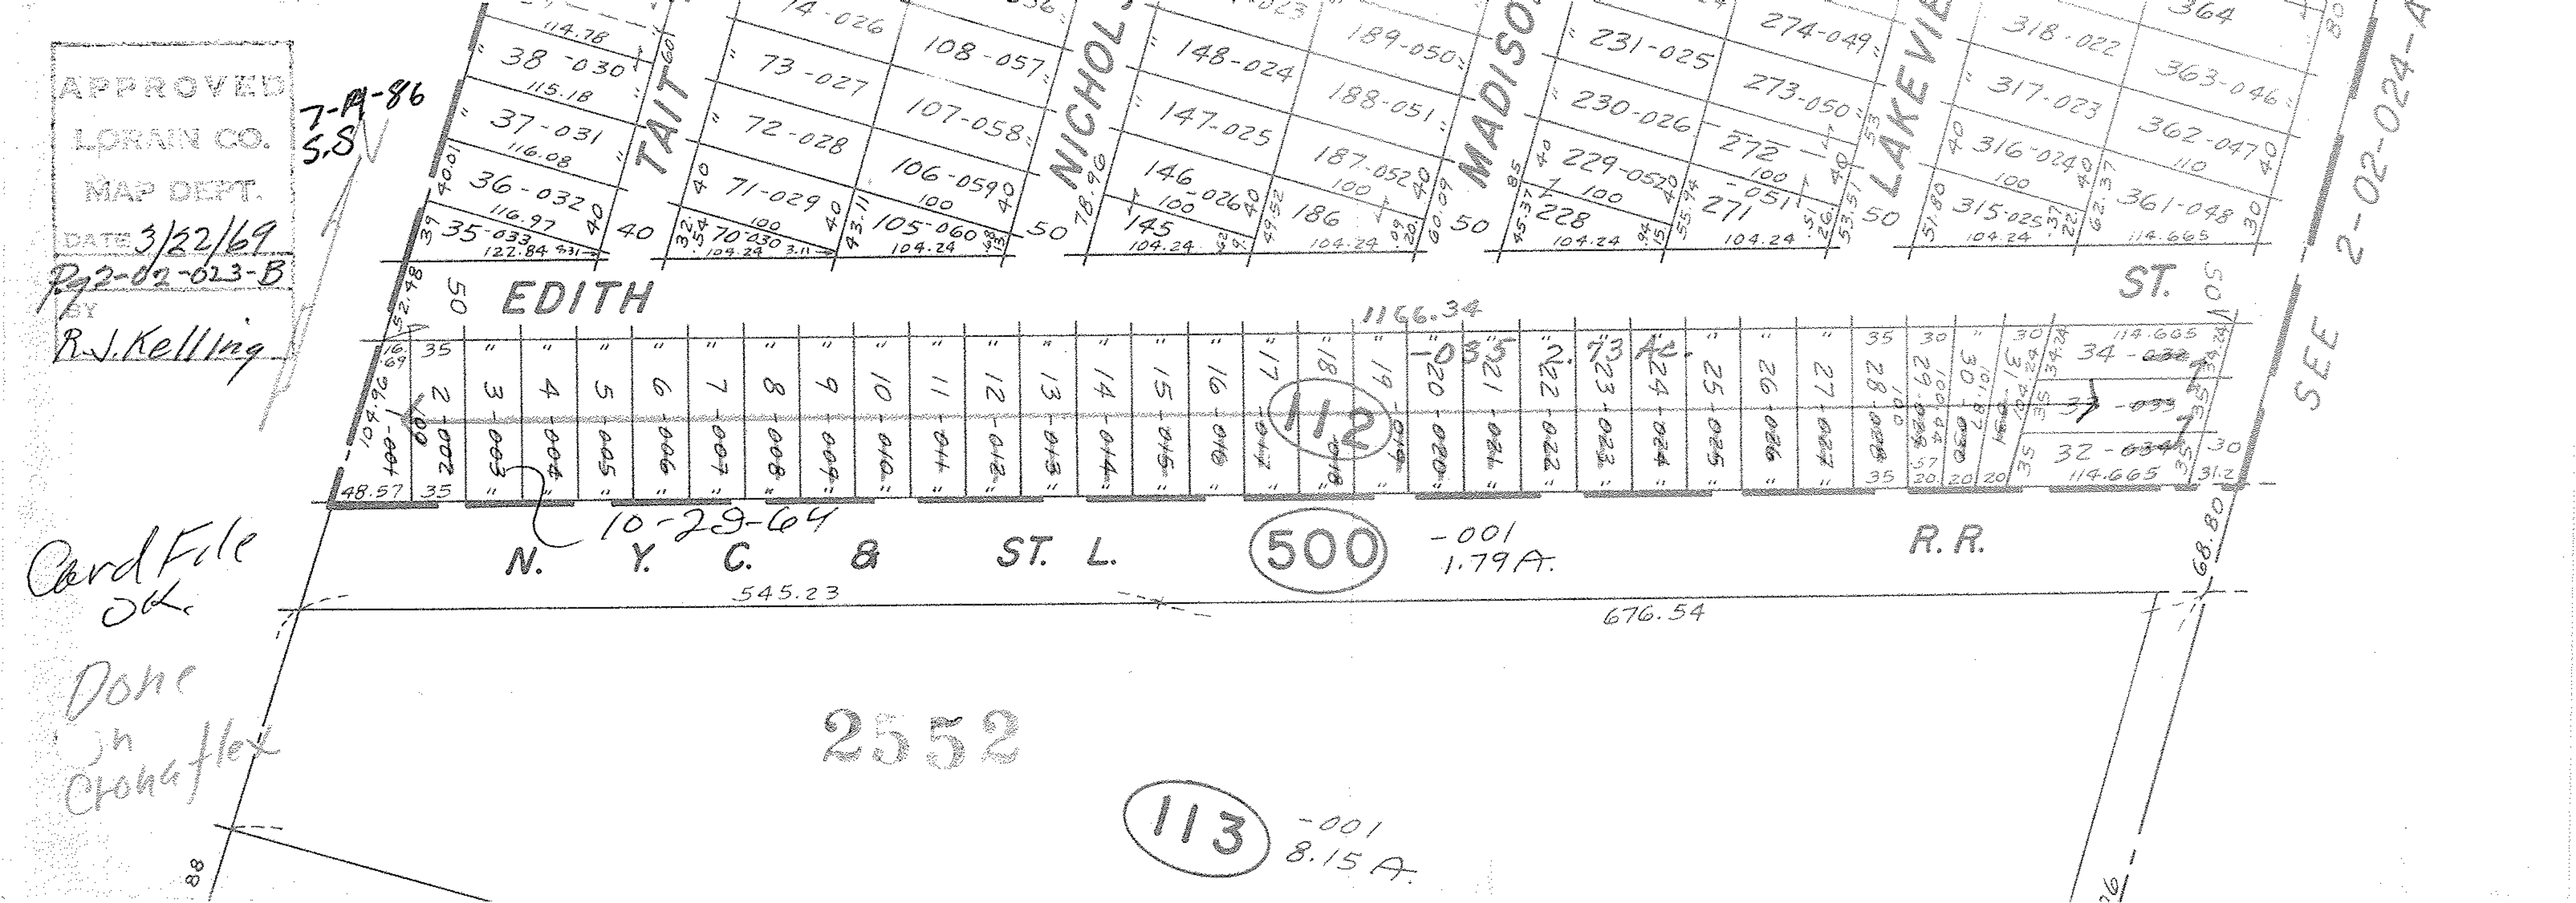
APPROVED
LORAIN CO.
MAP DEPT.
DATE 3/22/69
By R.J. Kelling
7-19-86
S.S.
TAIT
NICHOLS
MADISON
LAKEVIEW
EDITH
ST.
SEE 2-02-024-A
1166.34
545.23
676.54
68.80
N. Y. C. & ST. L. R.R.
500
-001
1.79A.
112
113
-001
8.15A.
2552
10-29-64
Card File OK.
Done on Chonaflex