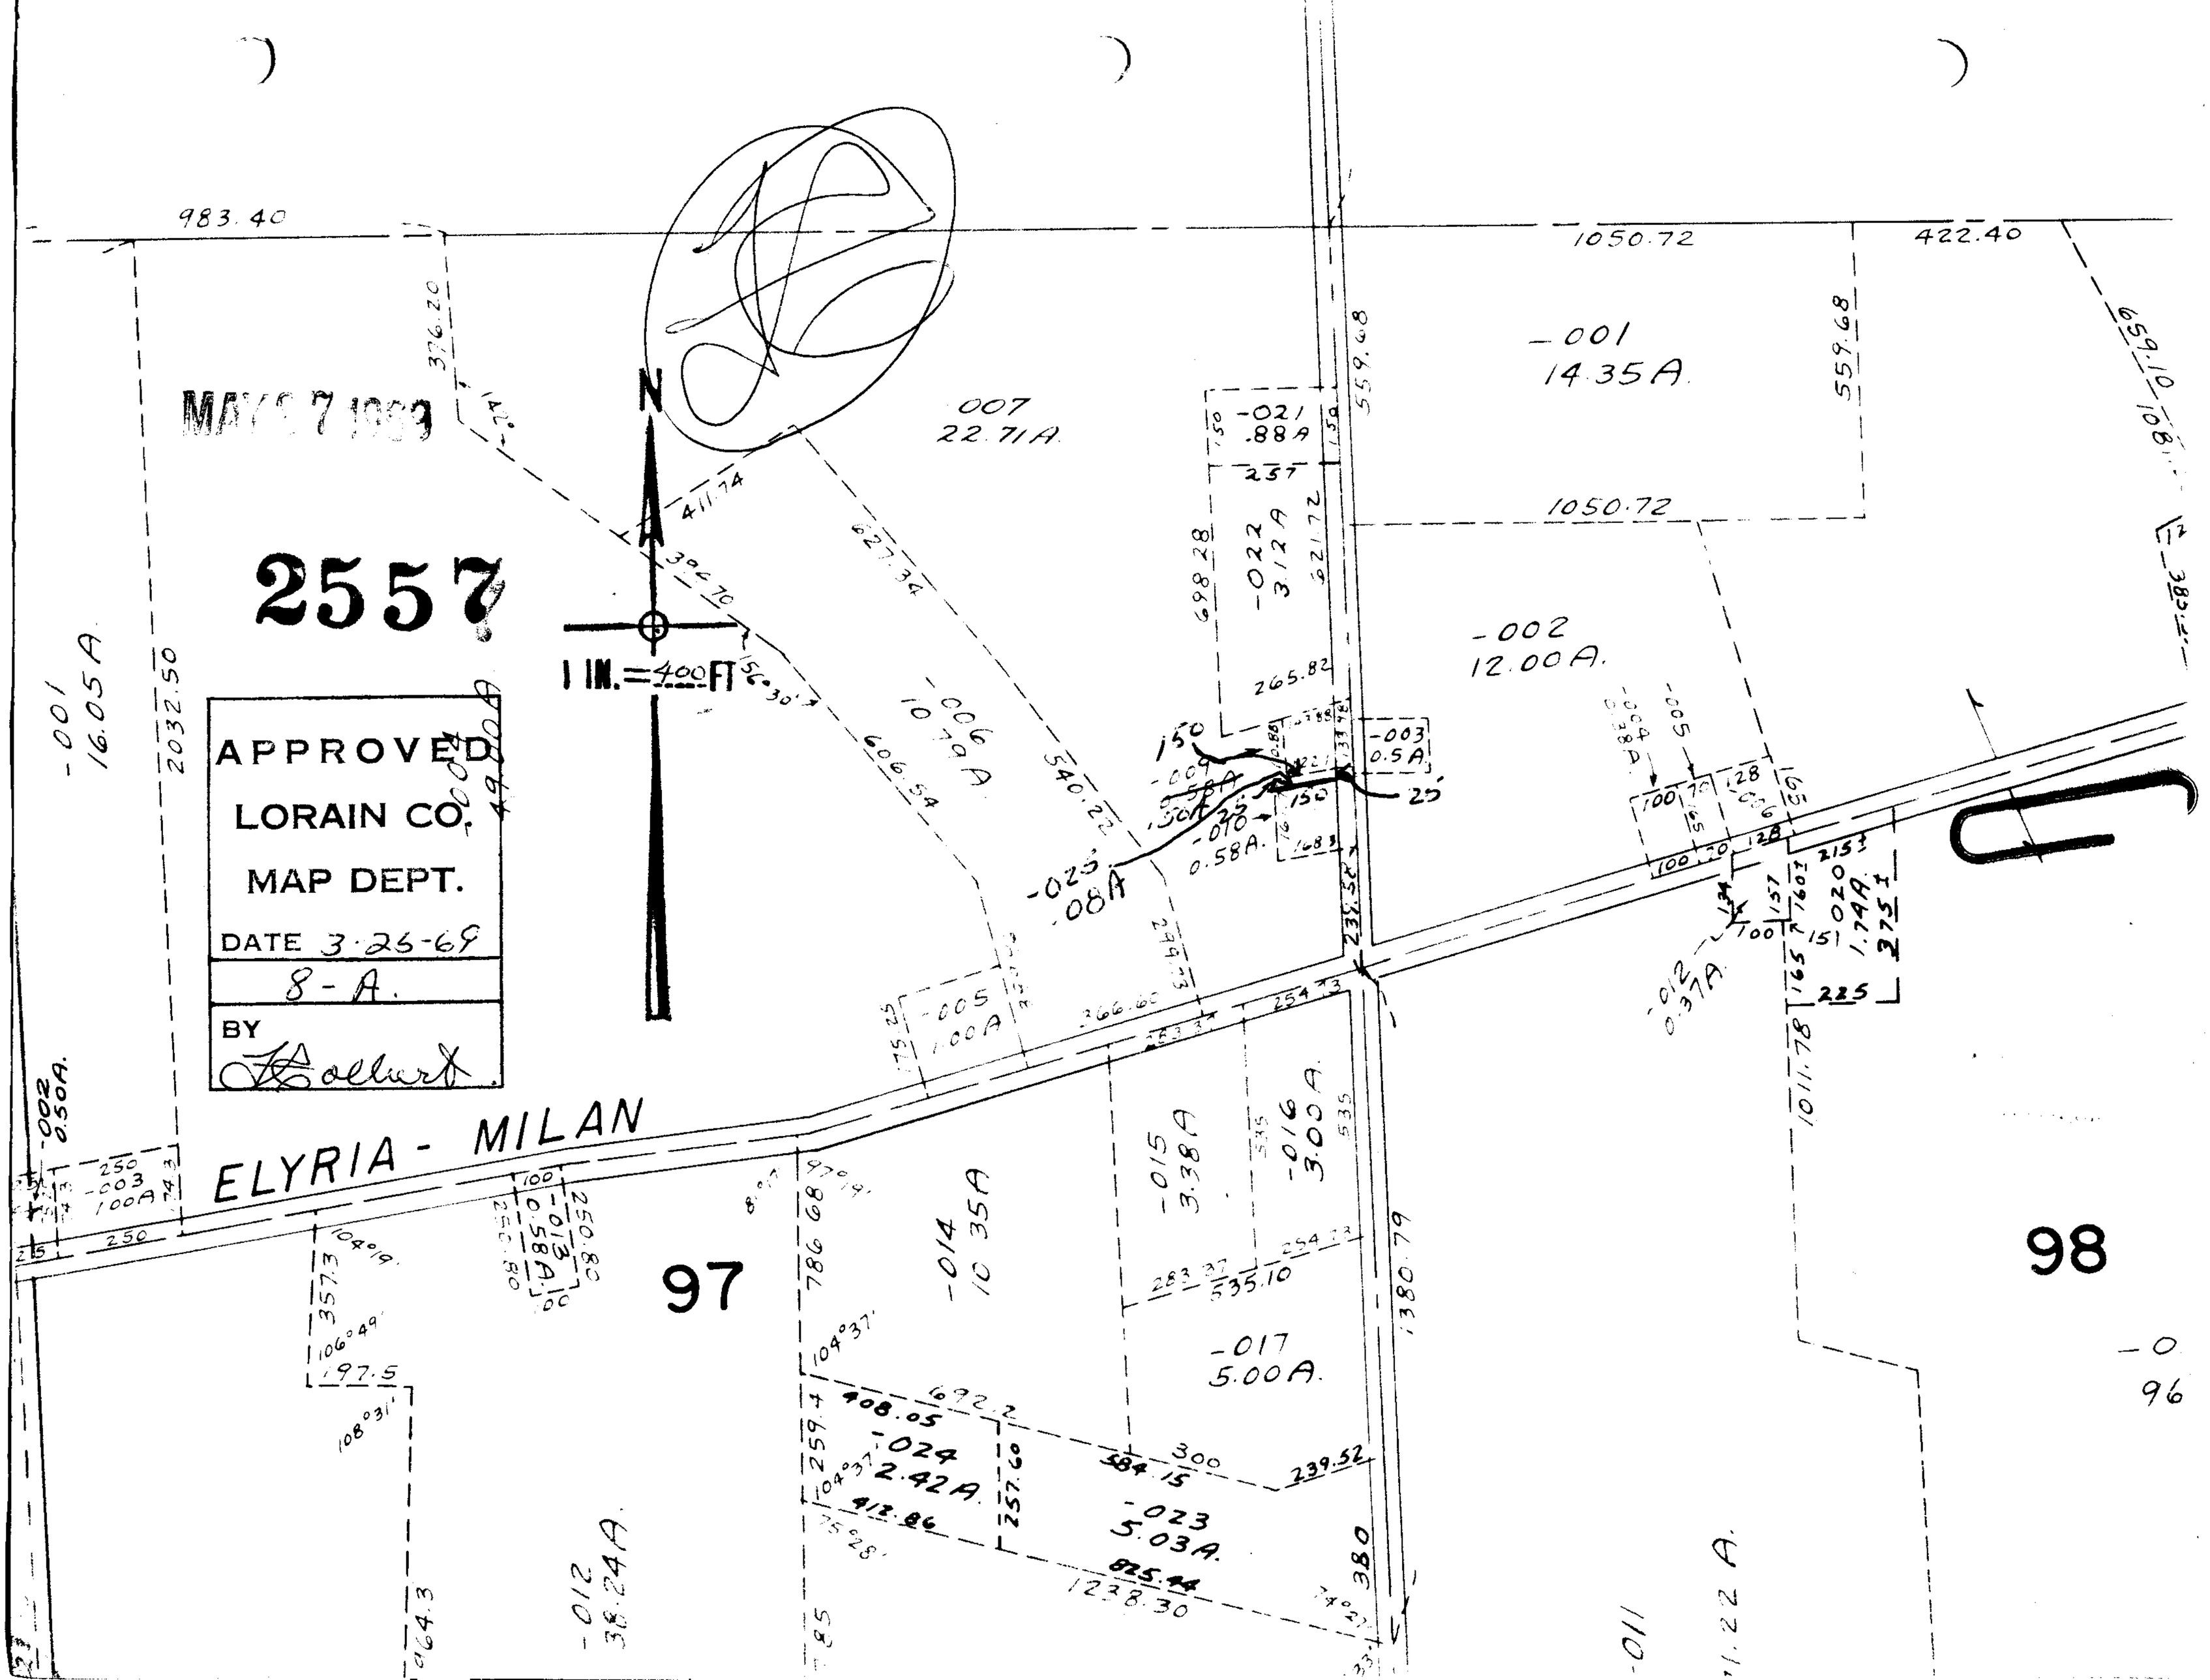

2557
APPROVED
LORAIN CO.
MAP DEPT.
DATE 3-25-69
8-A.
BY
1 IN.=400 FT
N
ELYRIA - MILAN
97
98
-001
14.35A.
-002
12.00A.
-007
22.71A.
-006
10.79A.
-014
10.35A
-015
3.38A
-016
3.00A.
-017
5.00A.
-023
5.03A.
-024
2.42A.
-012
38.24A.
-001
16.05A
-002
0.50A.
-003
1.00A
-005
1.00A
-012
0.37A.
-021
.88A
-022
3.12A
-003
0.5A.
-025
.08A
-010
0.58A.
-013
0.58A.
-011
1.22 A.
983.40
1050.72
422.40
1380.79
1238.30