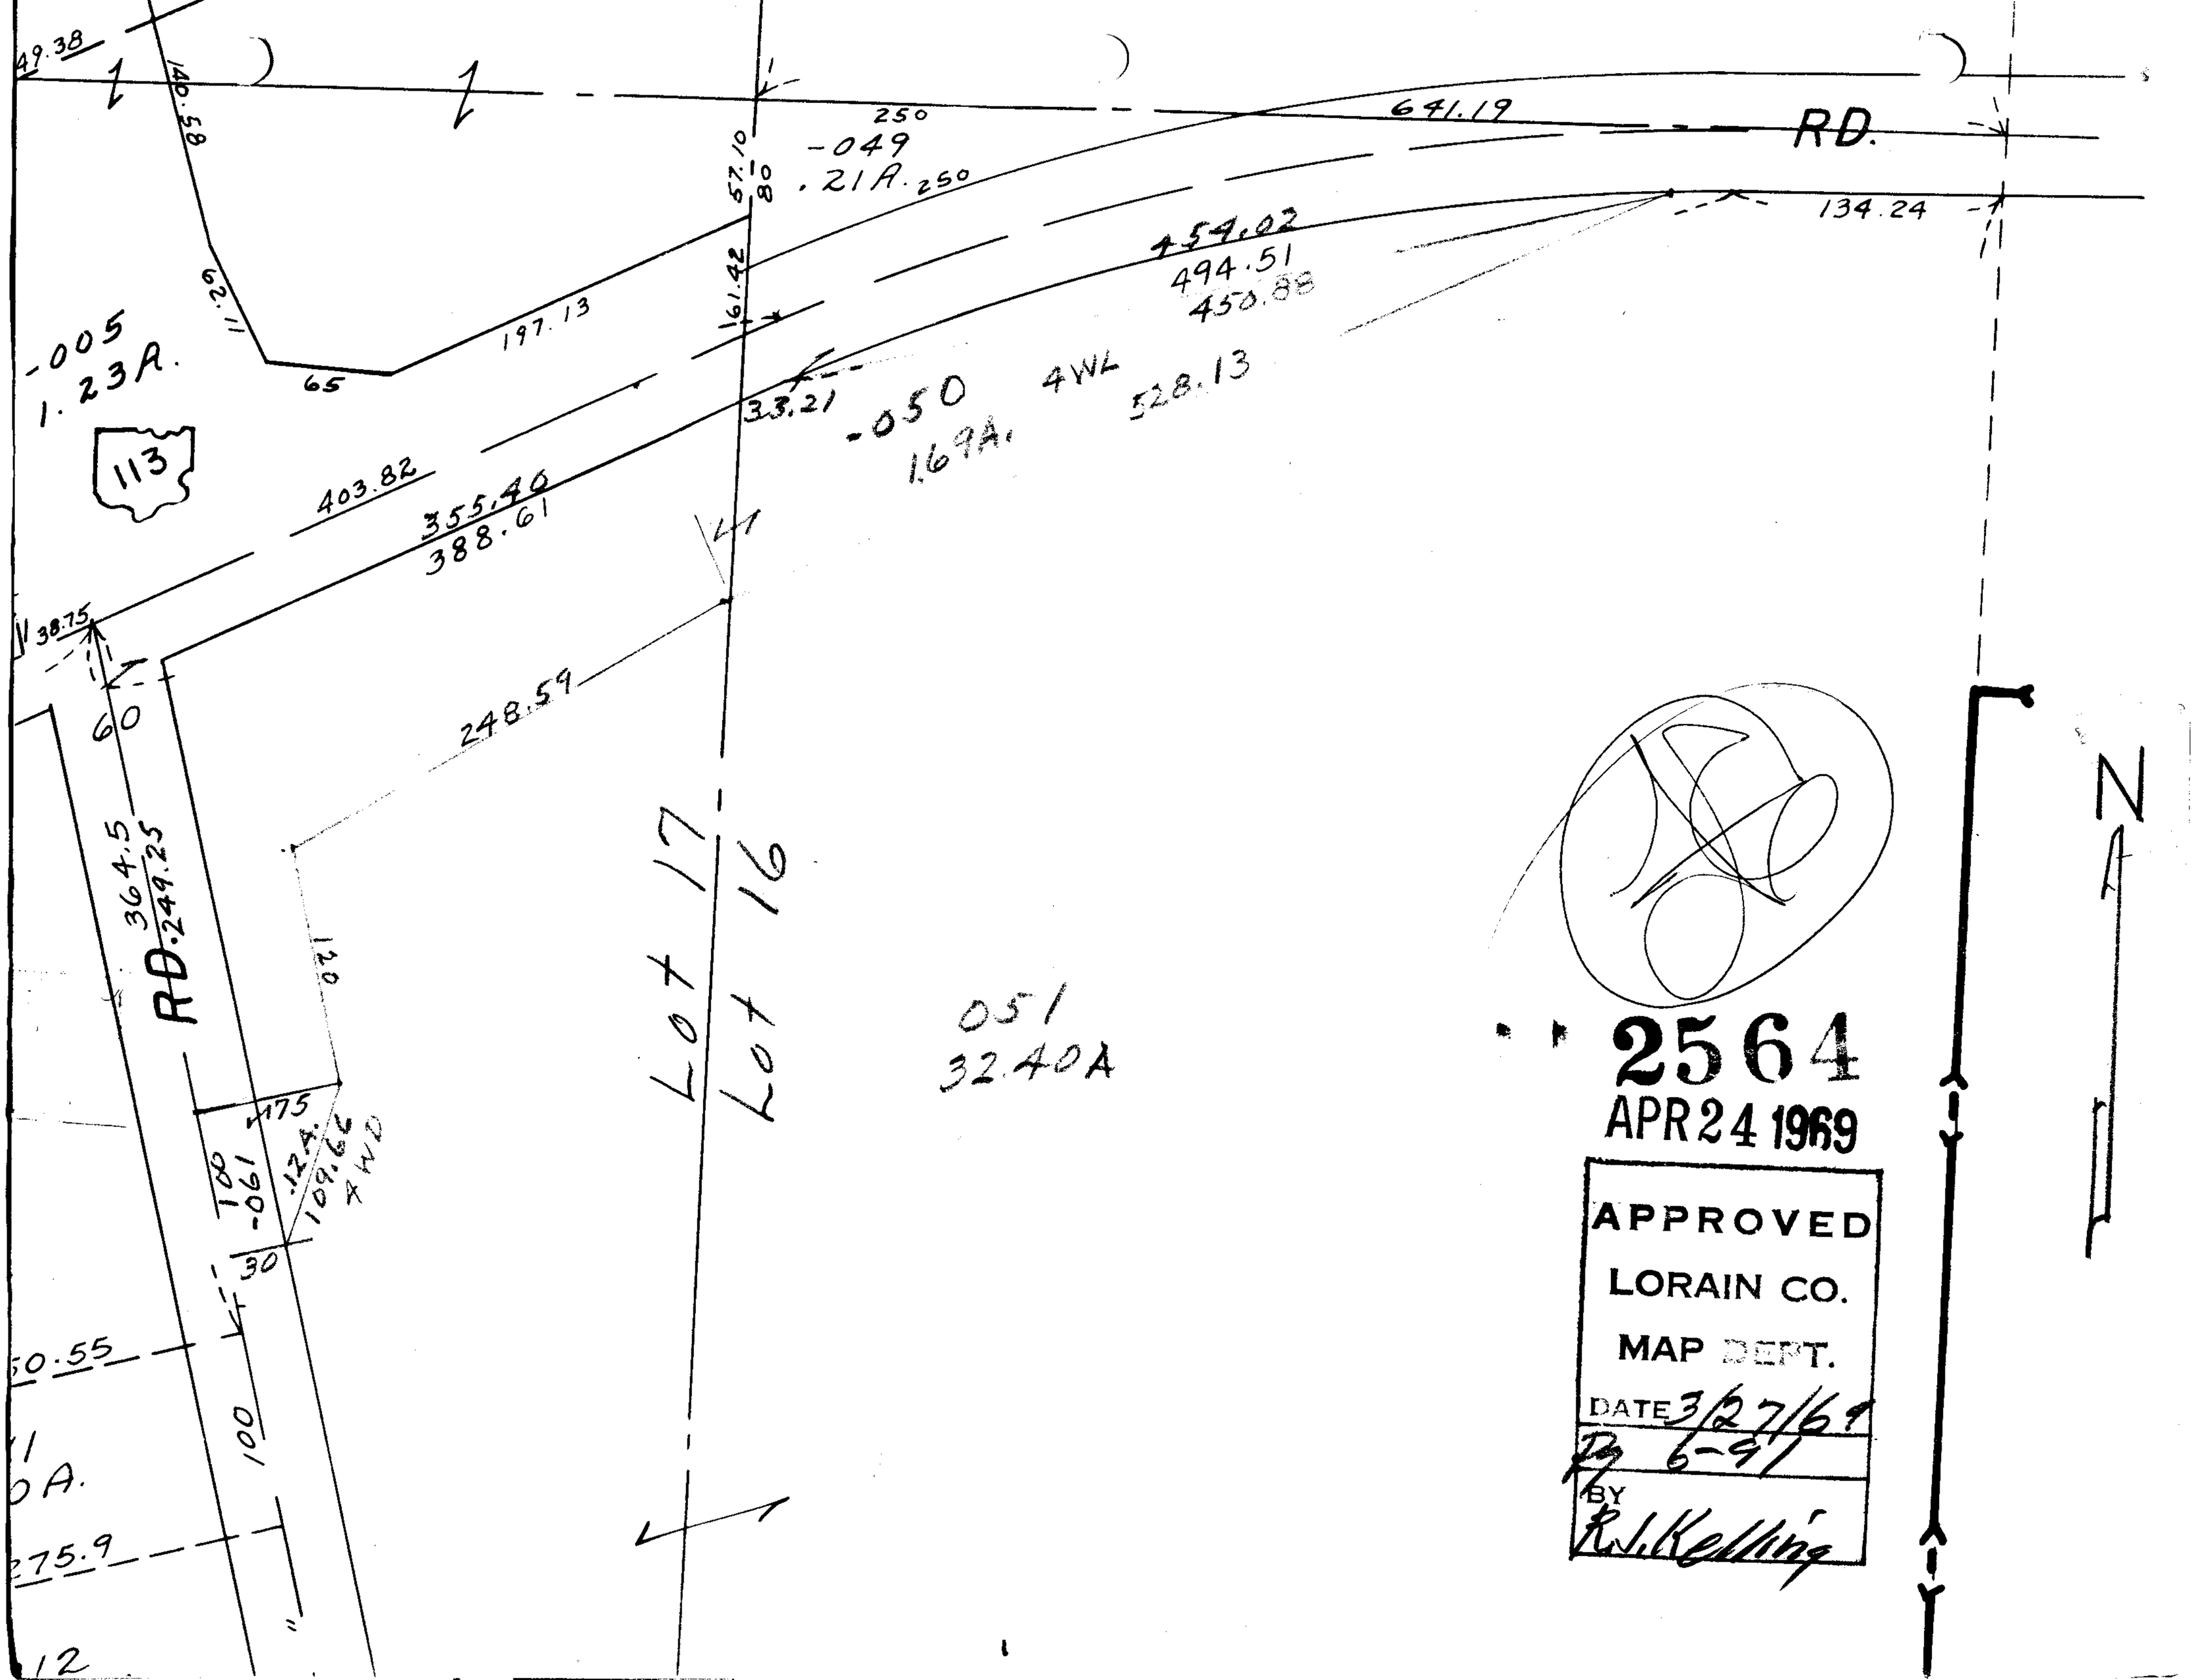

2564
APR 24 1969

APPROVED
LORAIN CO.
MAP DEPT.
DATE 3/27/69
By 6-91
BY
R.J. Kelling