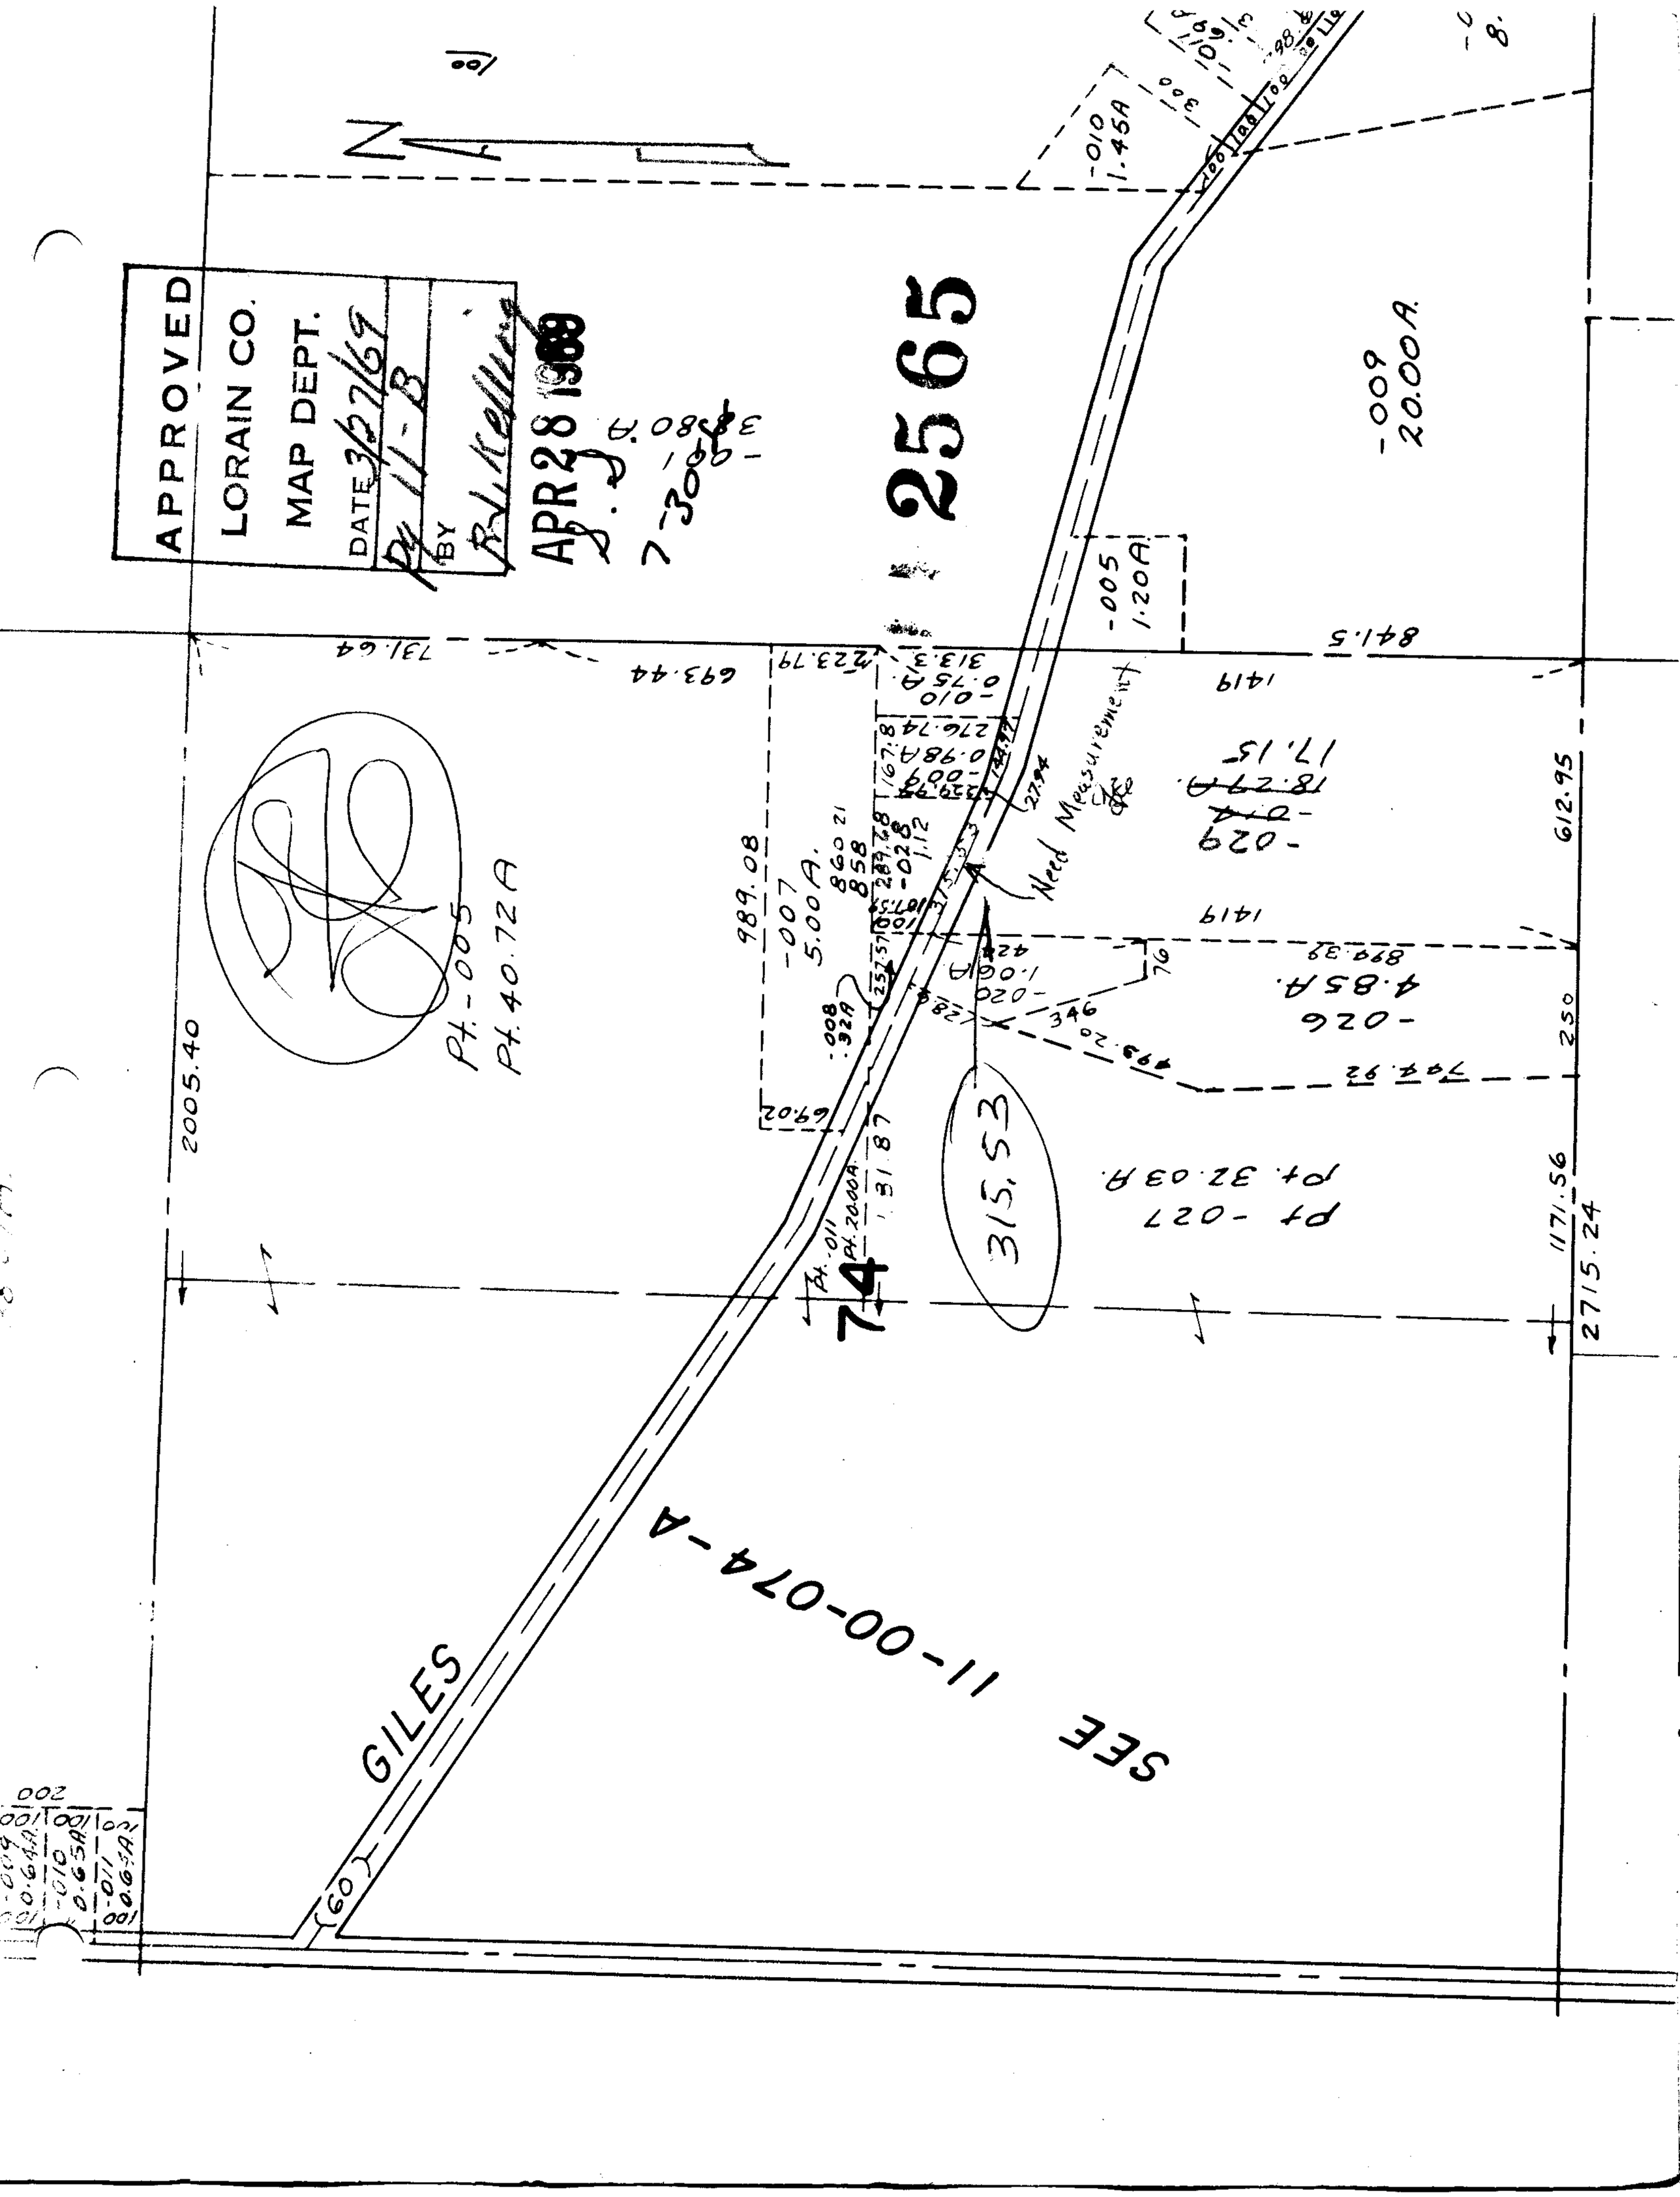
APPROVED
LORAIN CO.
MAP DEPT.
DATE 3/27/69
BY
APR 28 1969
25
7-30
-010
1.45A
-009
20.00A.
-005
1.20A.
841.5
731.64
693.44
223.79
-010
0.75A.
313.3
276.74
0.98A
-009
-007
5.00A.
989.08
Need Measurement
-029
17.15
18.27A.
612.95
1419
-026
4.85A.
894.39
744.92
Pt.-005
Pt. 40.72A
2005.40
69.02
315.53
Pt -027
Pt. 32.03A.
1171.56
2715.24
74
Pt.-011
Pt. 20.00A.
31.87
SEE 11-00-074-A
GILES
60
-009
0.64A.
-010
0.65A.
-011
0.65A.
200