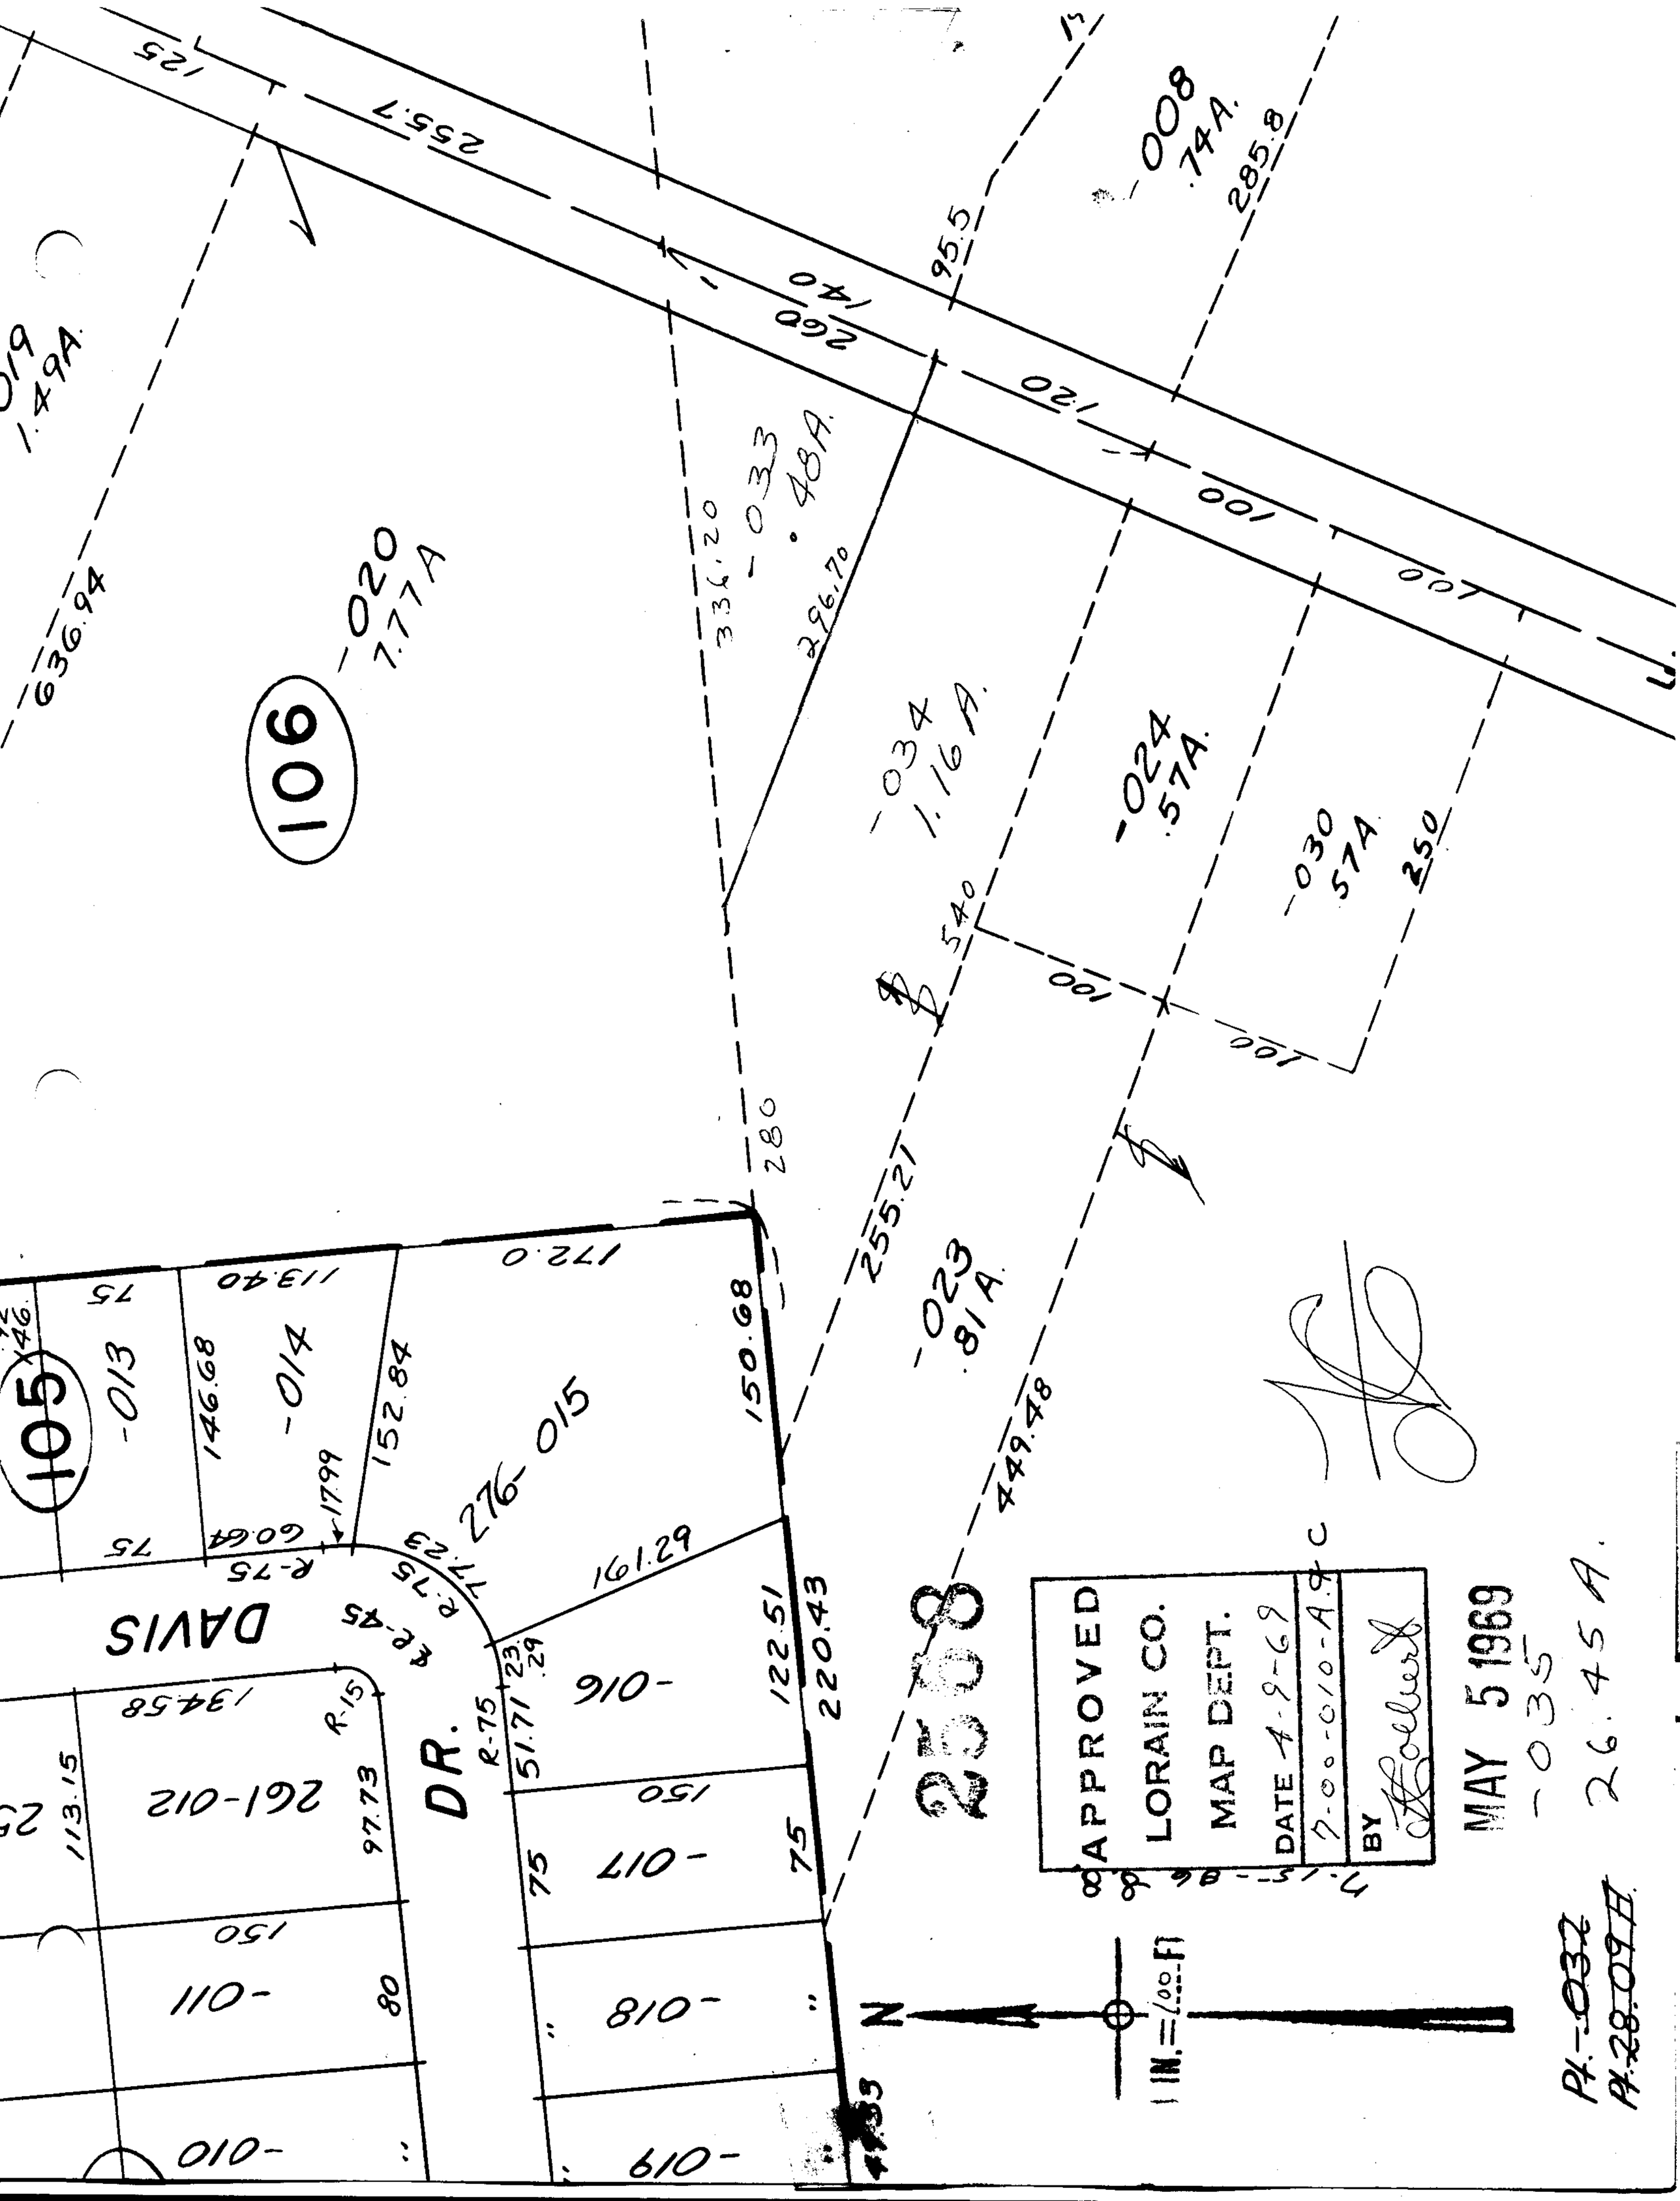

APPROVED
LORAIN CO.
MAP DEPT.
DATE 4-9-69
7-00-010-A.9
BY
MAY 5 1969
-035
26.45 A.
Pt.-032
Pt.28.09 A.
DAVIS
DR.
106
105
276-015
261-012
-020
7.77 A
-034
1.16 A.
-024
.57 A.
-030
.57 A
-033
.48 A.
-023
.81 A.
-008
.74 A.
-019
1.49 A.
-013
-014
-010
-110
-210
-910
-010
-110
-810
-610
1 IN. = 100 FT
N