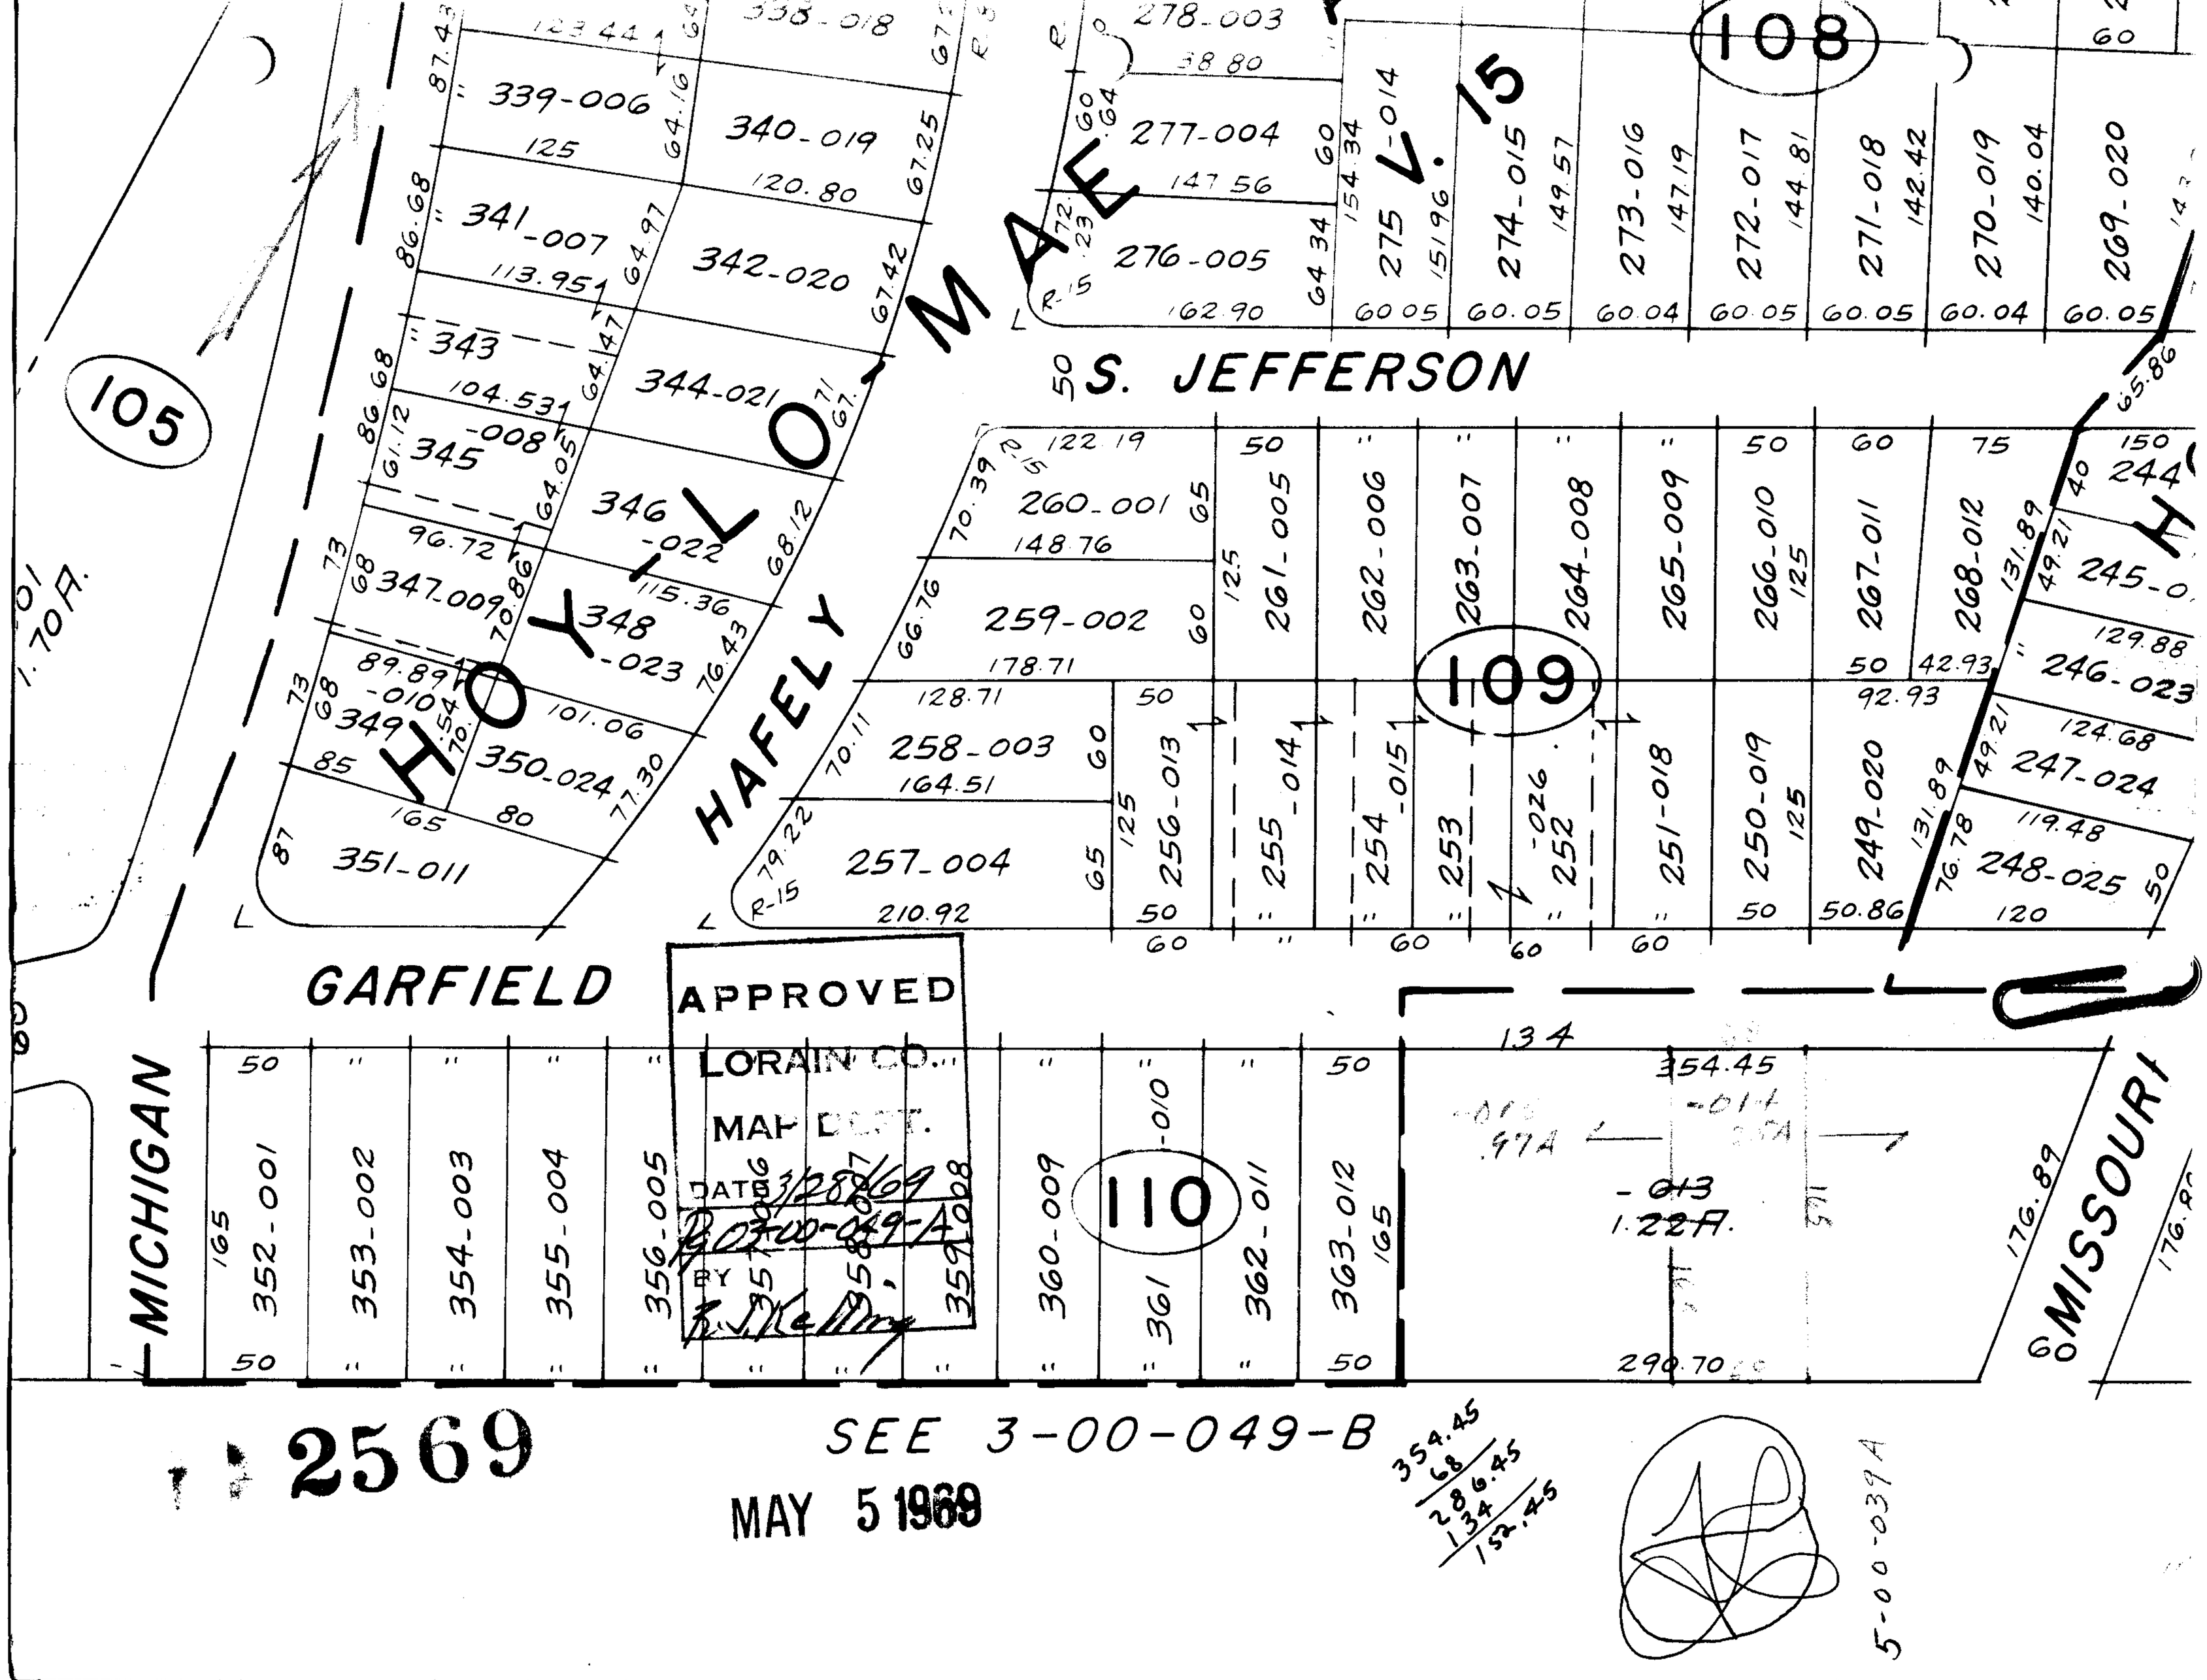

HOY-LO-MAE
HAFELY
S. JEFFERSON
GARFIELD
MICHIGAN
MISSOURI
105
108
109
110
V. 15
APPROVED
LORAIN CO.
MAP DEPT.
DATE 3/28/69
BY
SEE 3-00-049-B
2569
MAY 5 1969
5-00-039A