



SEE 6

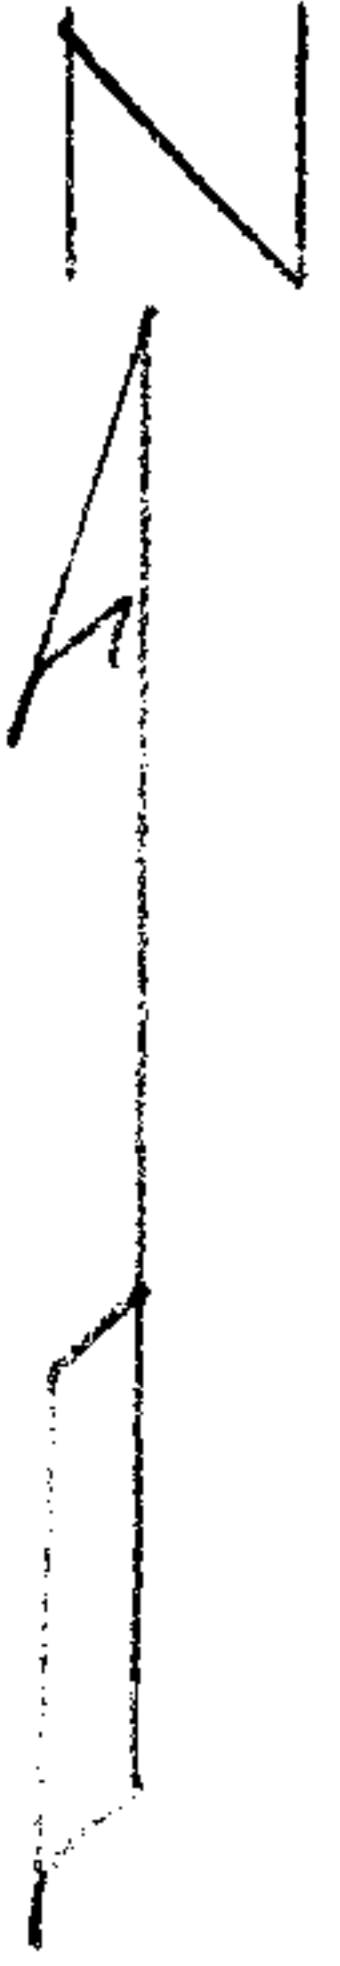

2252

469.67

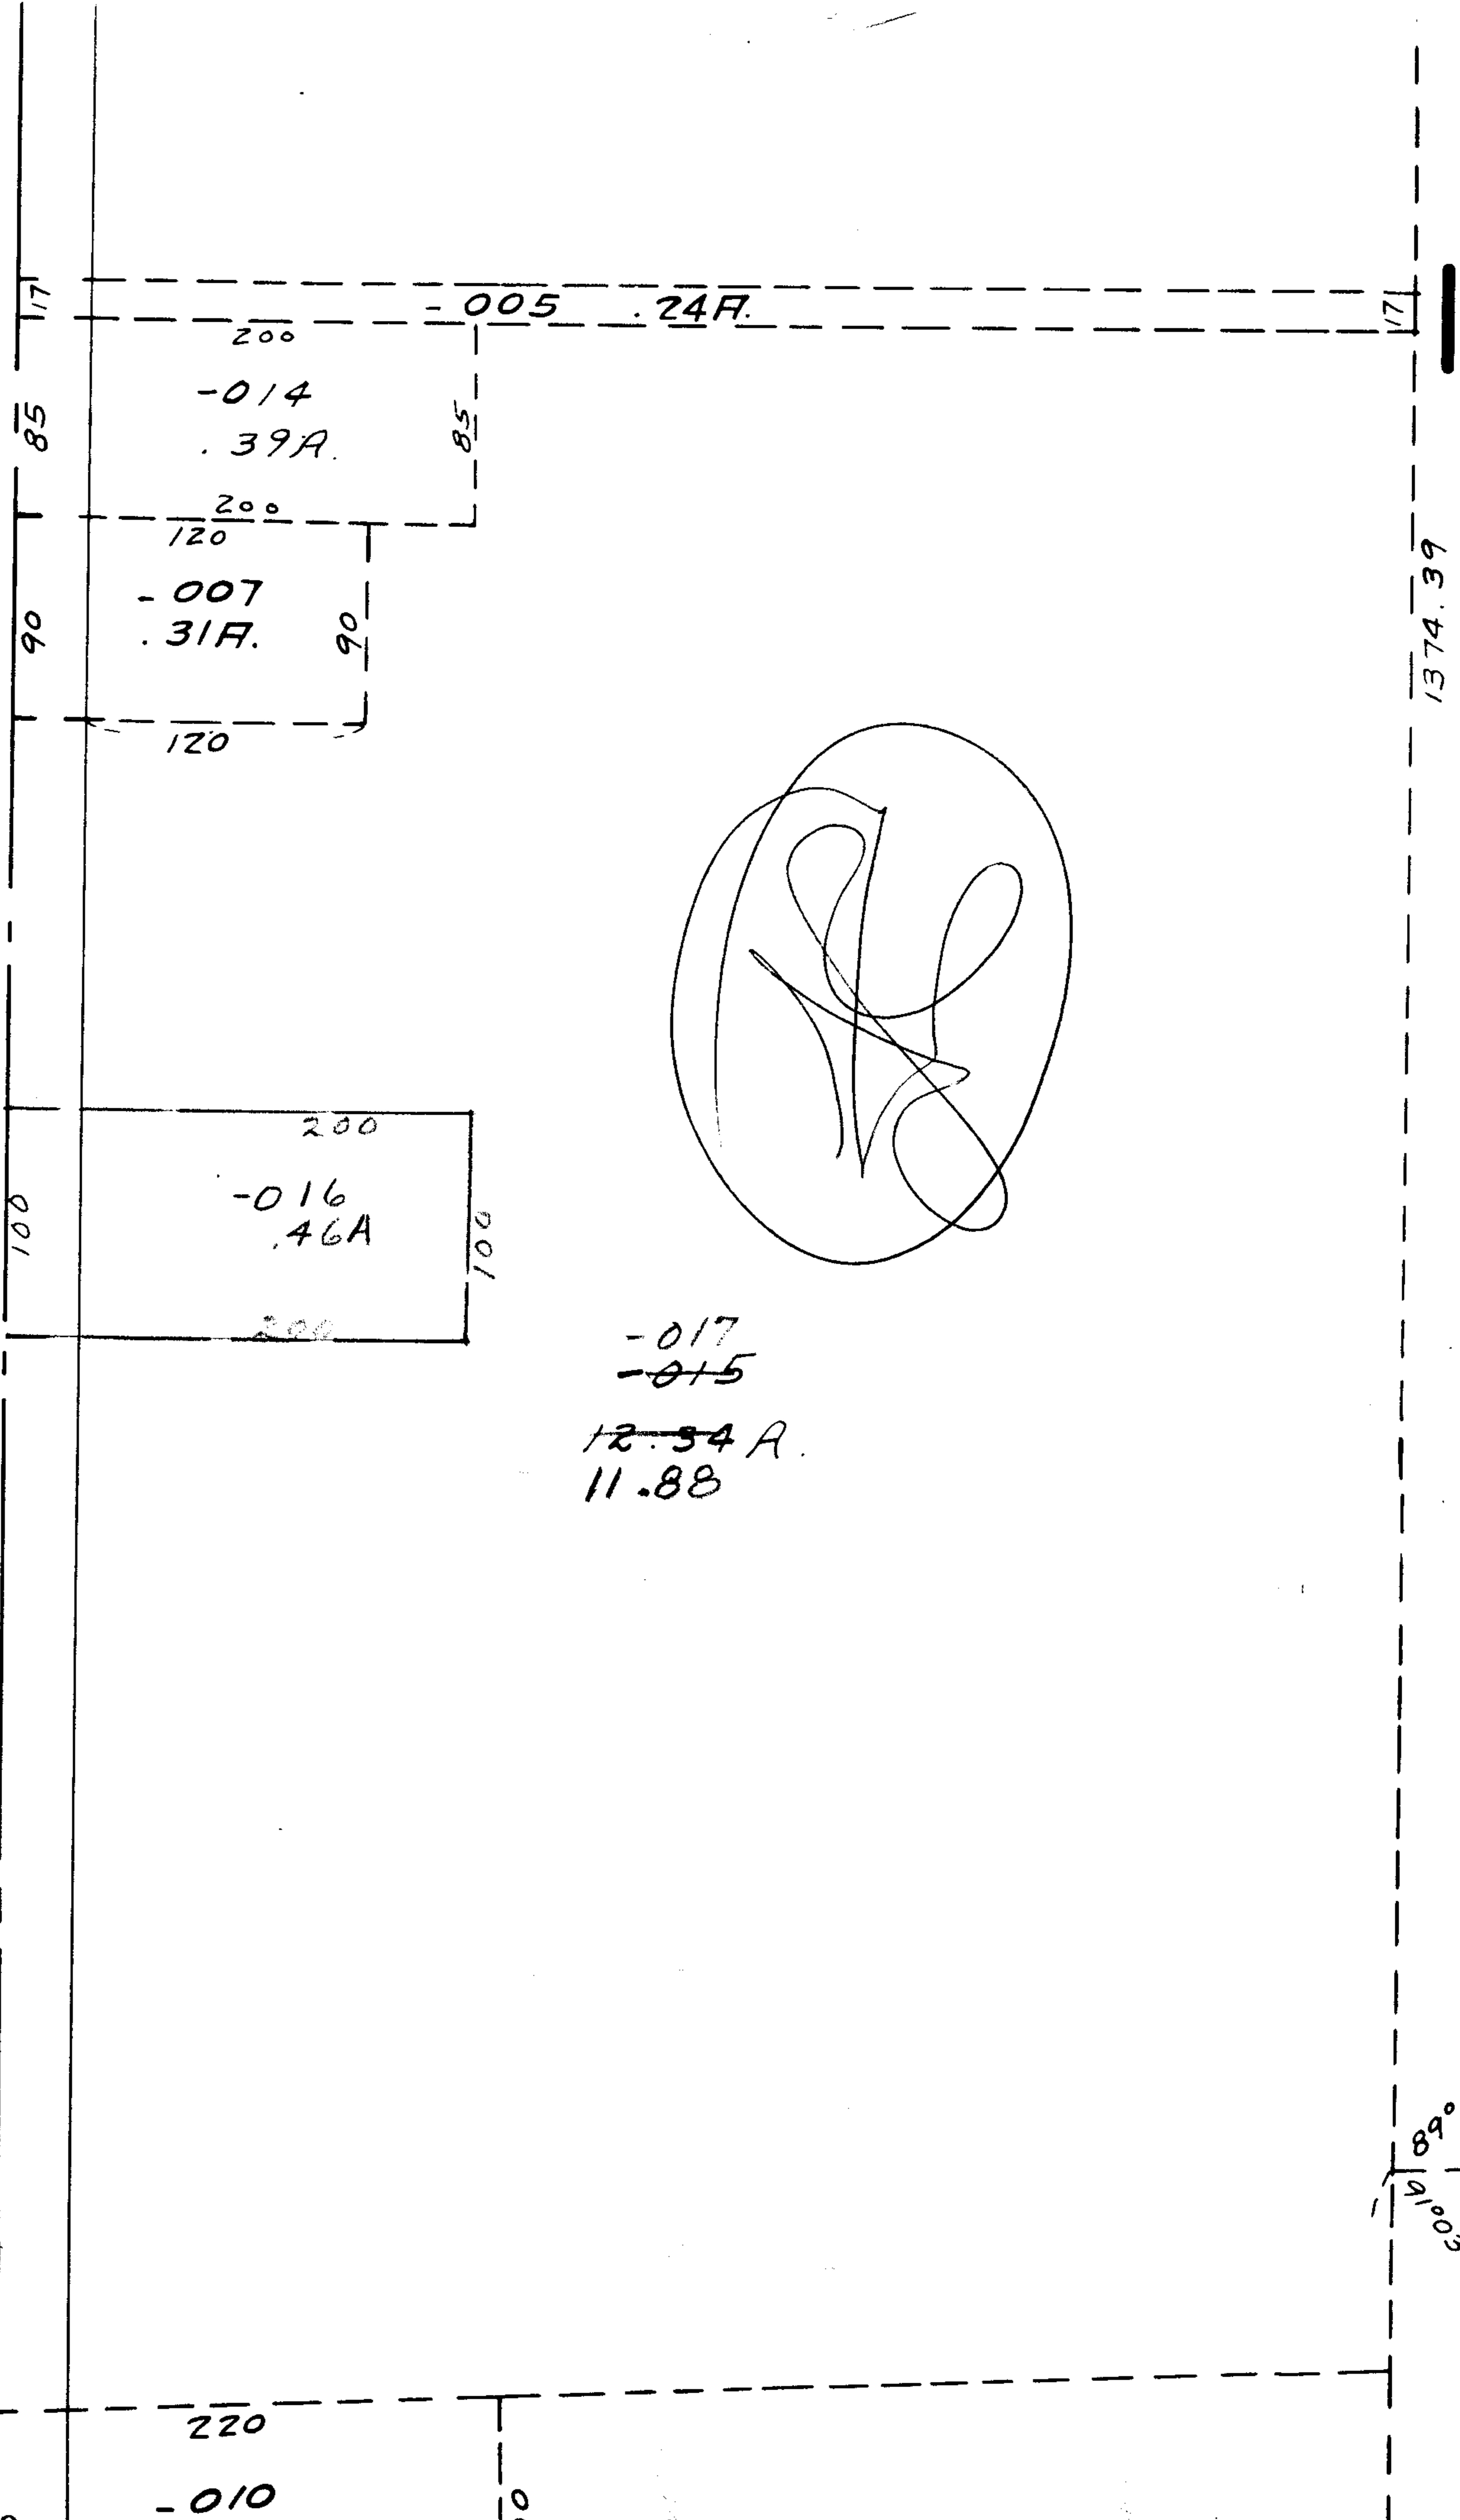

MAY 20 1969

APPROVED  
 LORAIN CO.  
 MAP DEPT.  
 DATE 4/3/69  
 Pg 6-143  
 BY J. Kelling

50019