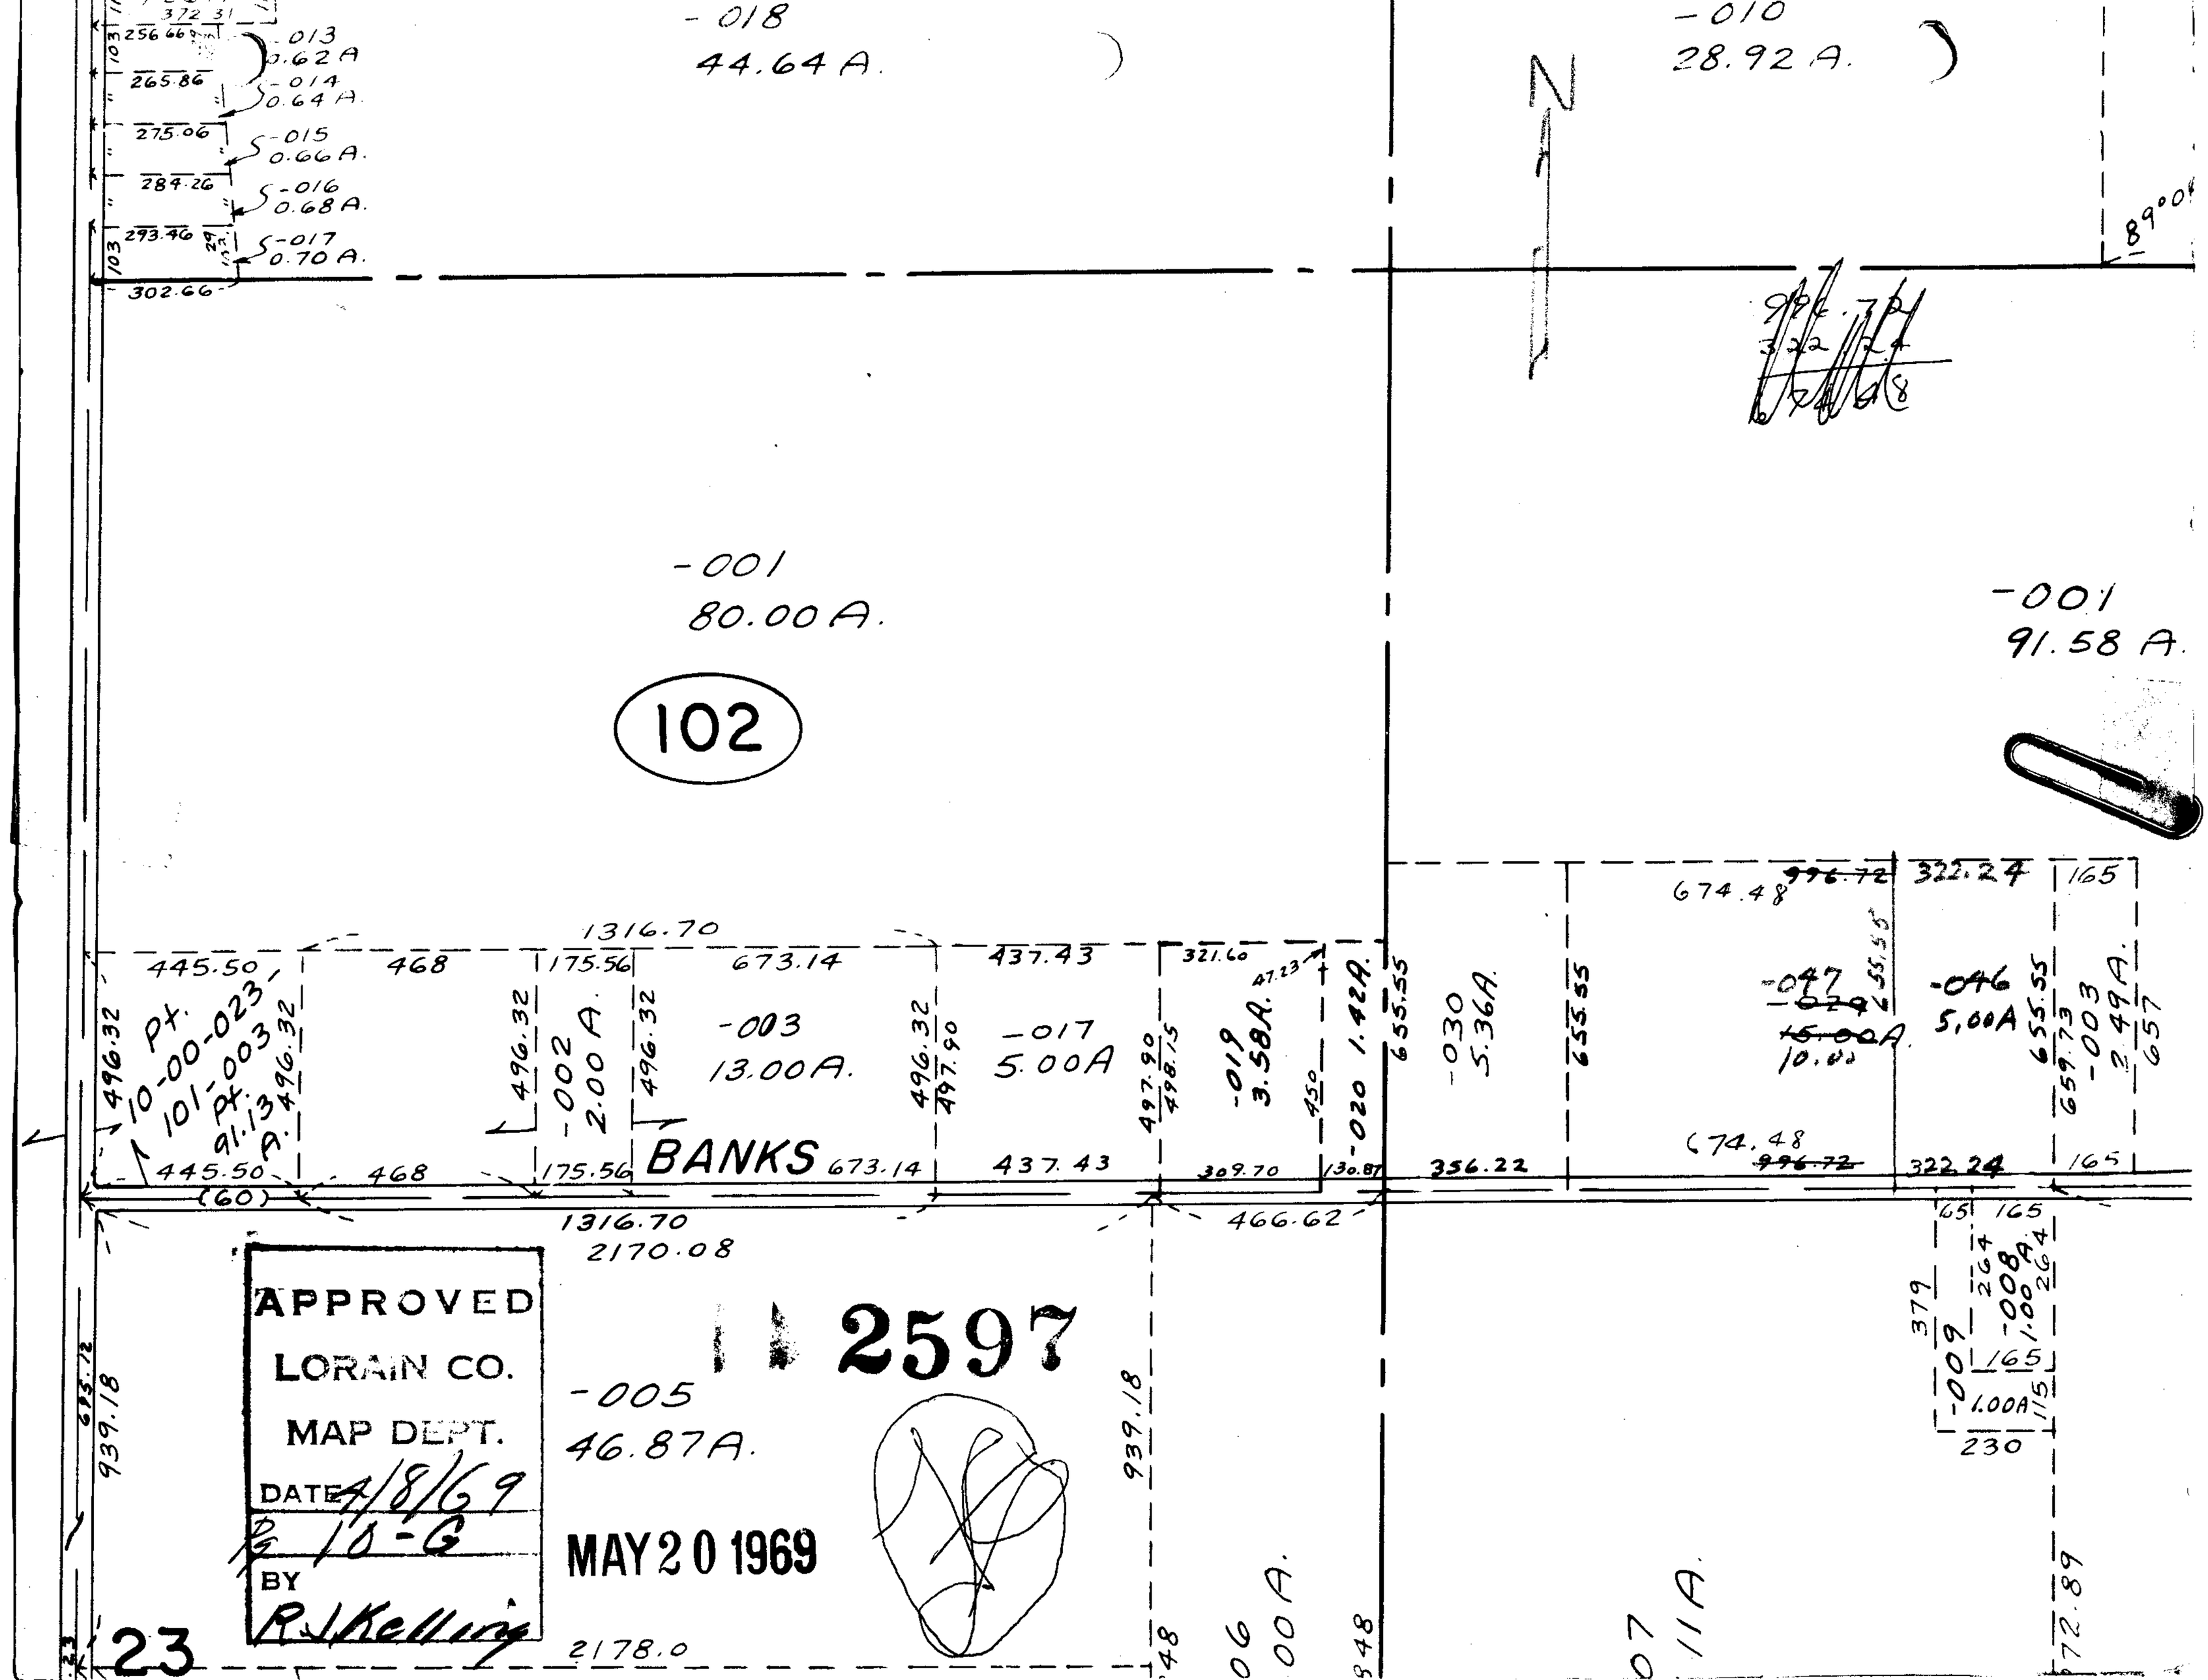

APPROVED
LORAIN CO.
MAP DEPT.
DATE 4/8/69
Pg 10-G
BY R.J. Kelling

23