




2000

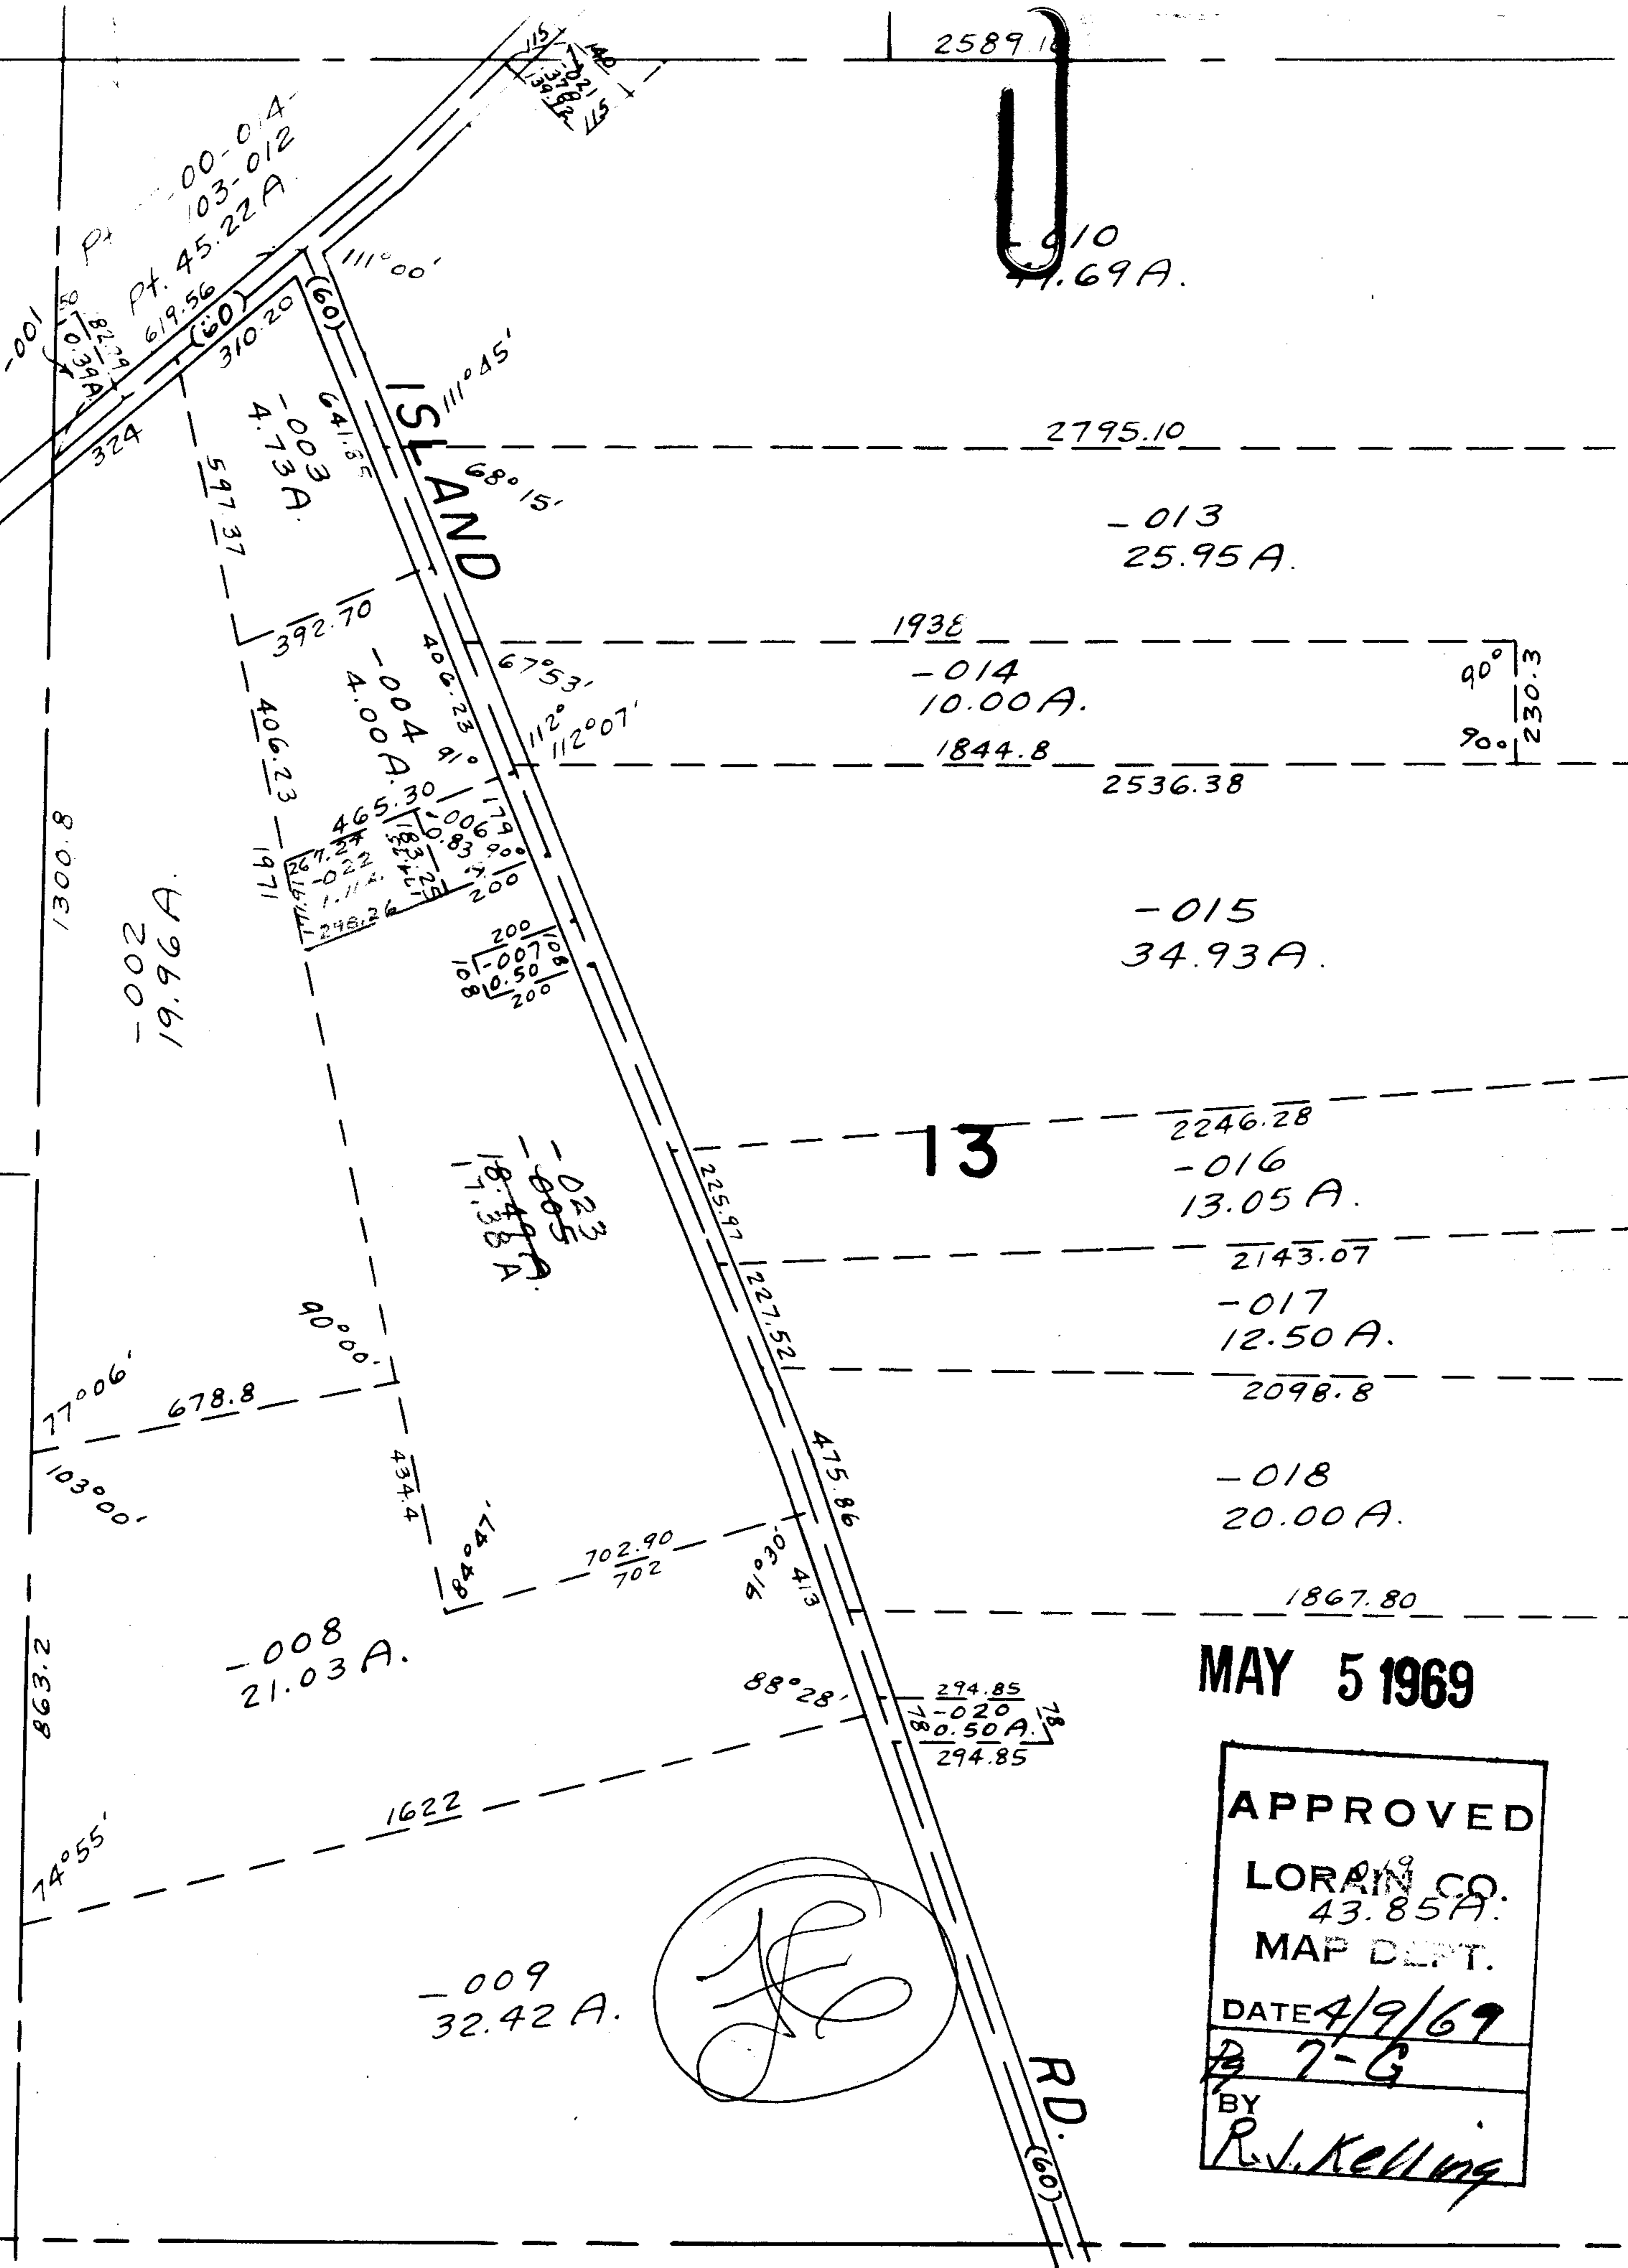

SEE 11-C

MAY 5 1969

APPROVED
 LORAIN CO.
 43.85A.
 MAP DEPT.
 DATE 4/9/69
 BY R.V. Kelling