


SEE 4-00-010-F

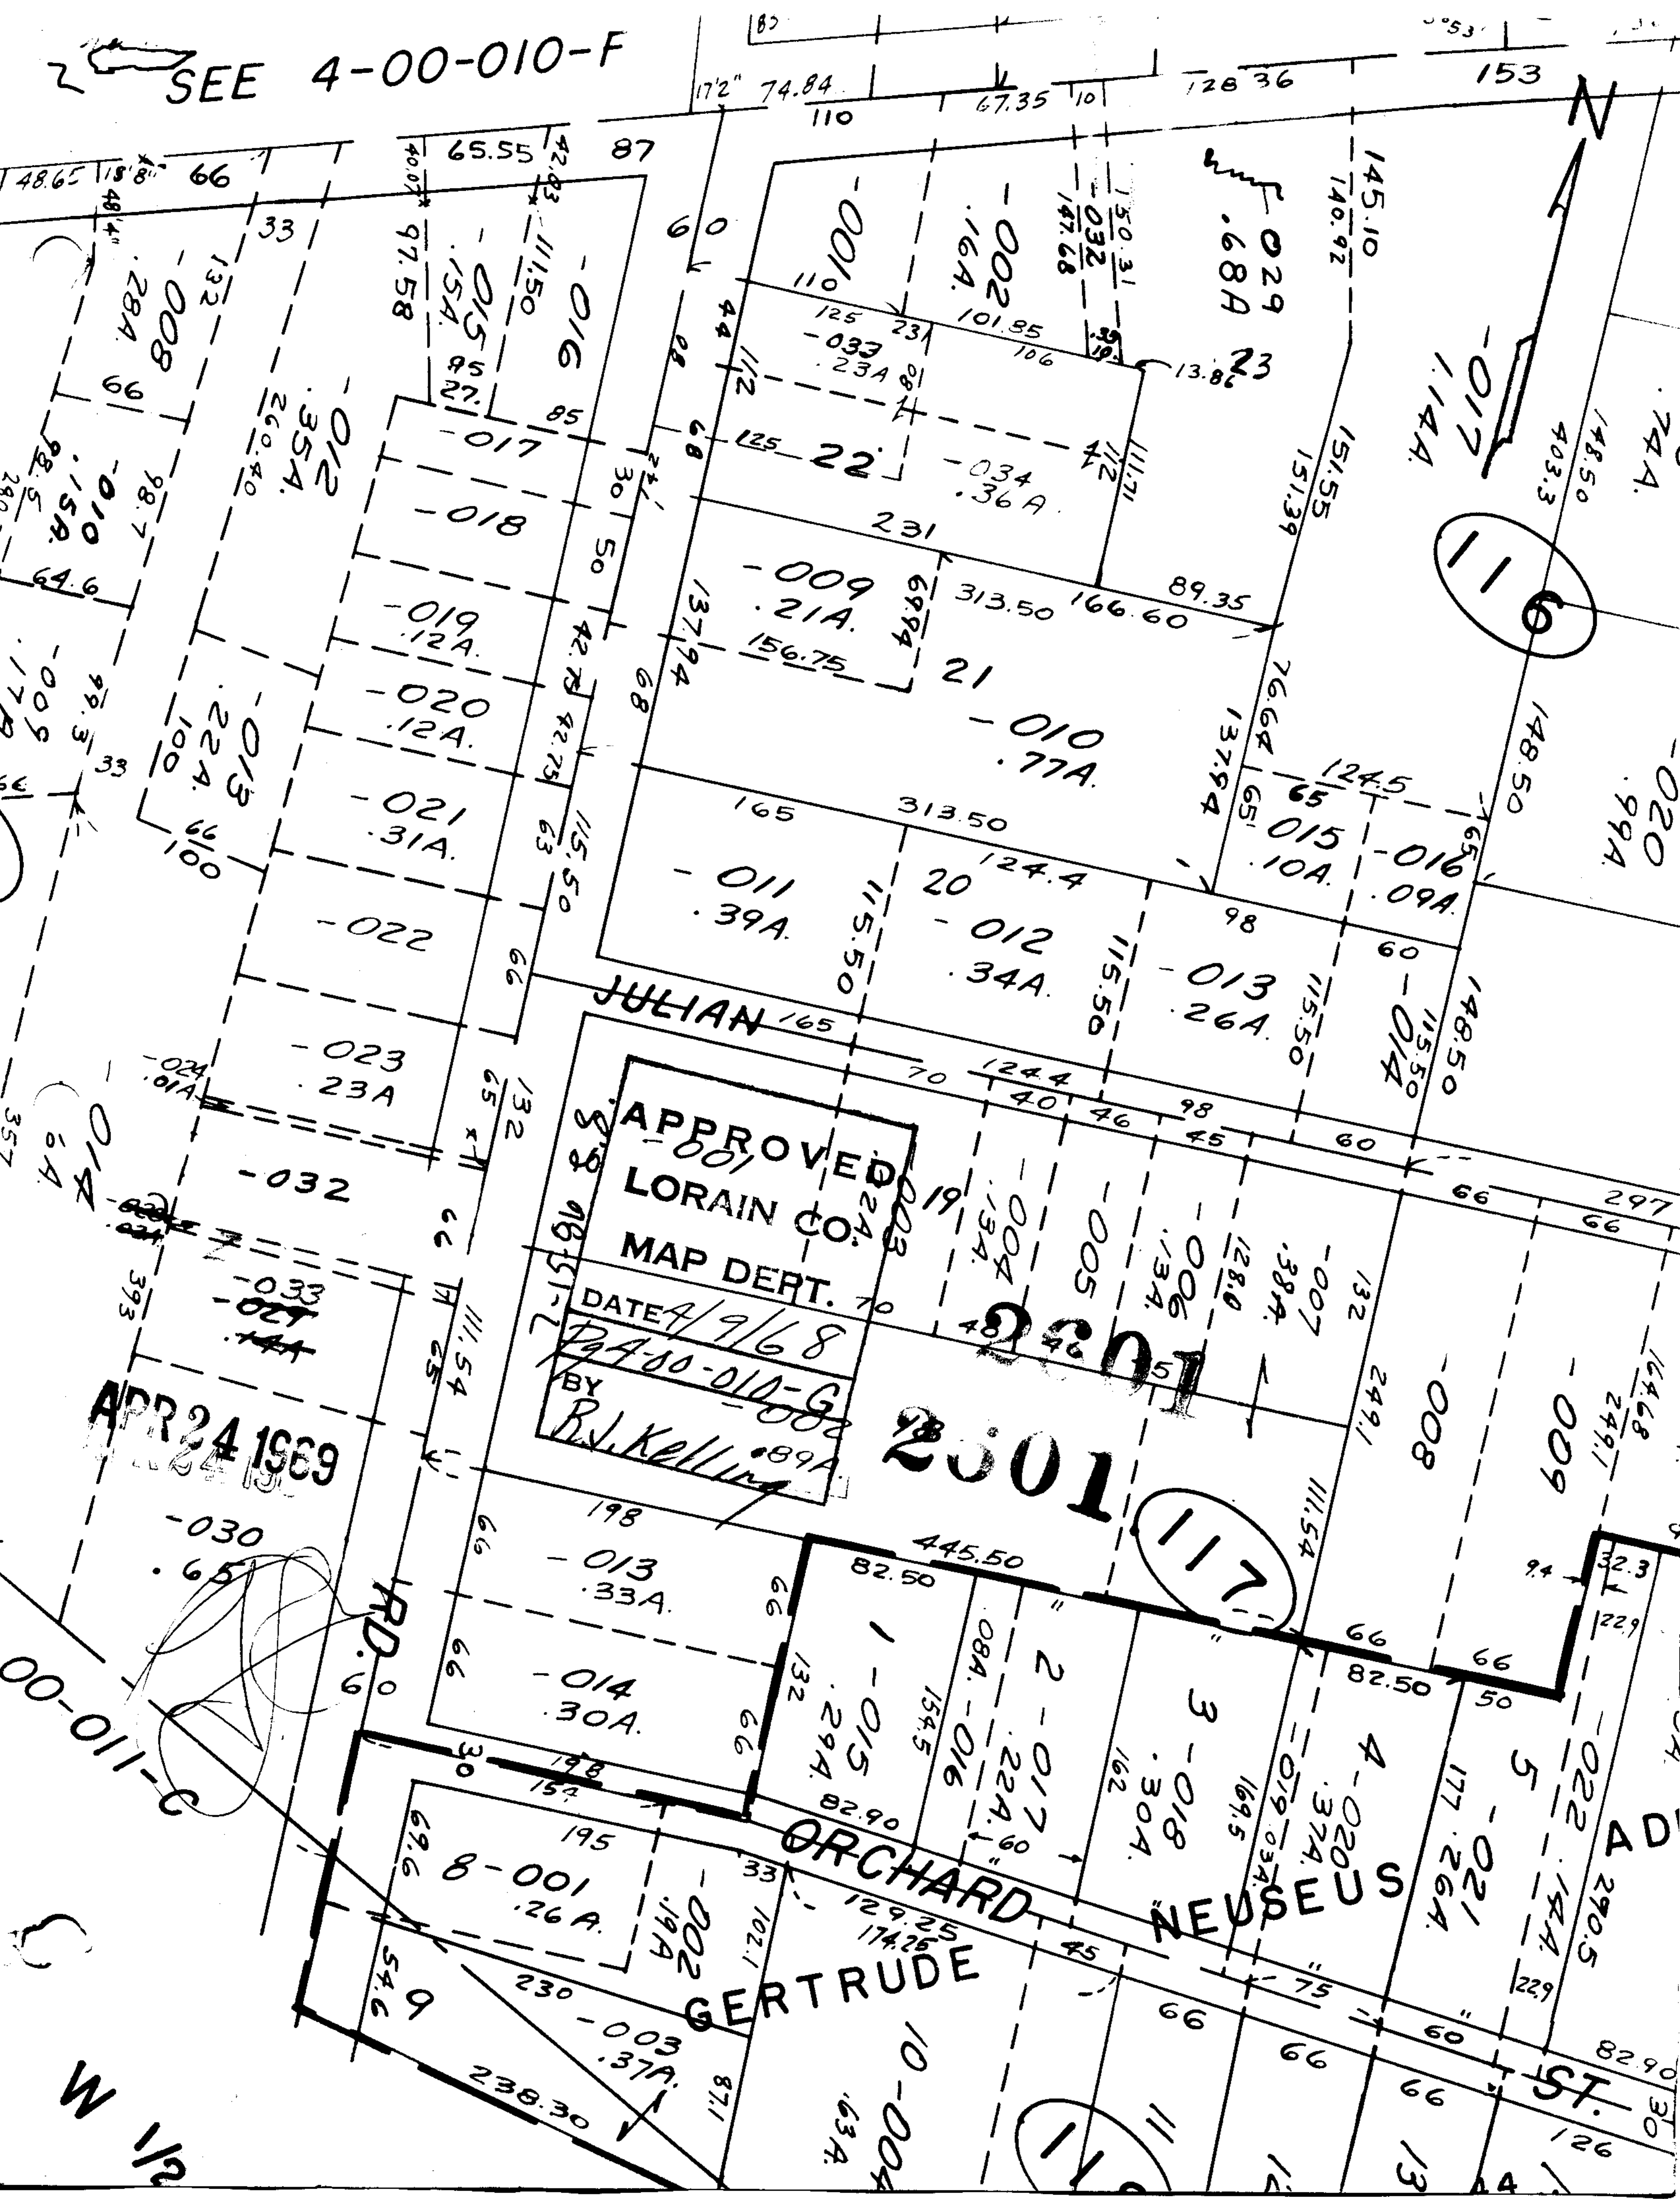

APPROVED
 -001
 LORAIN CO.
 MAP DERT.
 DATE 9/168
 24-00-010-G
 BY
 P.J. Kelling

2501

APR 24 1969

ORCHARD

GERTRUDE

NEUSE

RD. 0
 1/2
 W

RD. 0

RD. 0