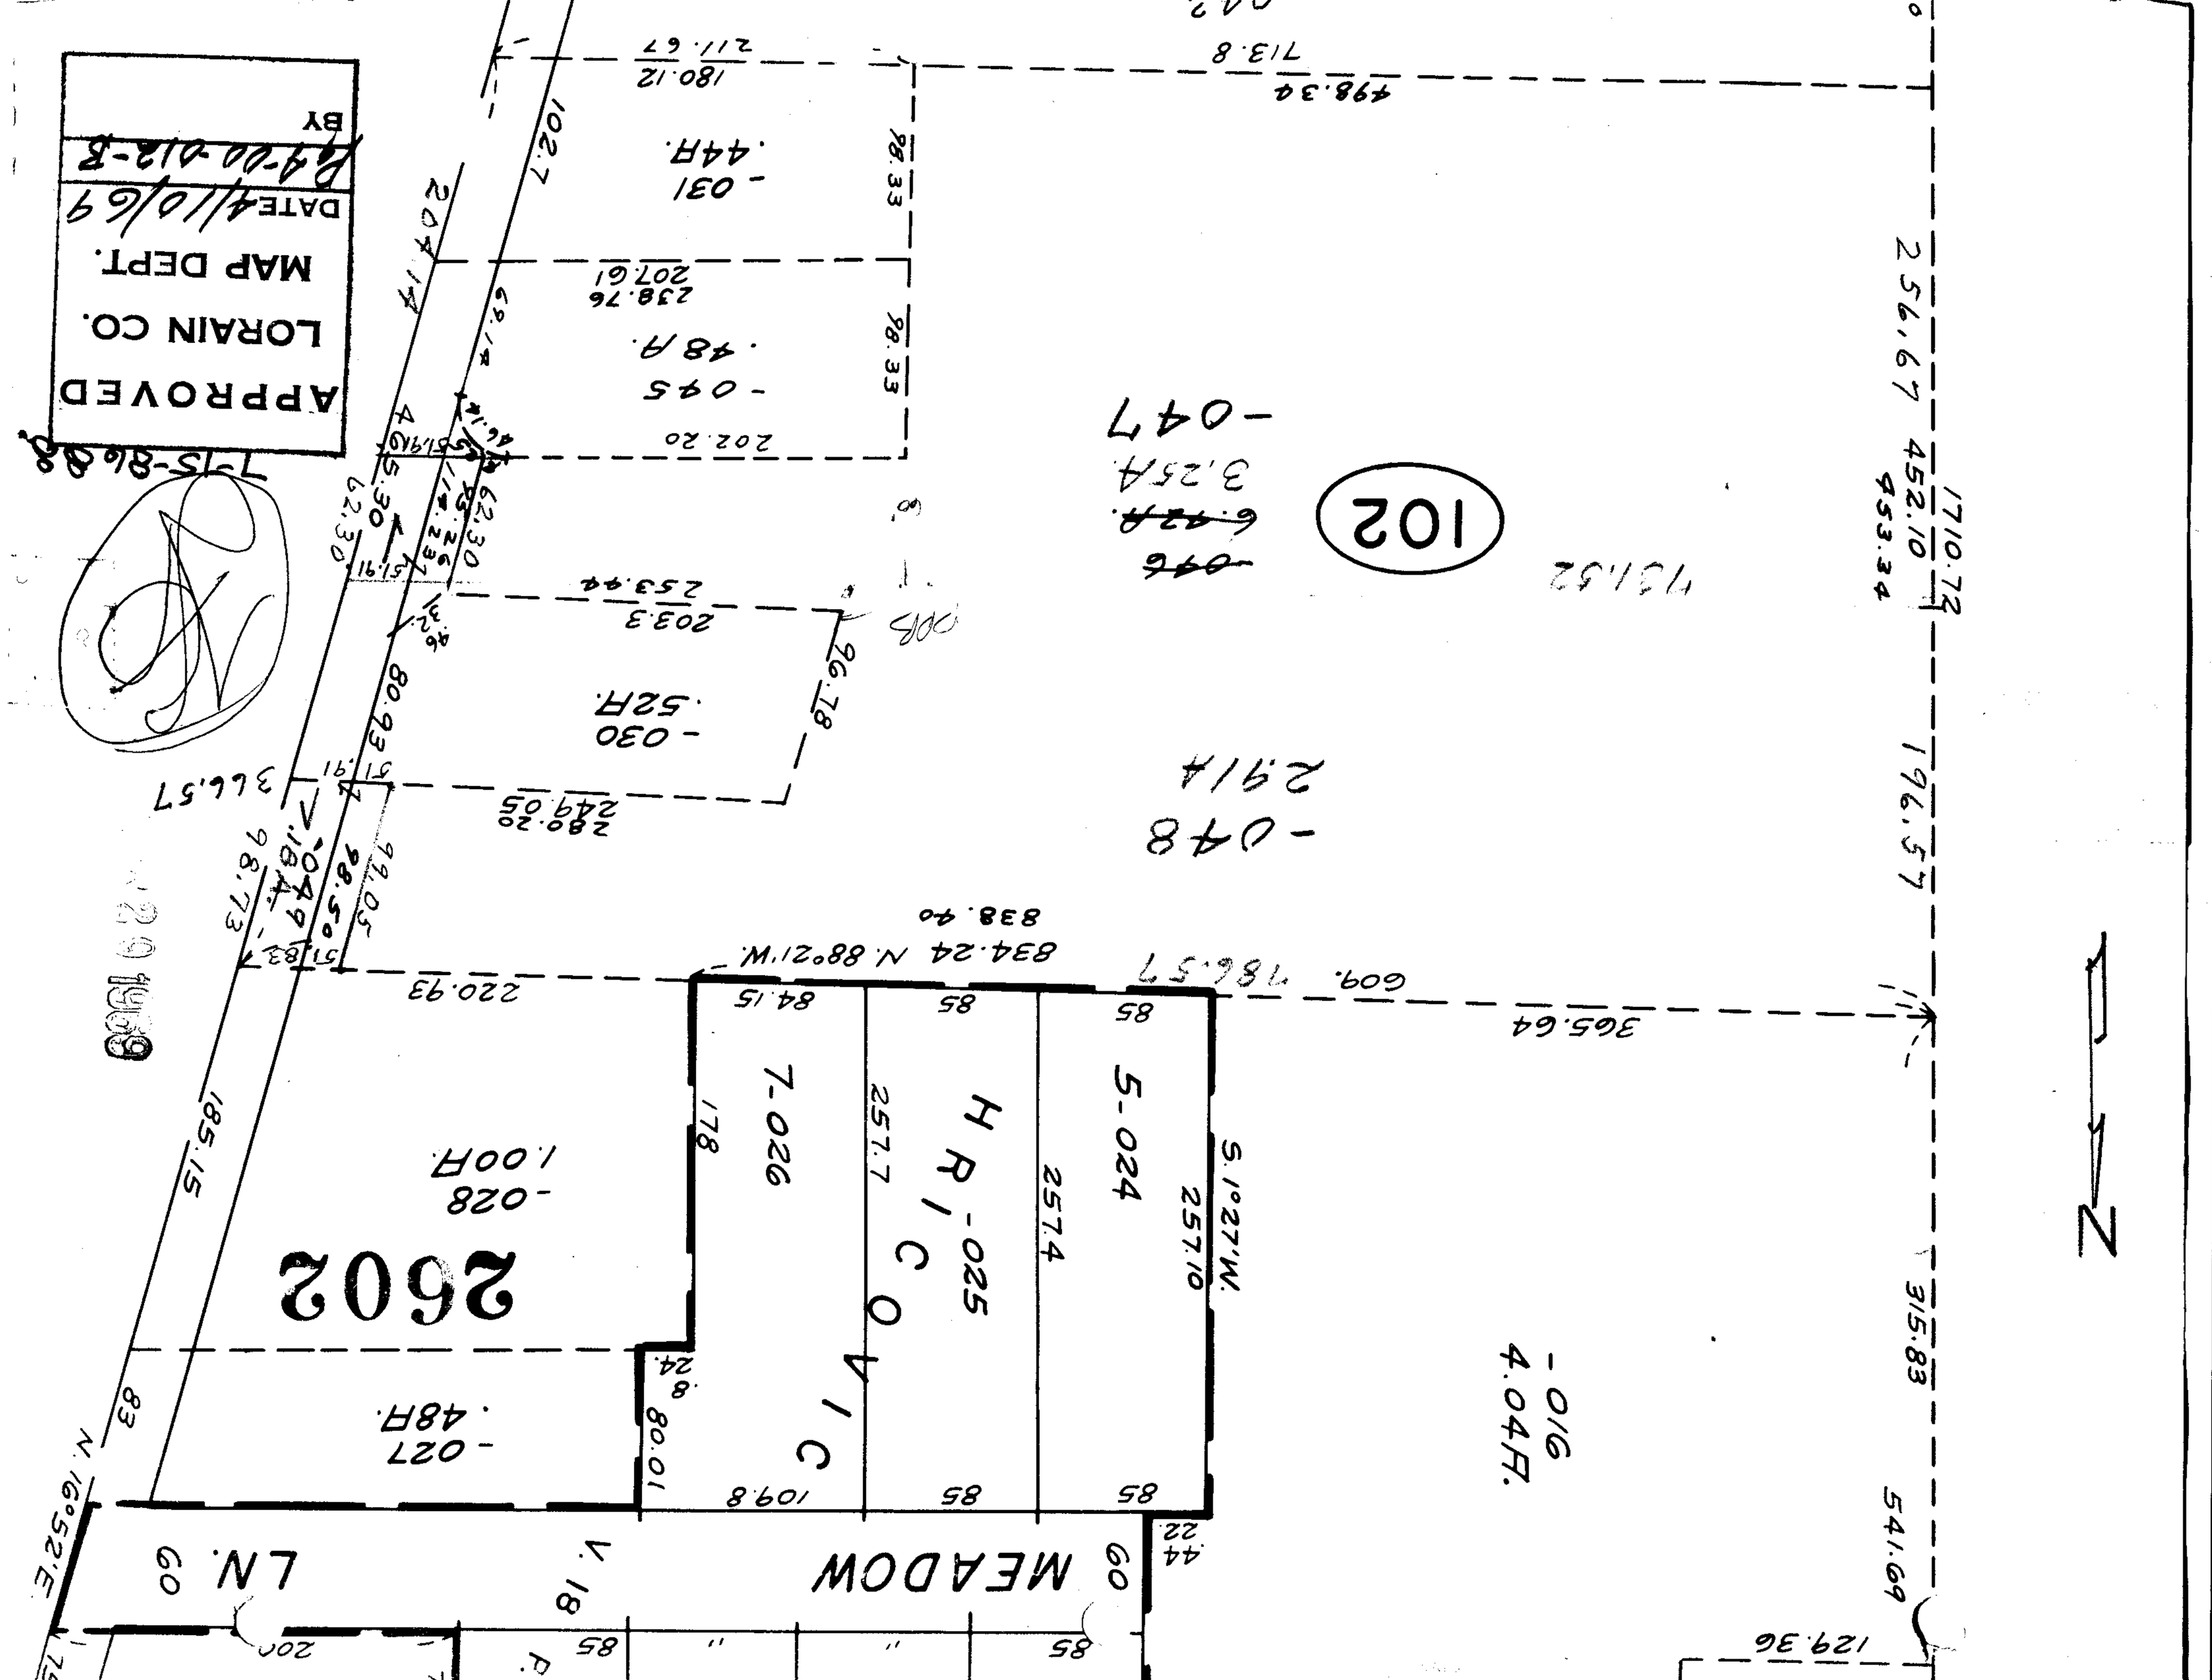
APPROVED
LORAIN CO.
MAP DEPT.
DATE 4/10/69
BY
7-15-86 88
102
-047
3.25A
-048
2.91A
-031
.44A.
-045
.48A.
-030
.52A.
-028
1.00A.
-027
.48A.
-016
4.04A.
HRICOVIC
-025
7-026
5-024
2602
MEADOW
LN.
N
1710.72
452.10
453.34
196.57
256.67
365.64
609.
786.57
834.24 N. 88°21'W.
838.40
220.93
185.15
315.83
541.69
129.36
498.34
713.8
180.12
211.67
102.7
204.14
238.76
207.61
202.20
253.44
203.3
280.20
249.05
366.57
98.73
99.05
98.50
98.33
96.78
80.93
62.30
69.14
84.15
85
178
257.7
257.4
257.10
S. 1°27'W.
109.8
80.01
N. 16°52'E.
V. 18
60
200
44.22
83
24.8