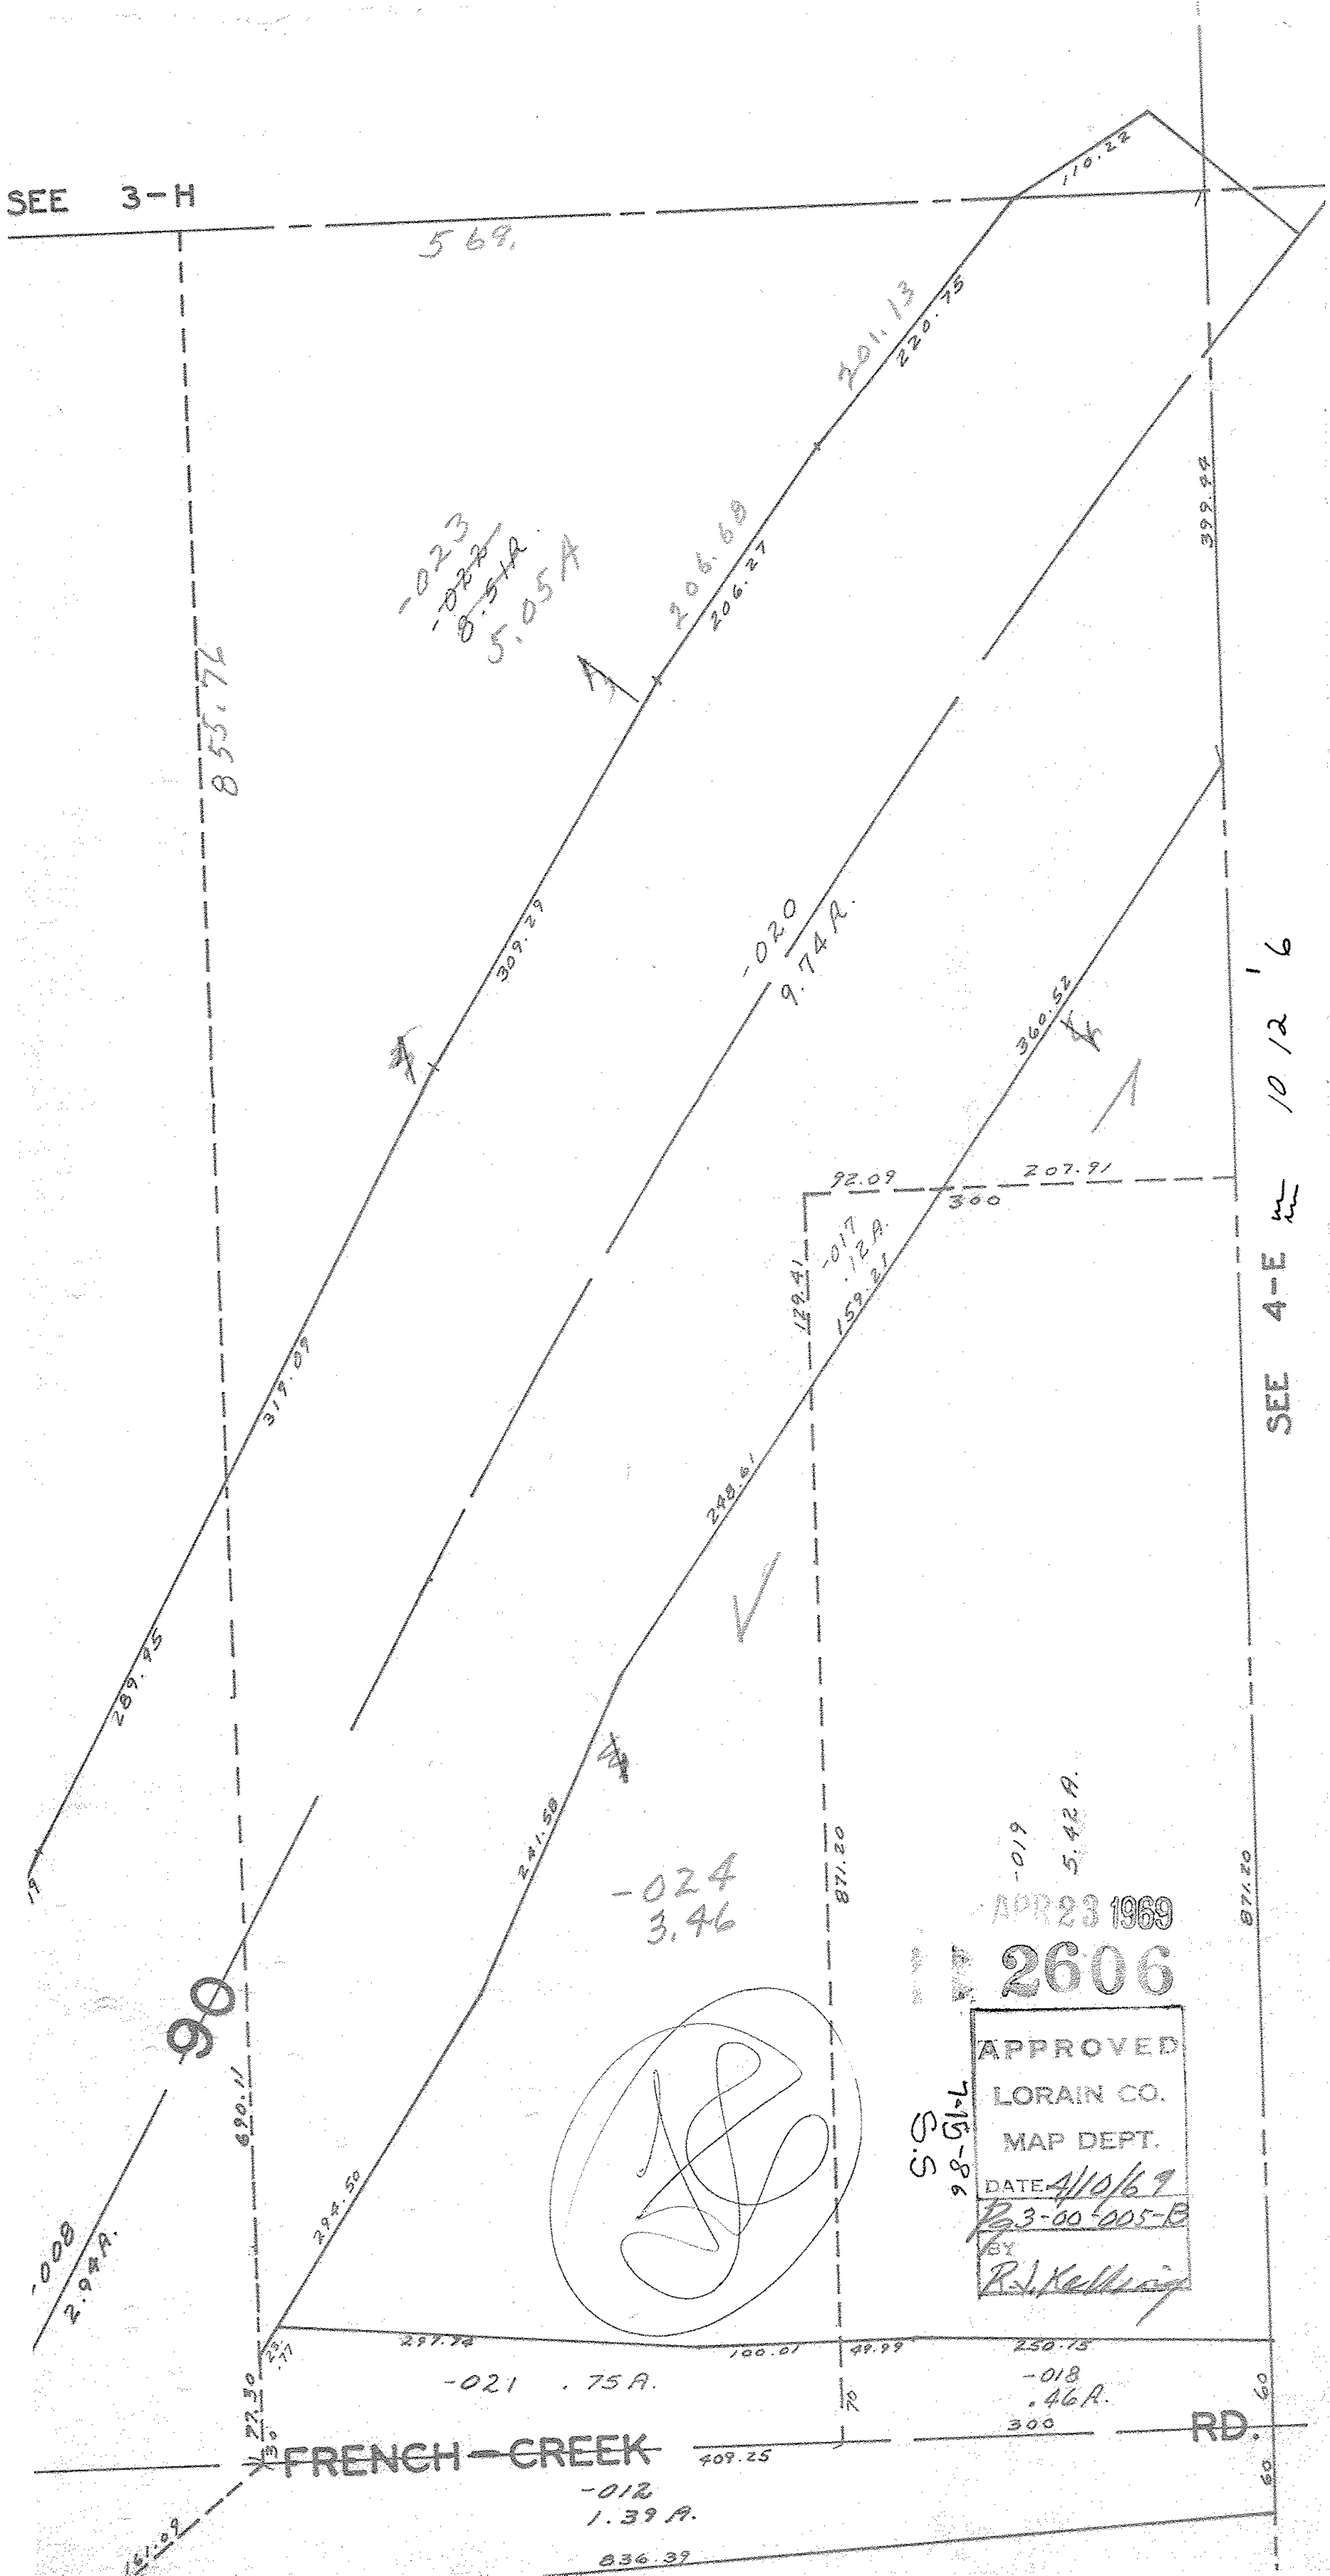
SEE 3-H
569.
110.22
201.13
220.75
206.68
206.27
399.44
-023
-024
8.54A.
5.05A
855.74
309.29
-020
9.74A.
360.52
92.09
207.91
300
SEE 4-E
10 12 16
129.41
-017
.12A.
159.21
319.09
248.61
289.45
241.50
871.20
-019
5.42A.
-024
3.46
APR 23 1969
2606
APPROVED
LORAIN CO.
MAP DEPT.
DATE 4/10/69
R3-00-005-B
BY
R.J. Kelly
S.S.
9-8-GI-L
90
620.11
294.50
-008
2.94A.
297.74
100.01
49.99
250.15
-021 .75A.
-018
.46A.
70
300
60
22.30
FRENCH CREEK
409.25
-012
1.39A.
836.39
RD.