


SEE 3-L

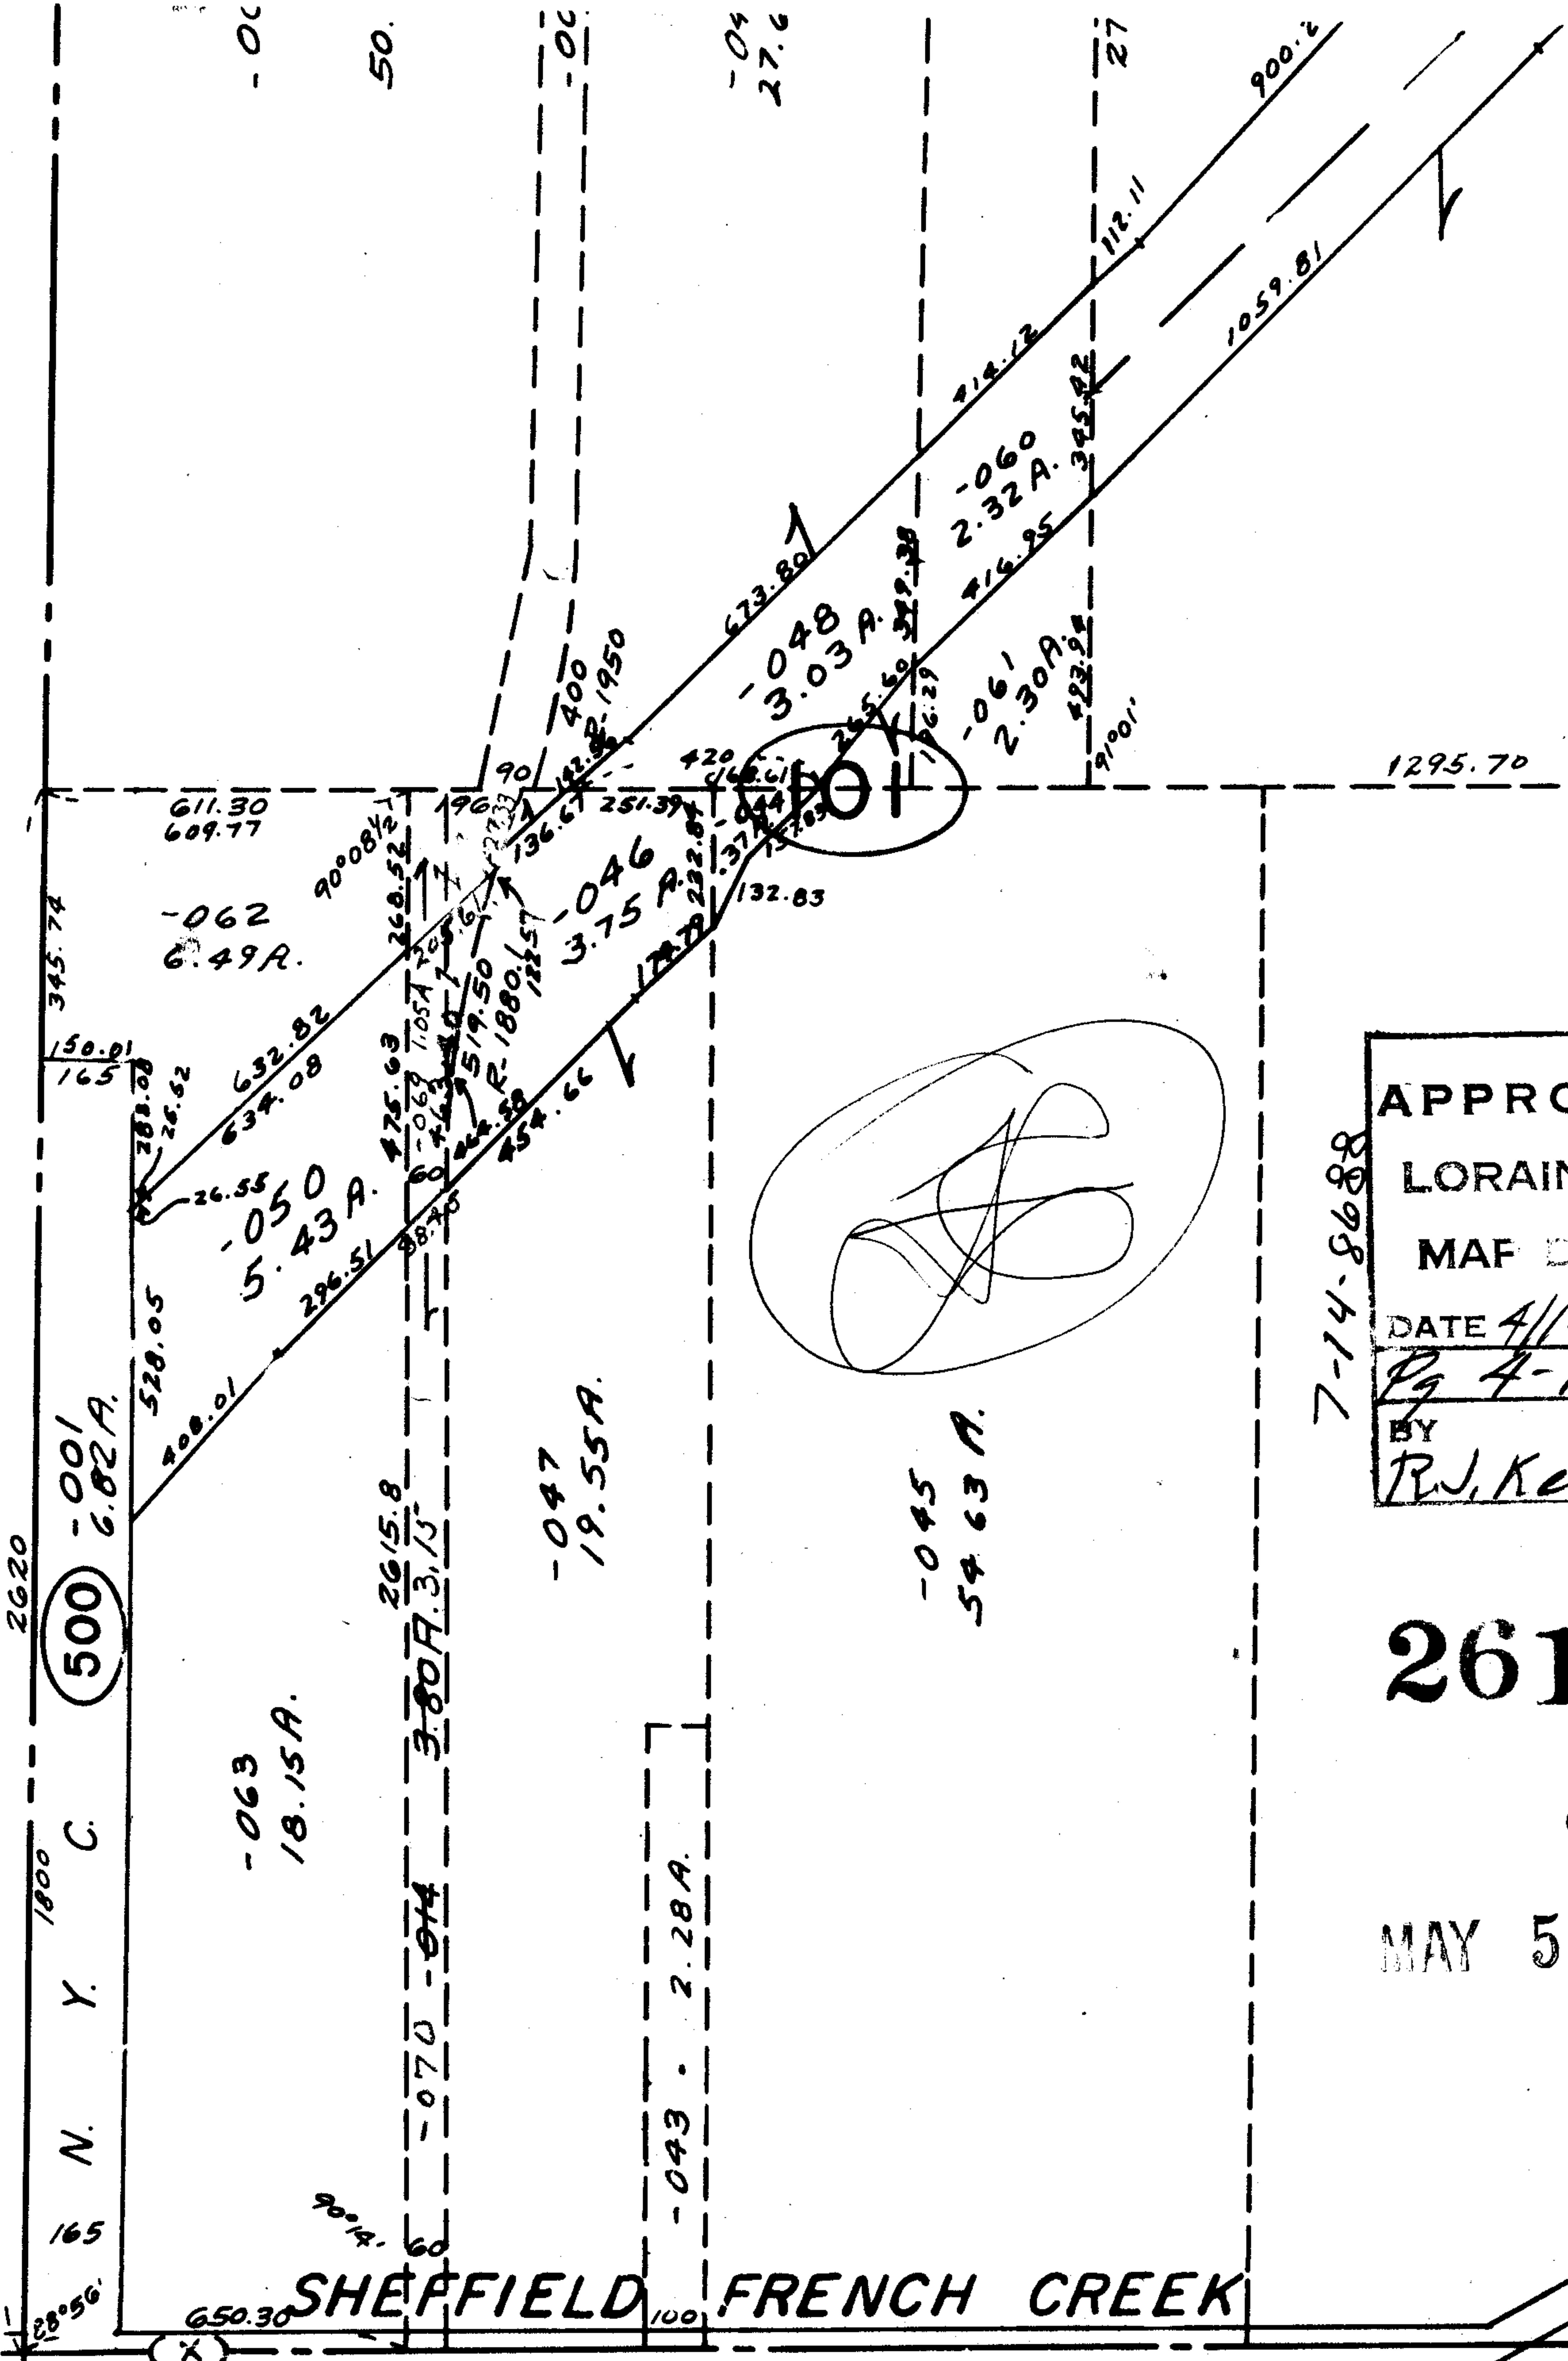

APPROVED
 LORAIN CO.
 MAF DEPT.
 DATE 4/14/69
 Pg 4-E
 BY
 R.J. Kelling

7-14-8688

2613

SEE 4-00

MAY 5 1969

SEE 4-

3