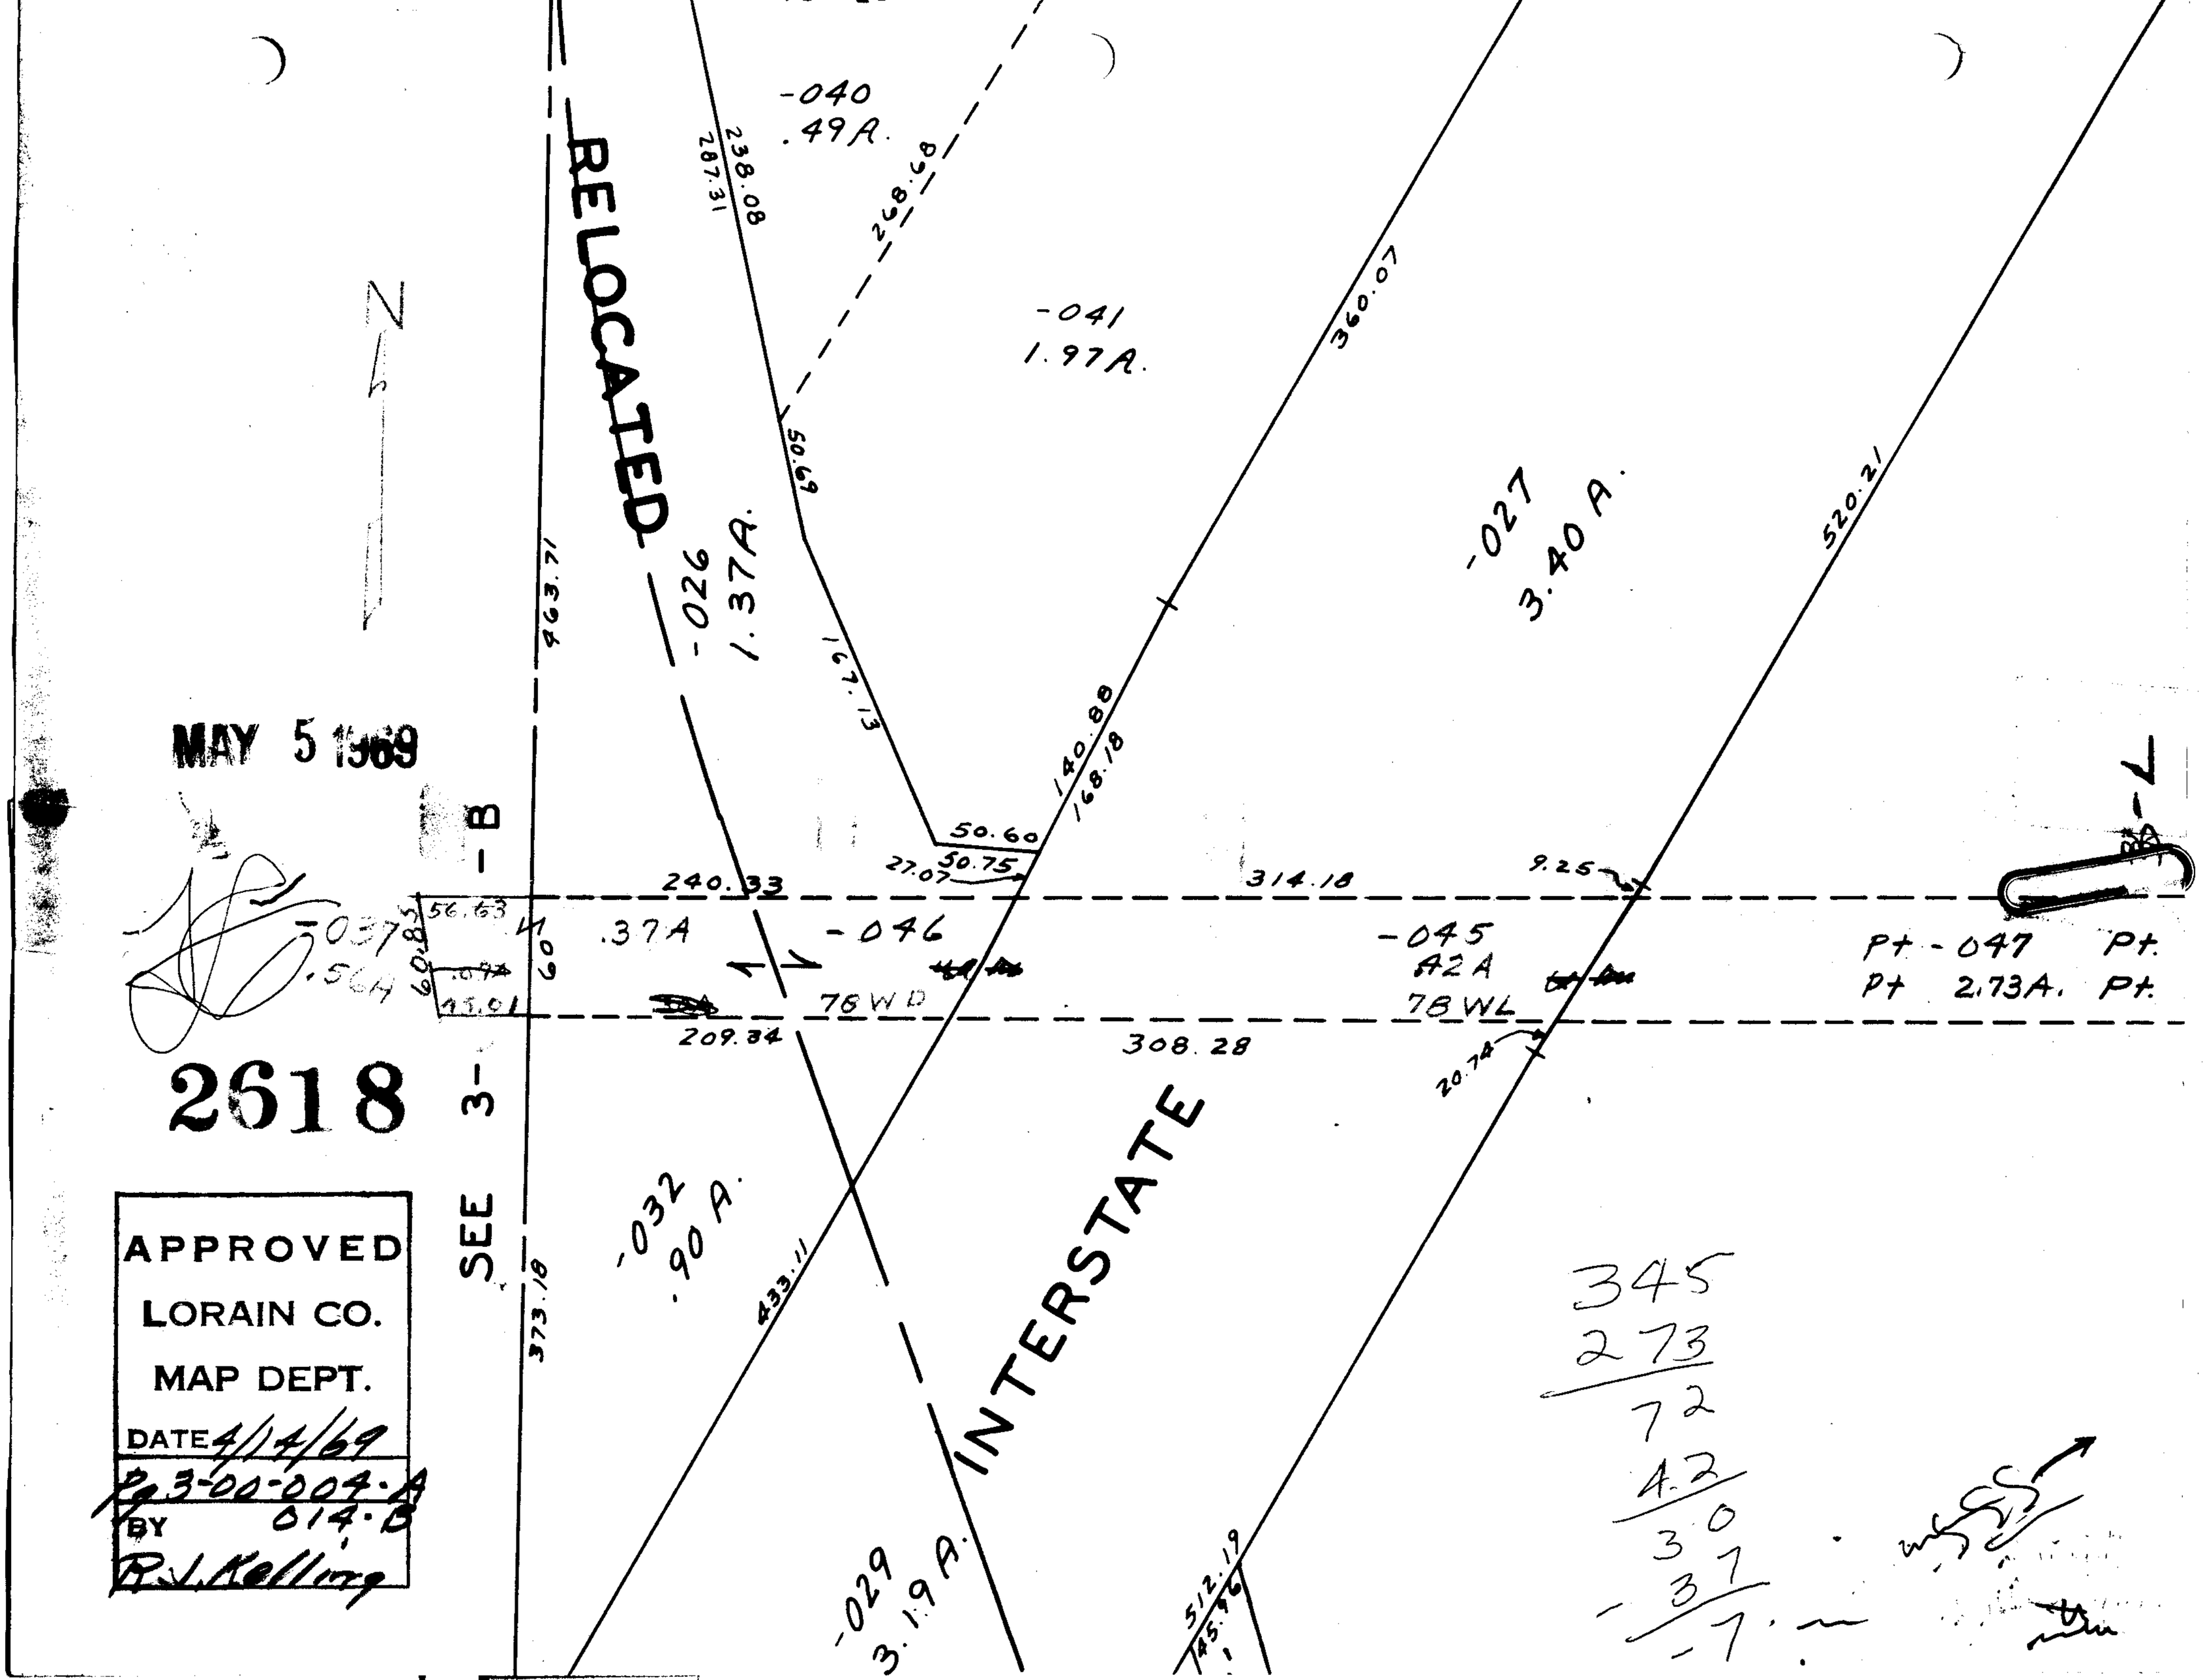

MAY 5 1969

2618

APPROVED
LORAIN CO.
MAP DEPT.
DATE 4/14/69
Pg 3-00-004-A
BY 014-B
R.J. Kelling