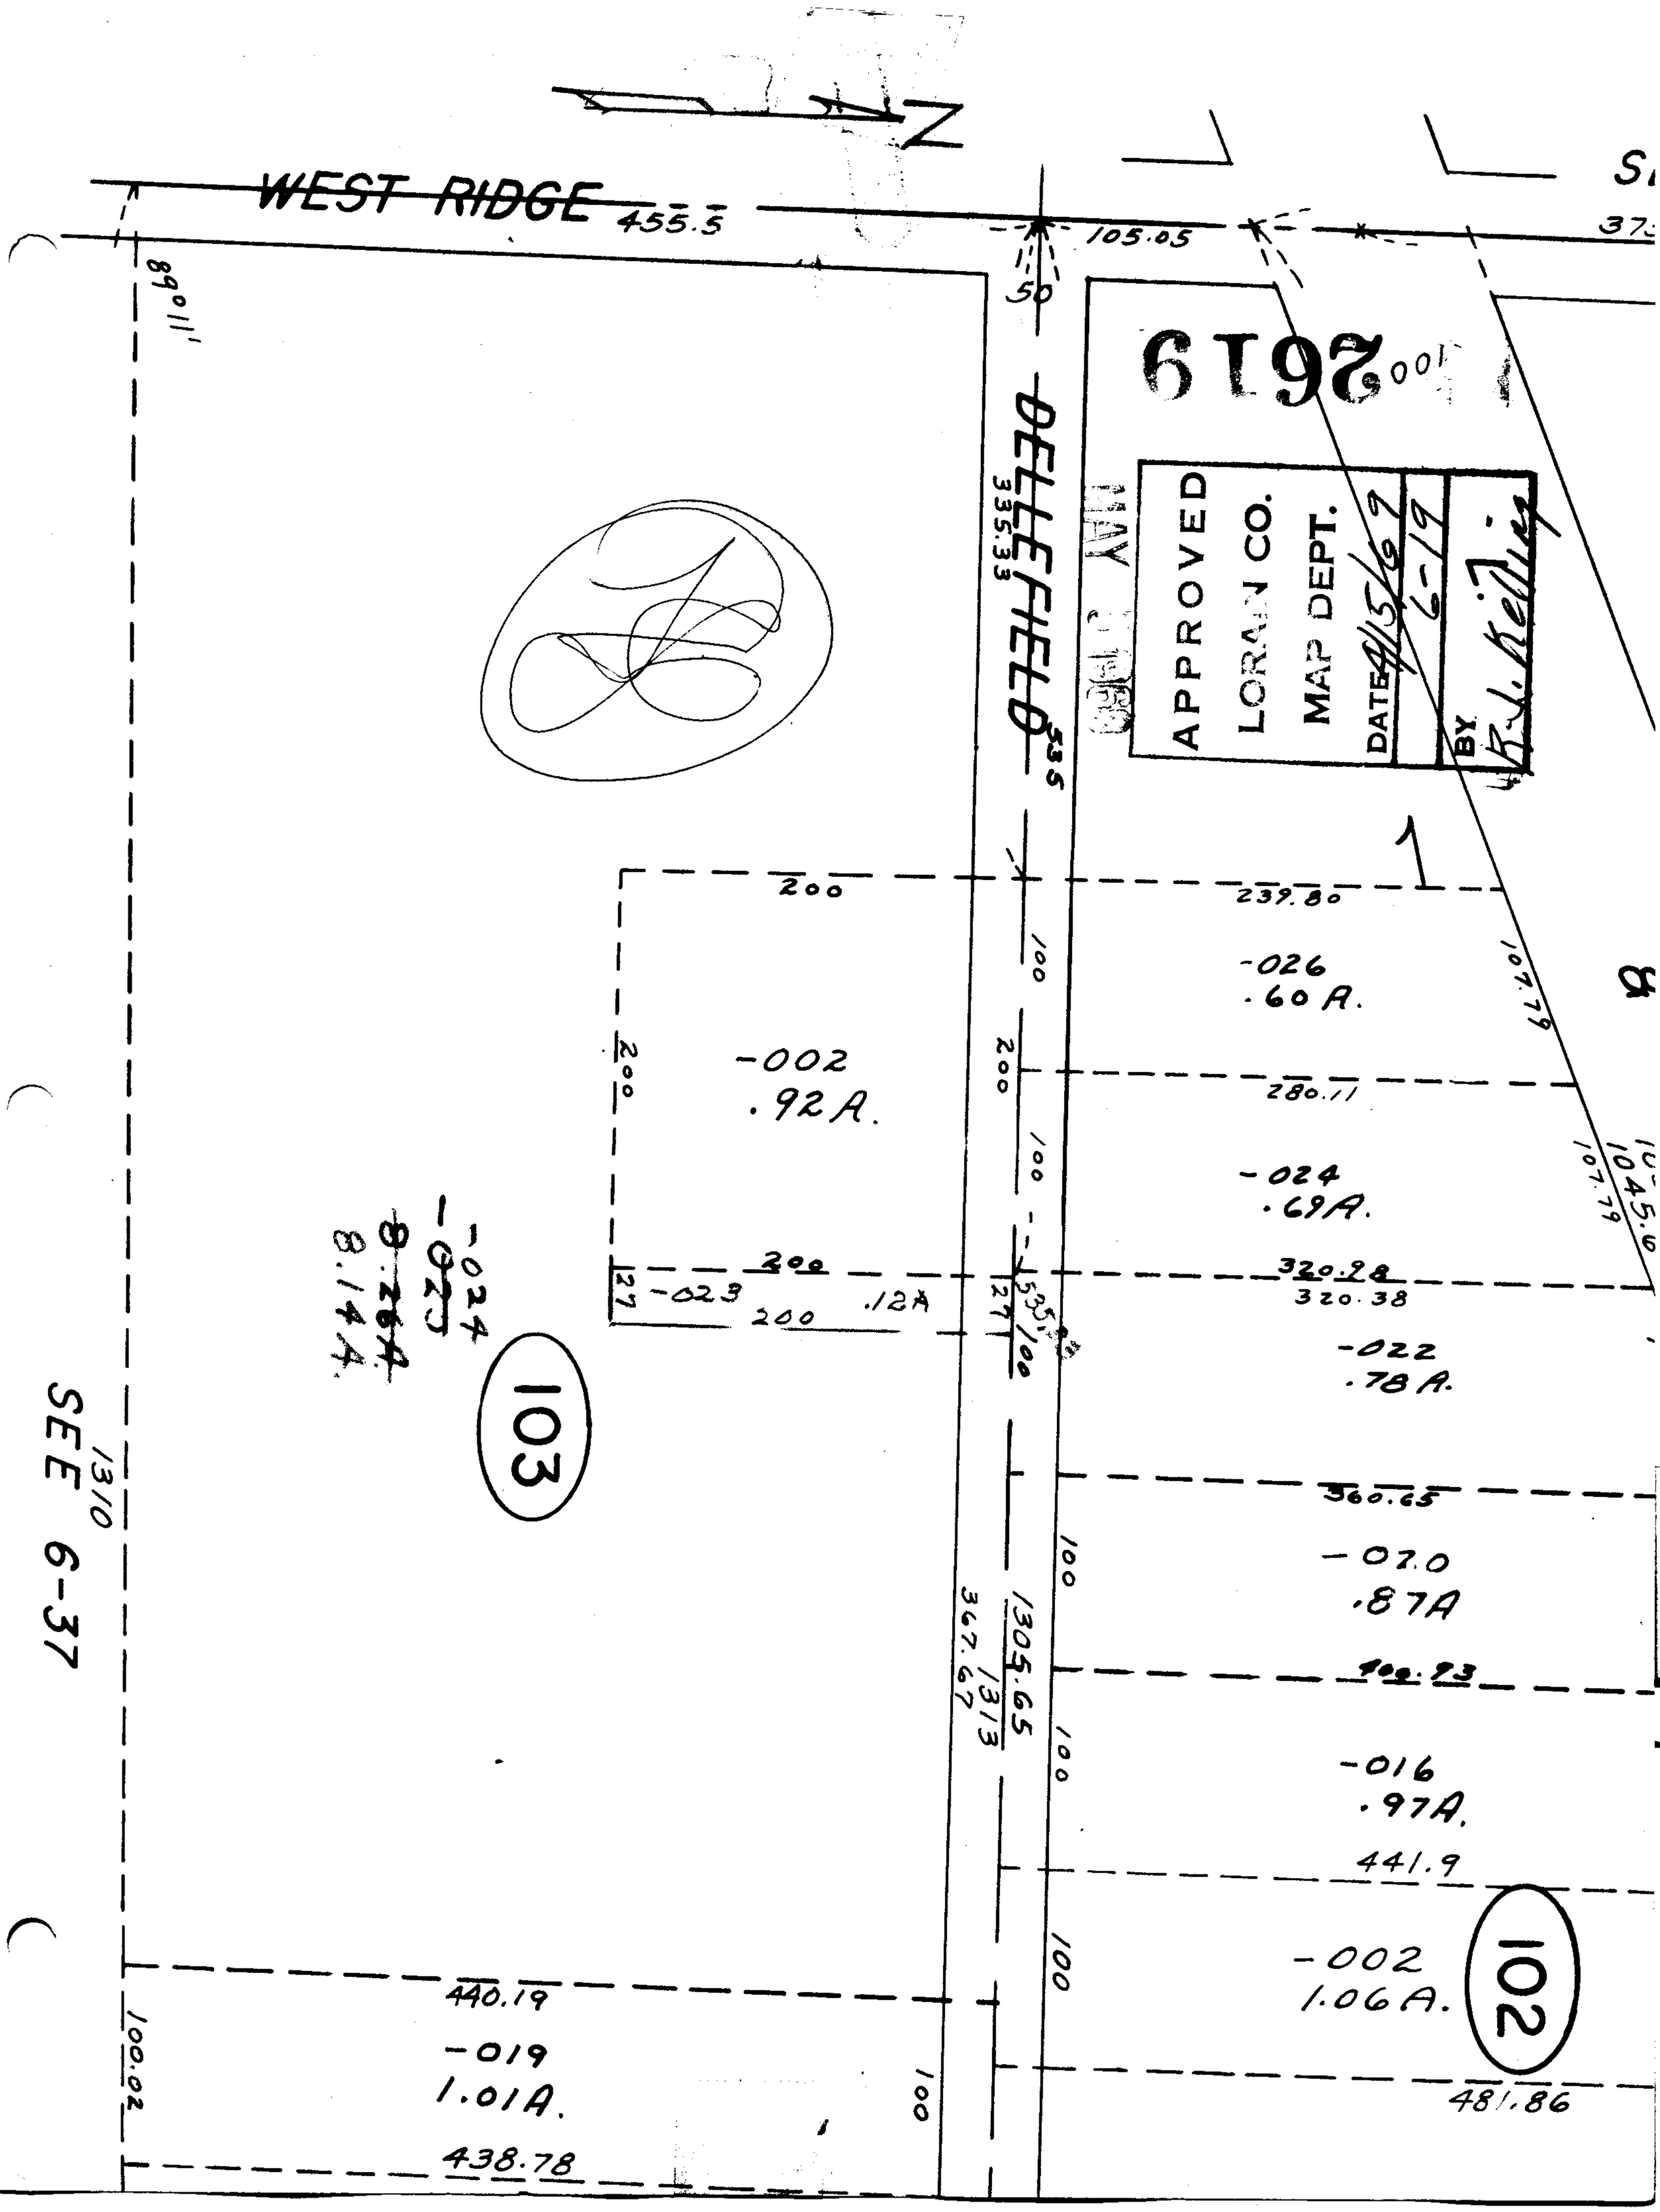

WEST RIDGE
455.5
105.05
50
89°11'
DELLEFIELD
335.33
535
APPROVED
LORAN CO.
MAP DEPT.
DATE 4/15/69
6-19
BY
2619
200
239.80
-026
.60 A.
-002
.92 A.
280.11
-024
.69A.
-023
.12A
320.98
320.38
-022
.78 A.
-024
8.14A.
103
360.65
-020
.87A
1305.65
1313
367.67
400.93
-016
.97A.
441.9
-002
1.06A.
102
440.19
-019
1.01A.
100.02
438.78
481.86
1310
SEE 6-37