


APPROVED  
 LORAIN CO.  
 MAP DEPT.  
 DATE 4/15/69  
 12-00-015-A  
 BY R.J. Kelling

2622

7-25-66  
 S.S.

12-00-016-A

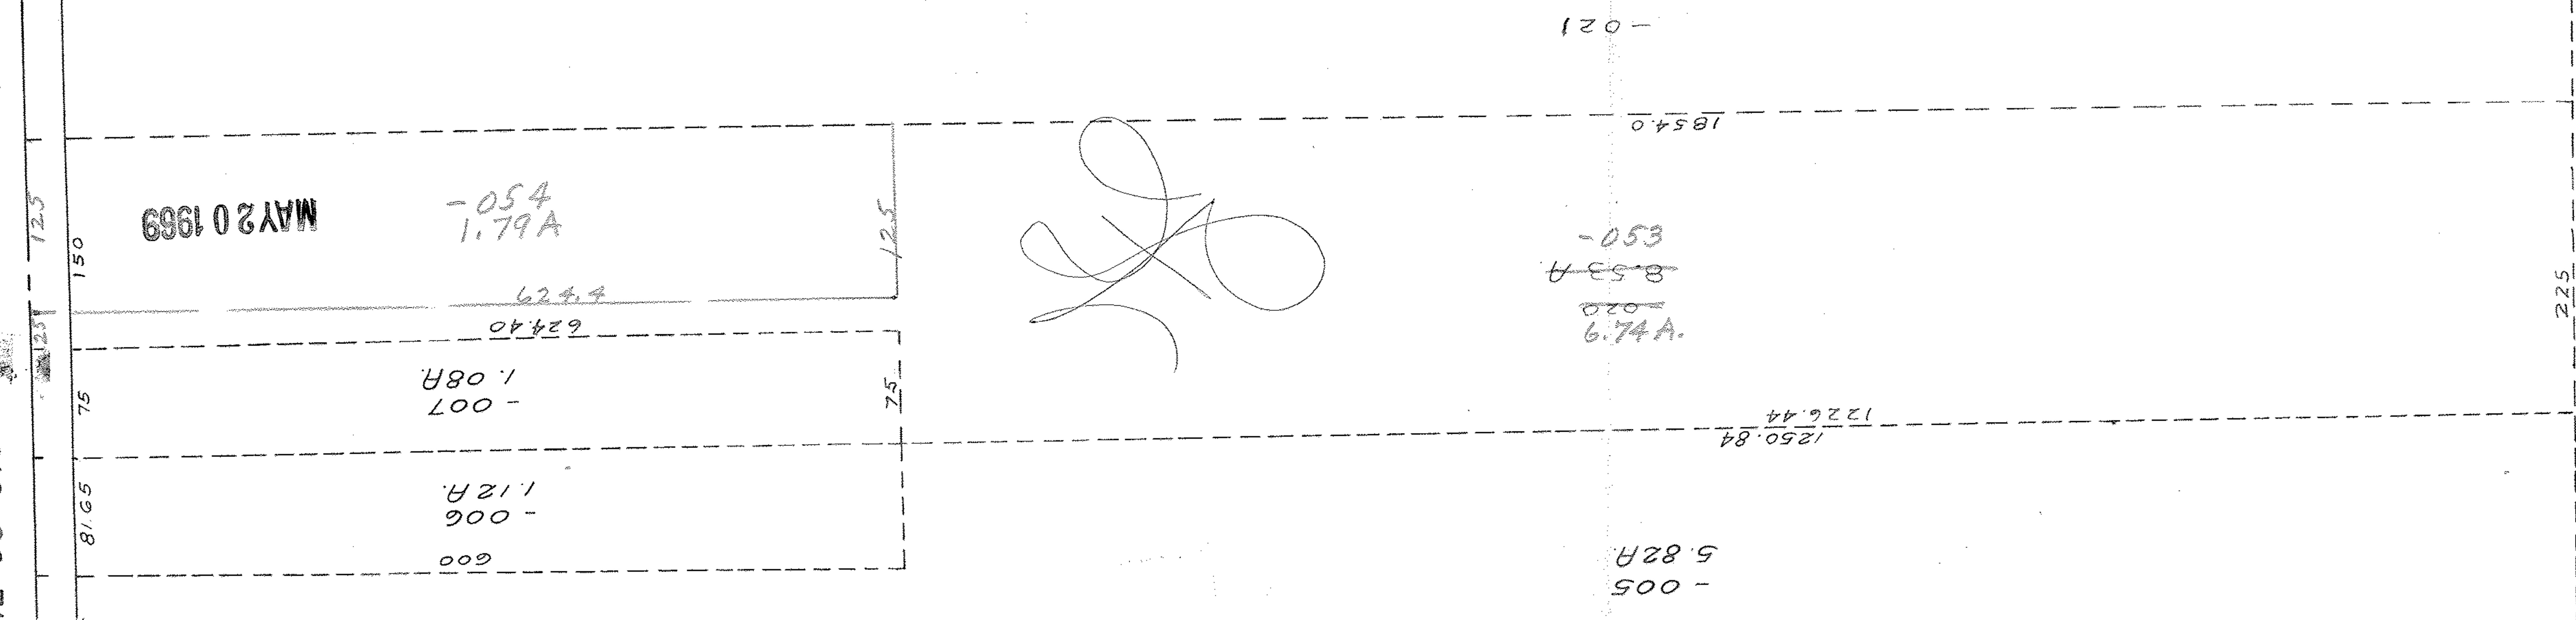

1472.11

11