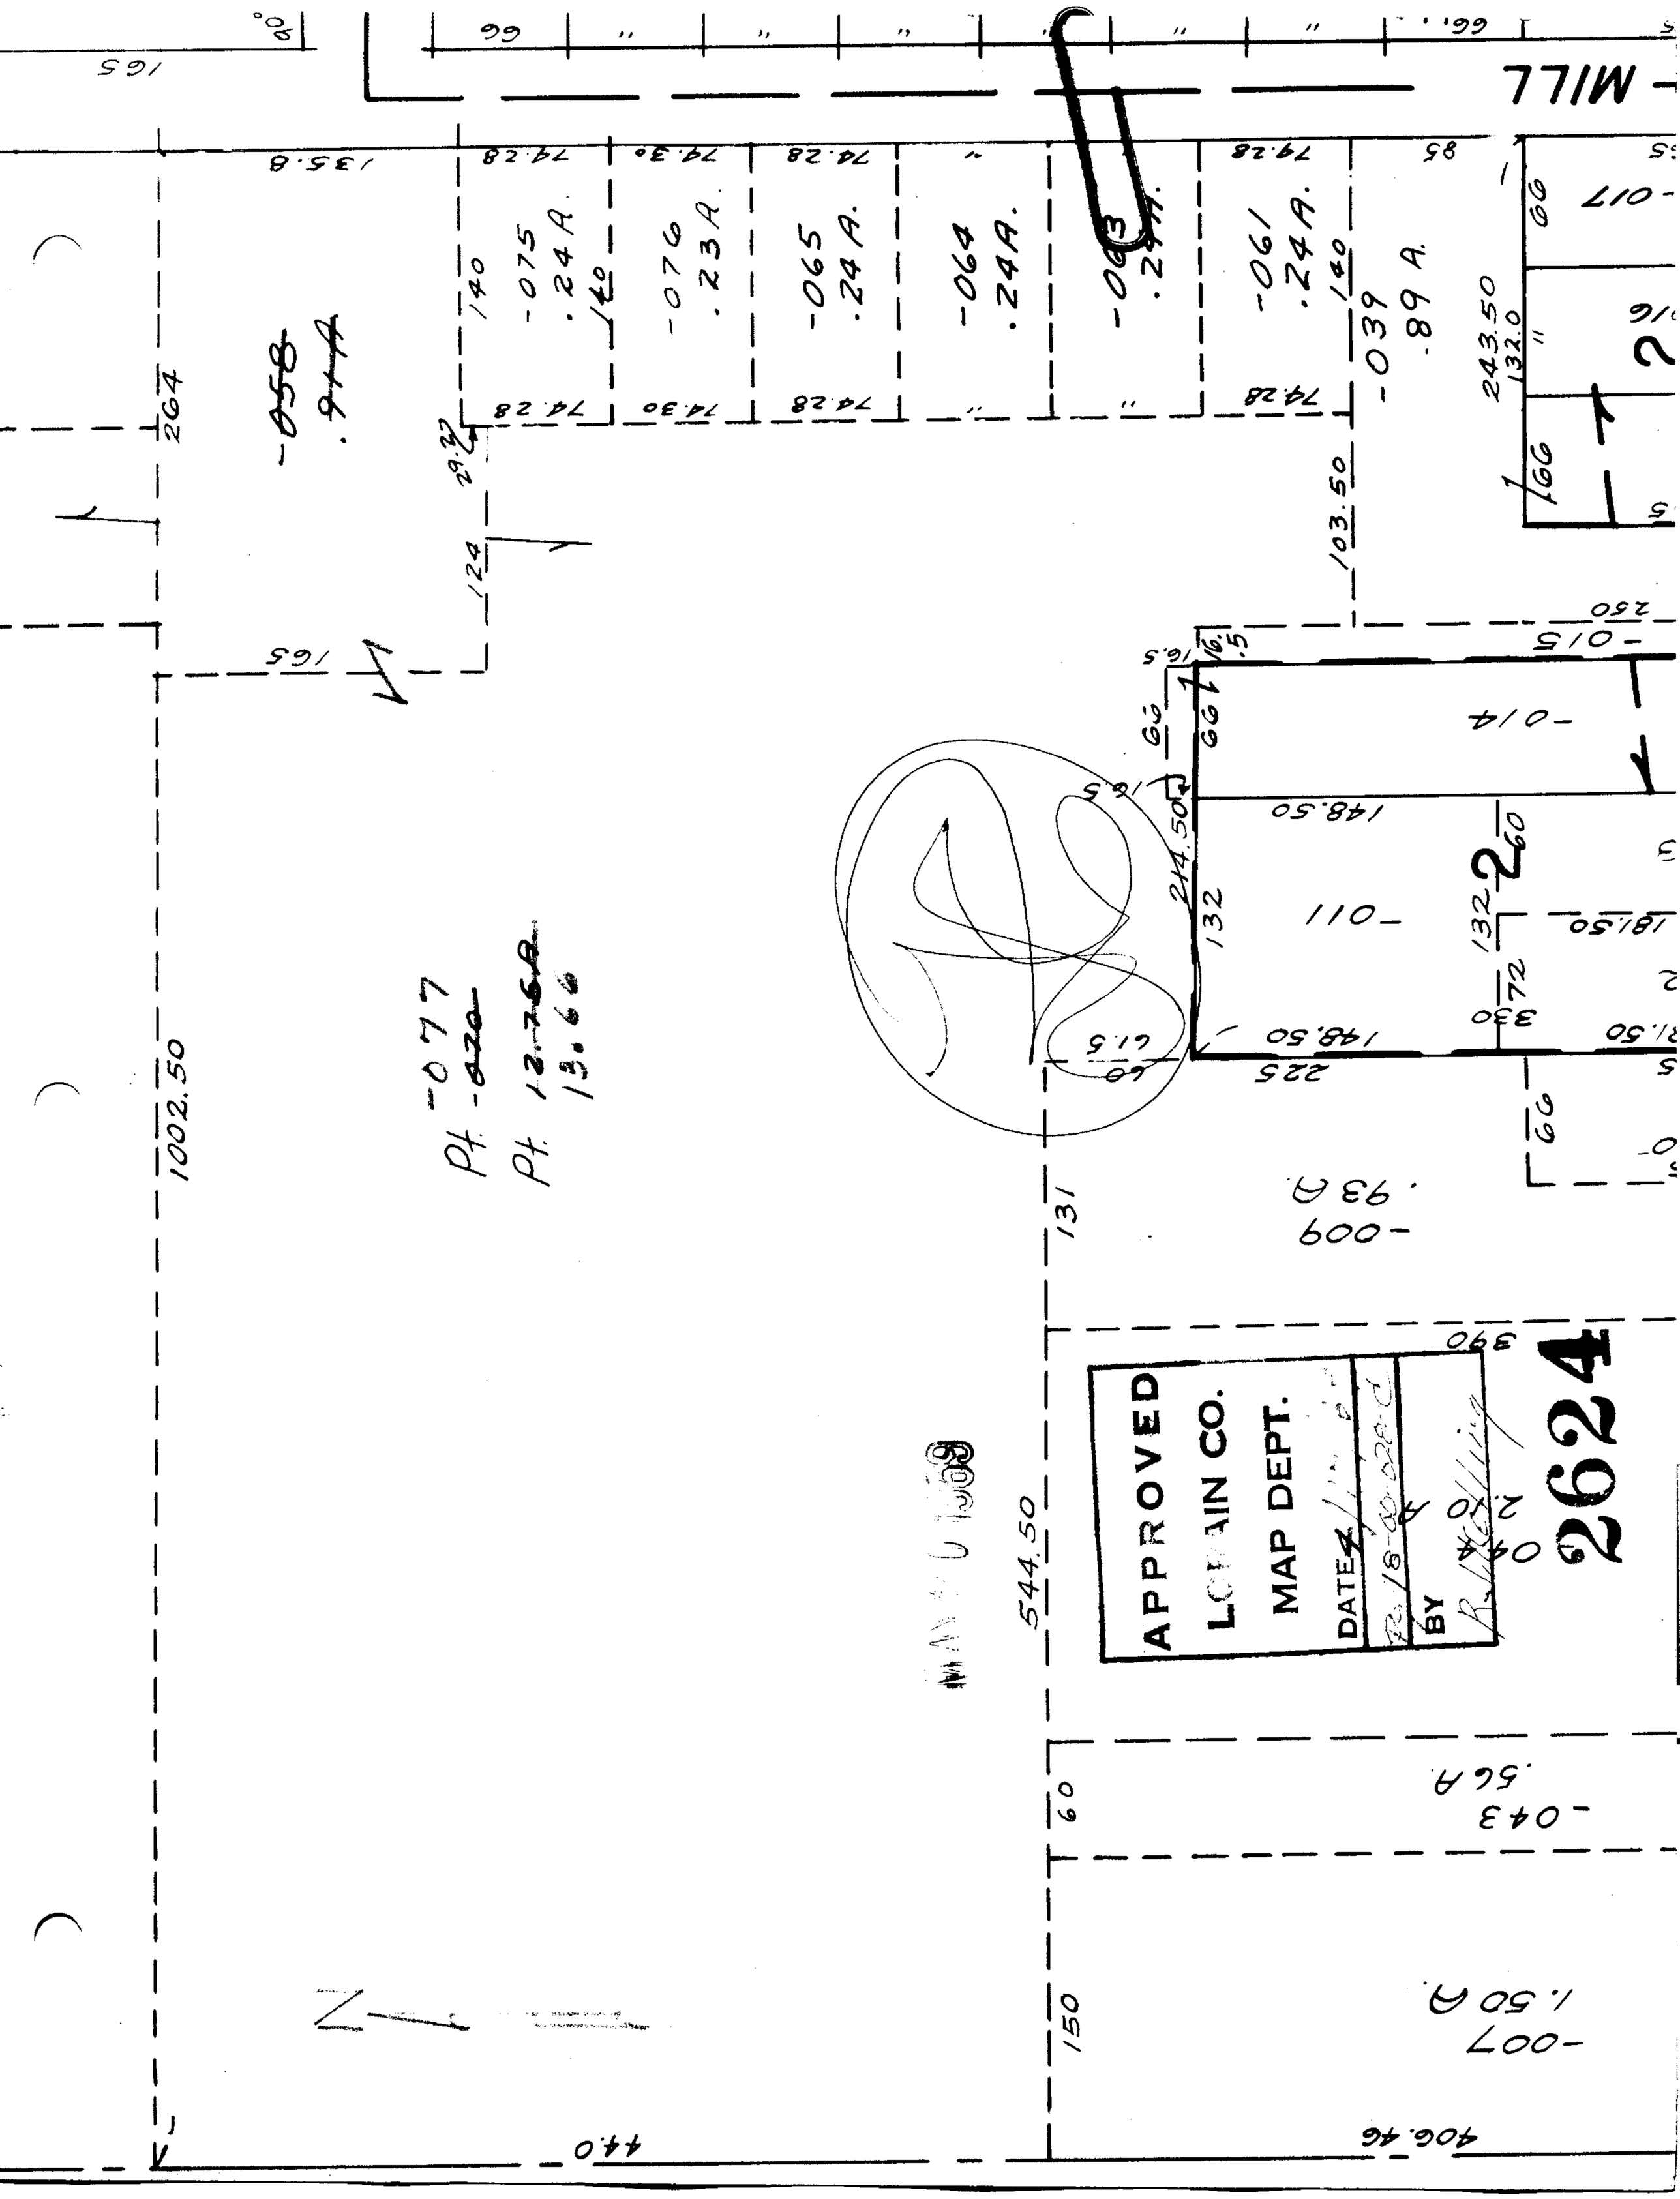

MILL
-075
.24 A.
-076
.23 A.
-065
.24 A.
-064
.24 A.
-061
.24 A.
-039
.89 A.
-058
.91 A
-014
-011
-015
-009
.93 A.
-043
.56 A.
-007
1.50 A.
Pt. -077
Pt. -020
13.66
1002.50
544.50
440
406.46
APPROVED
LORAIN CO.
MAP DEPT.
DATE
BY
2624