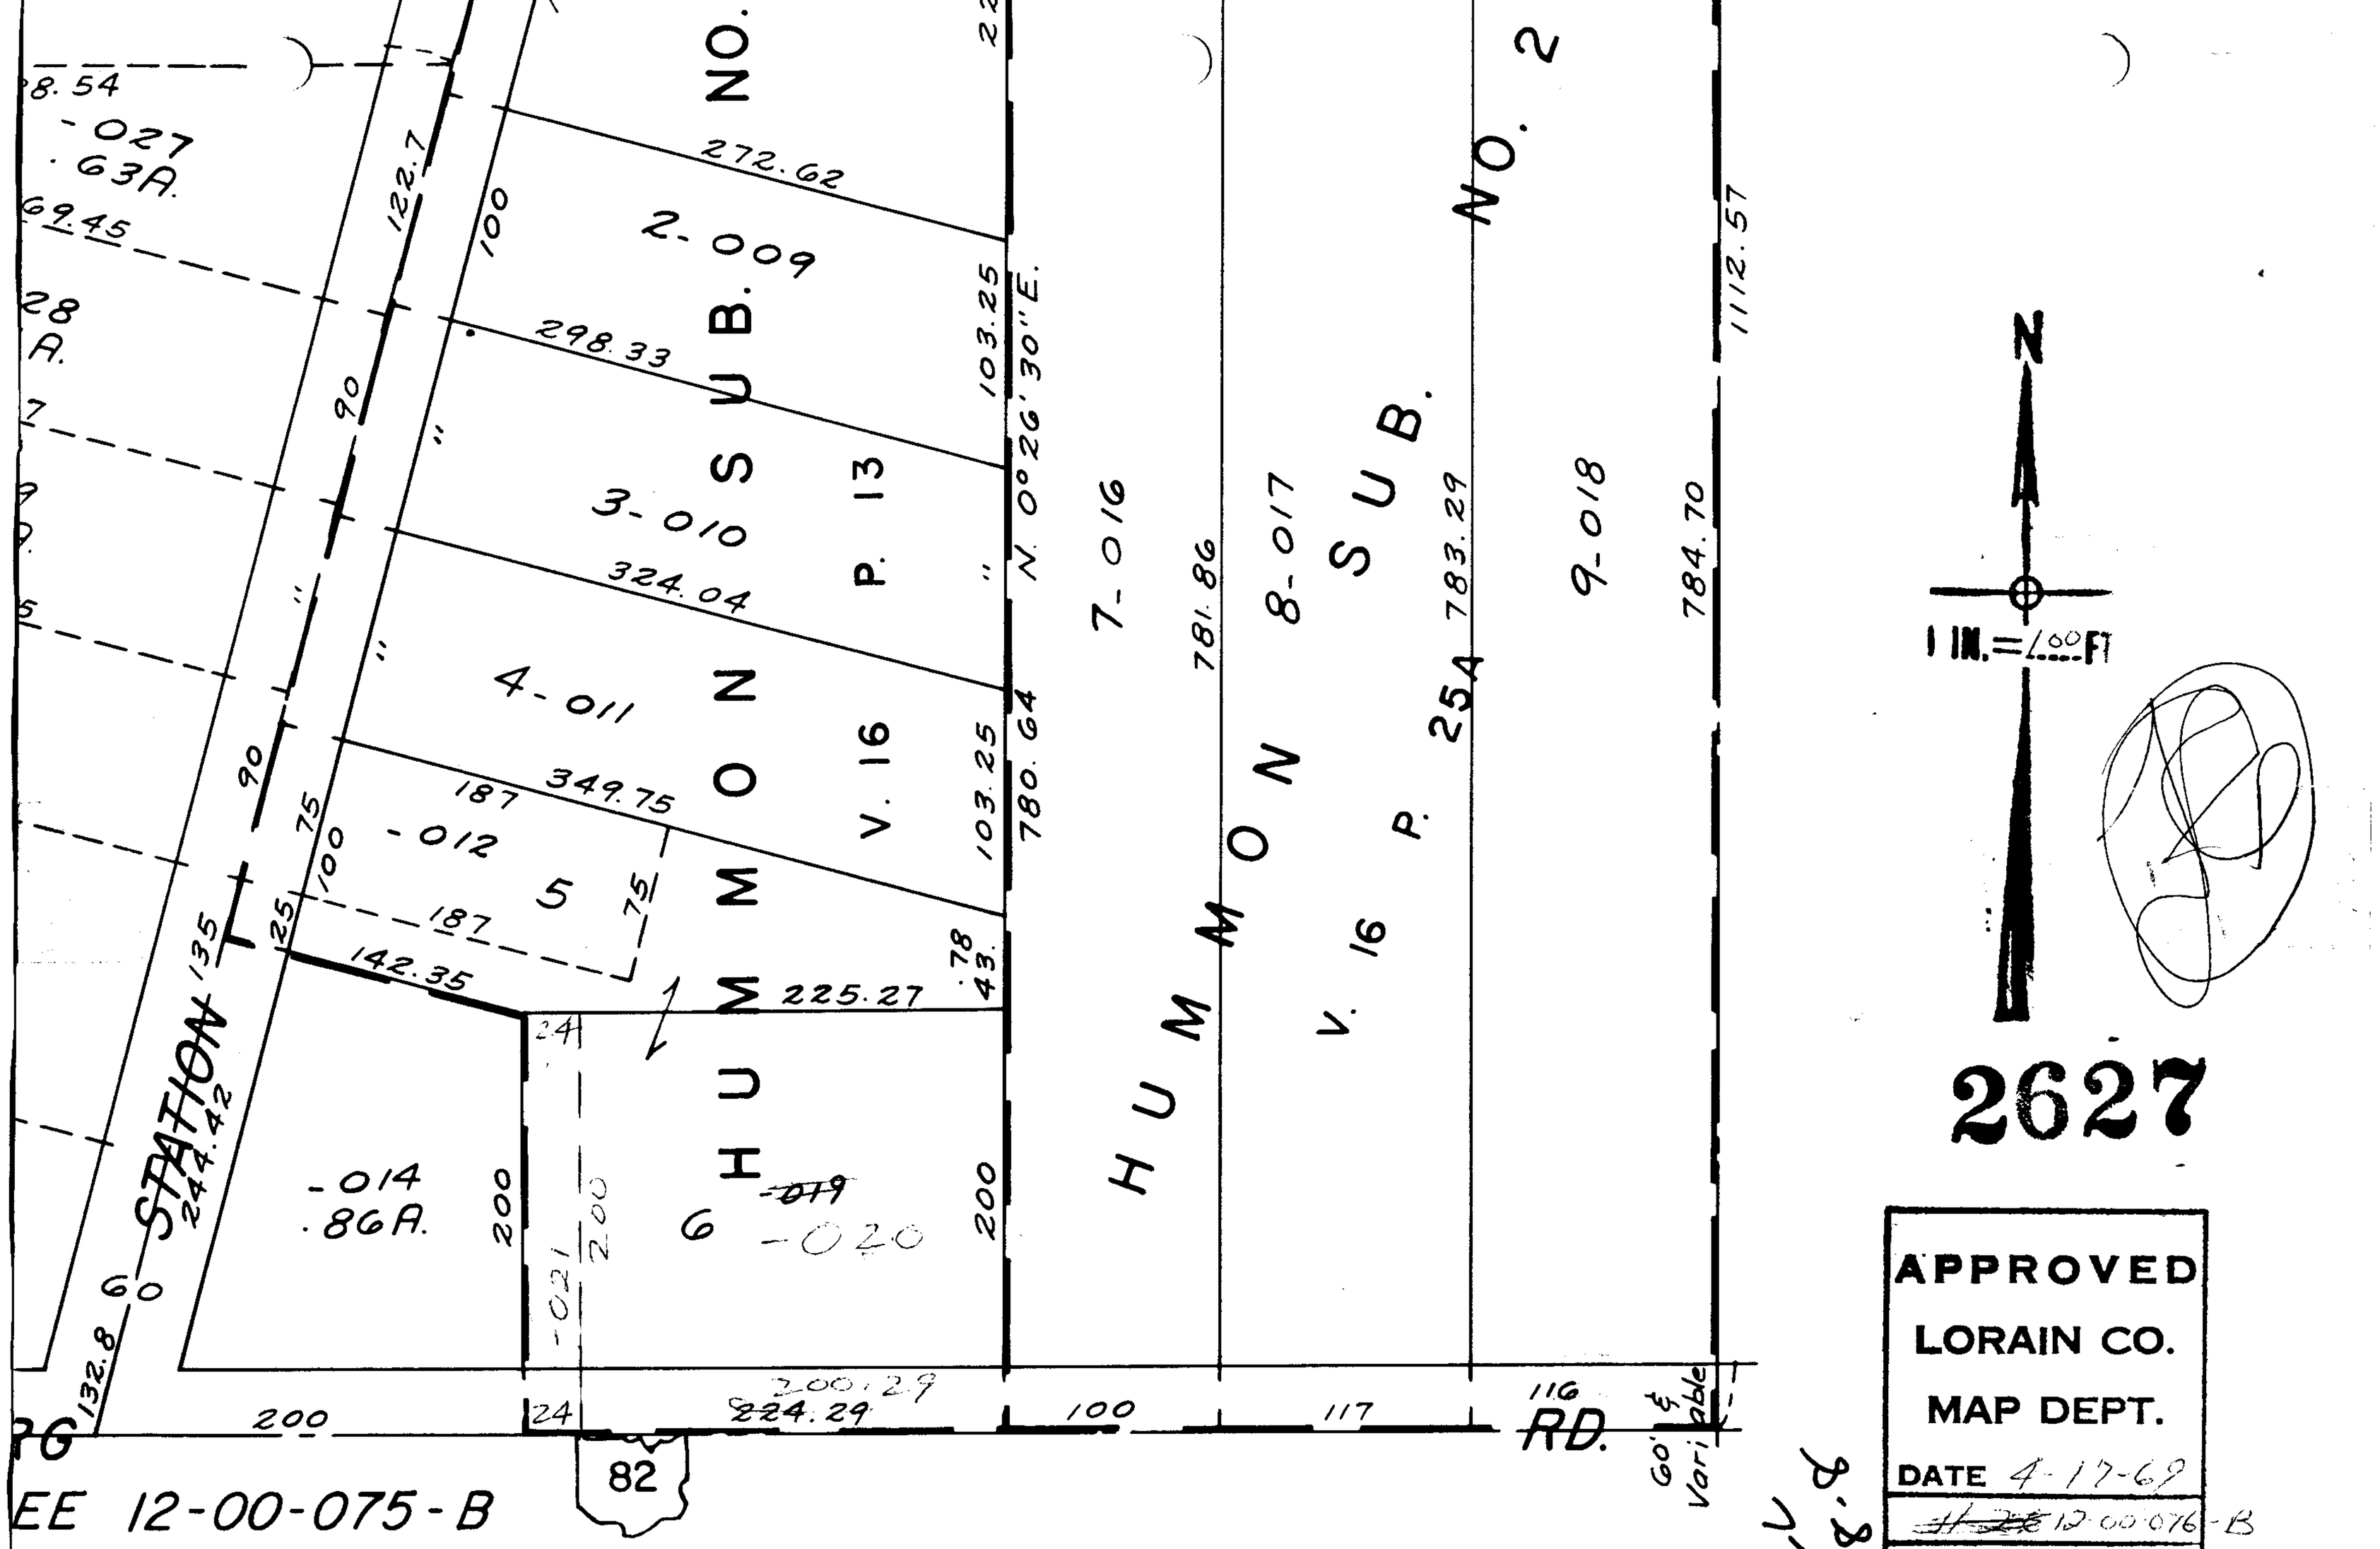

2627

APPROVED
LORAIN CO.
MAP DEPT.
DATE 4-17-69
~~11-28~~ 12-00-076-B
BY

MAY 20 1969

8-8-69
7-25-69

TWP.

FLY PT LOT 76

12