

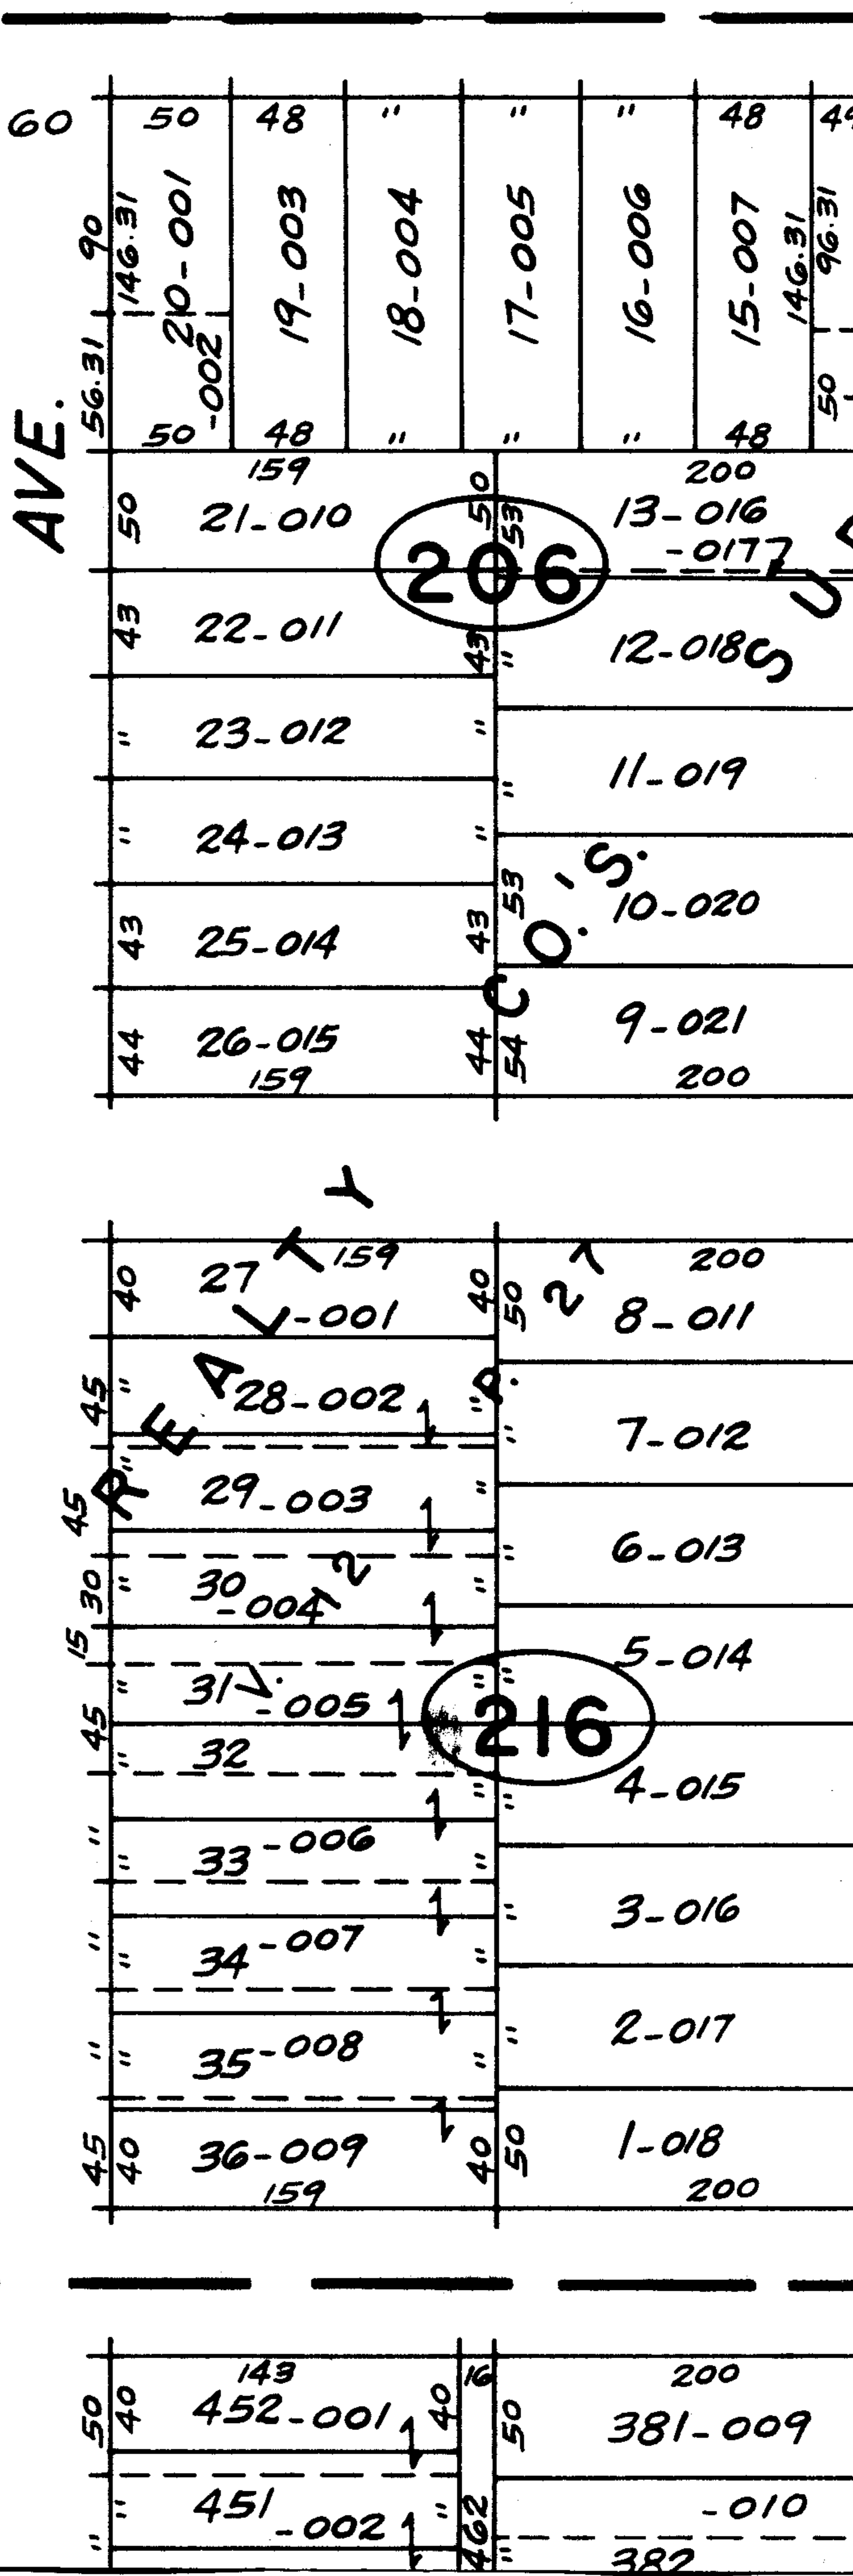


637

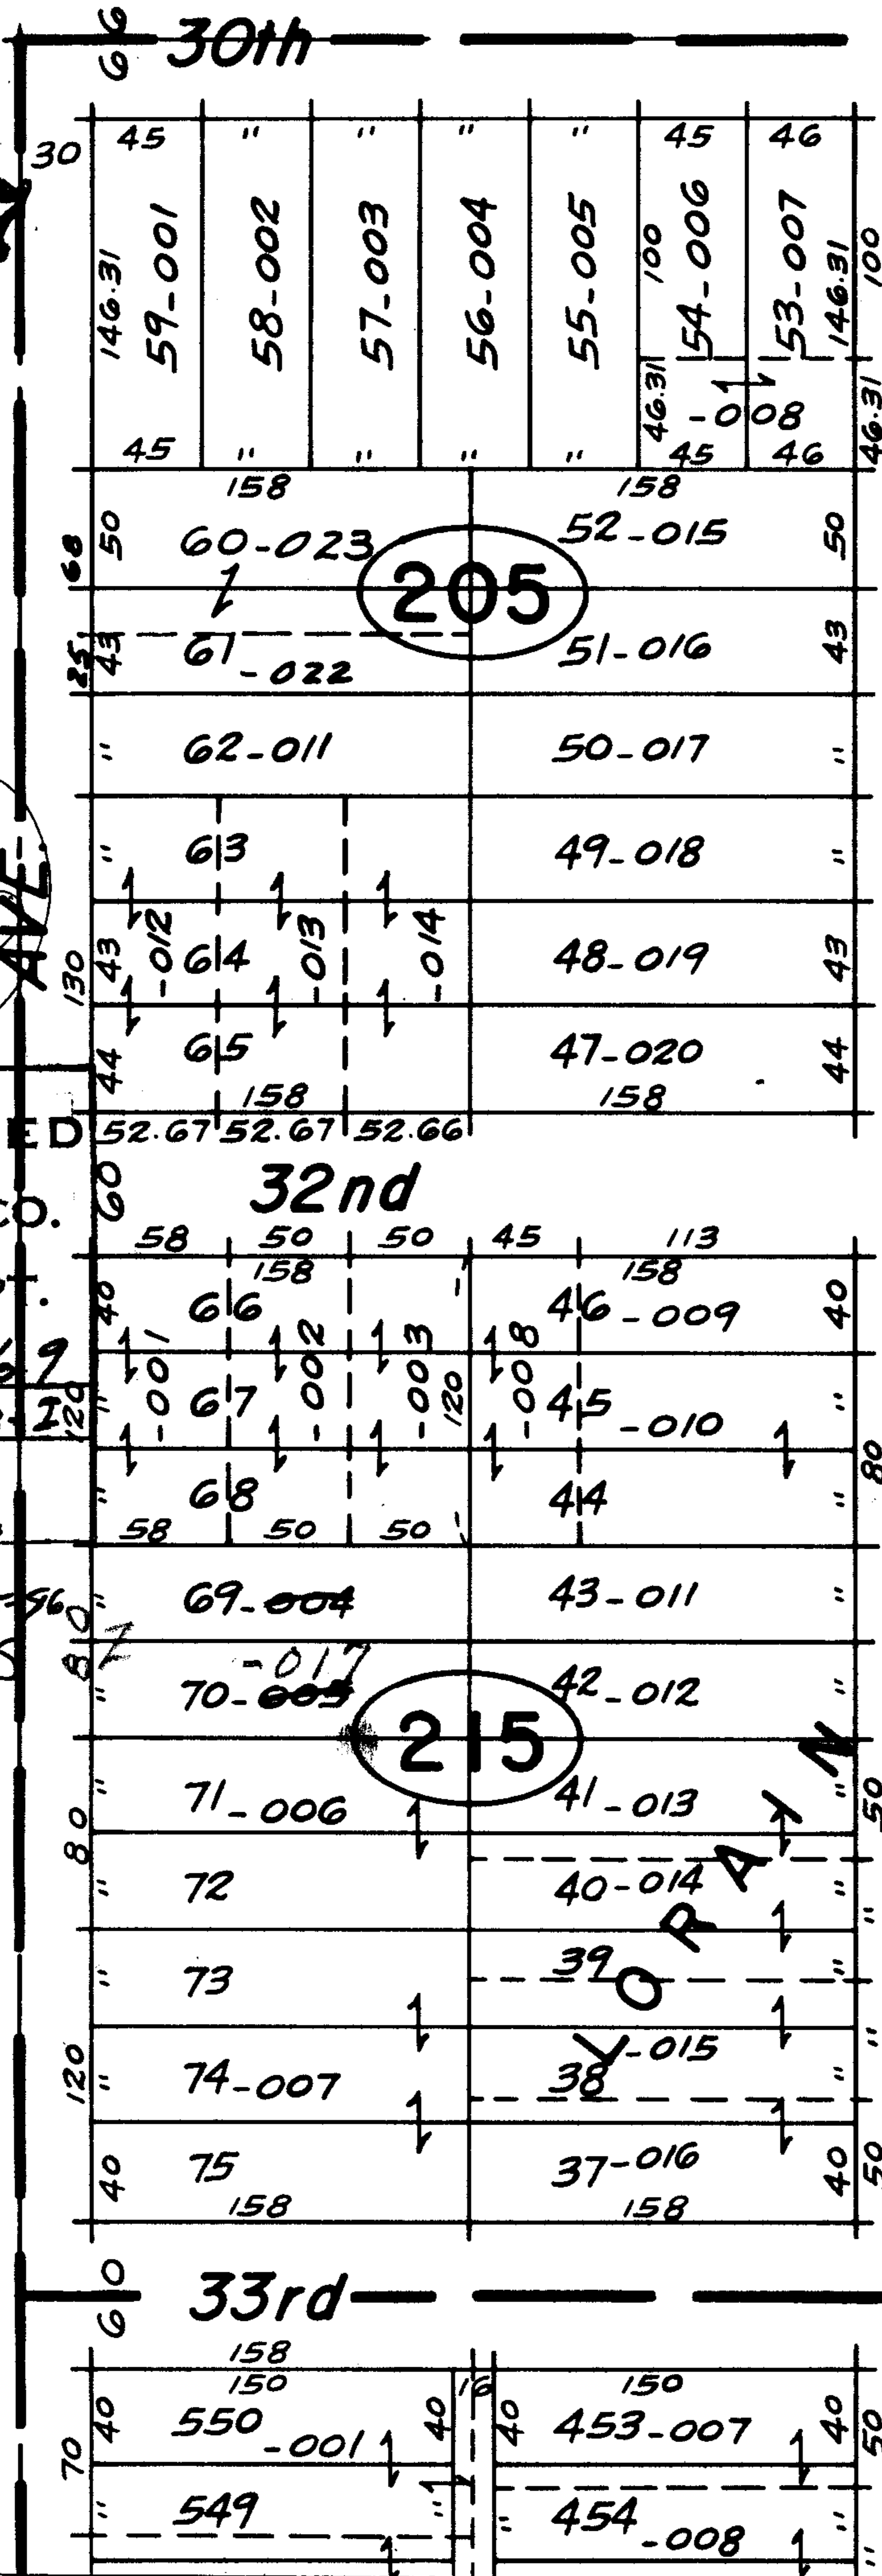

APPROVED
 LORAIN CO.
 MAP DEPT.
 DATE 4/23/69
 BY P. J. Kelling

MAY 9 1969

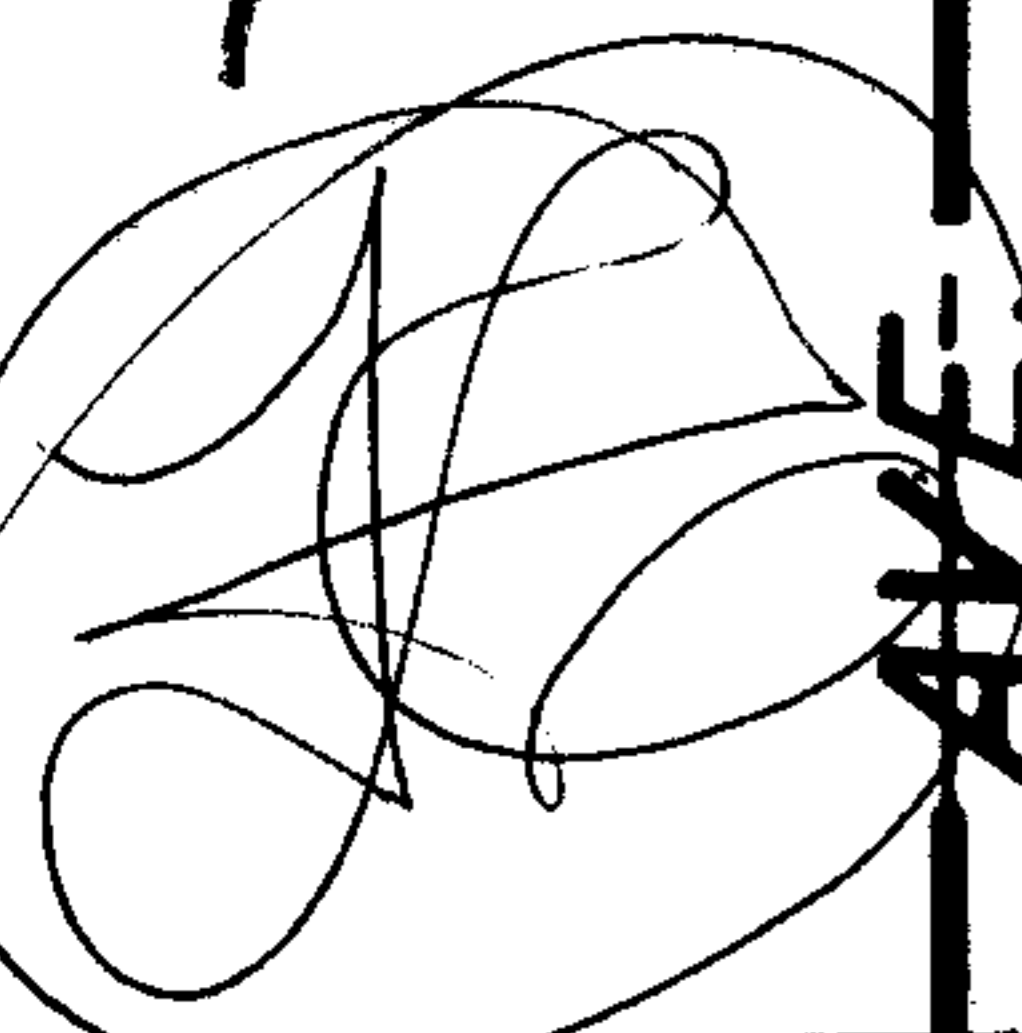

637