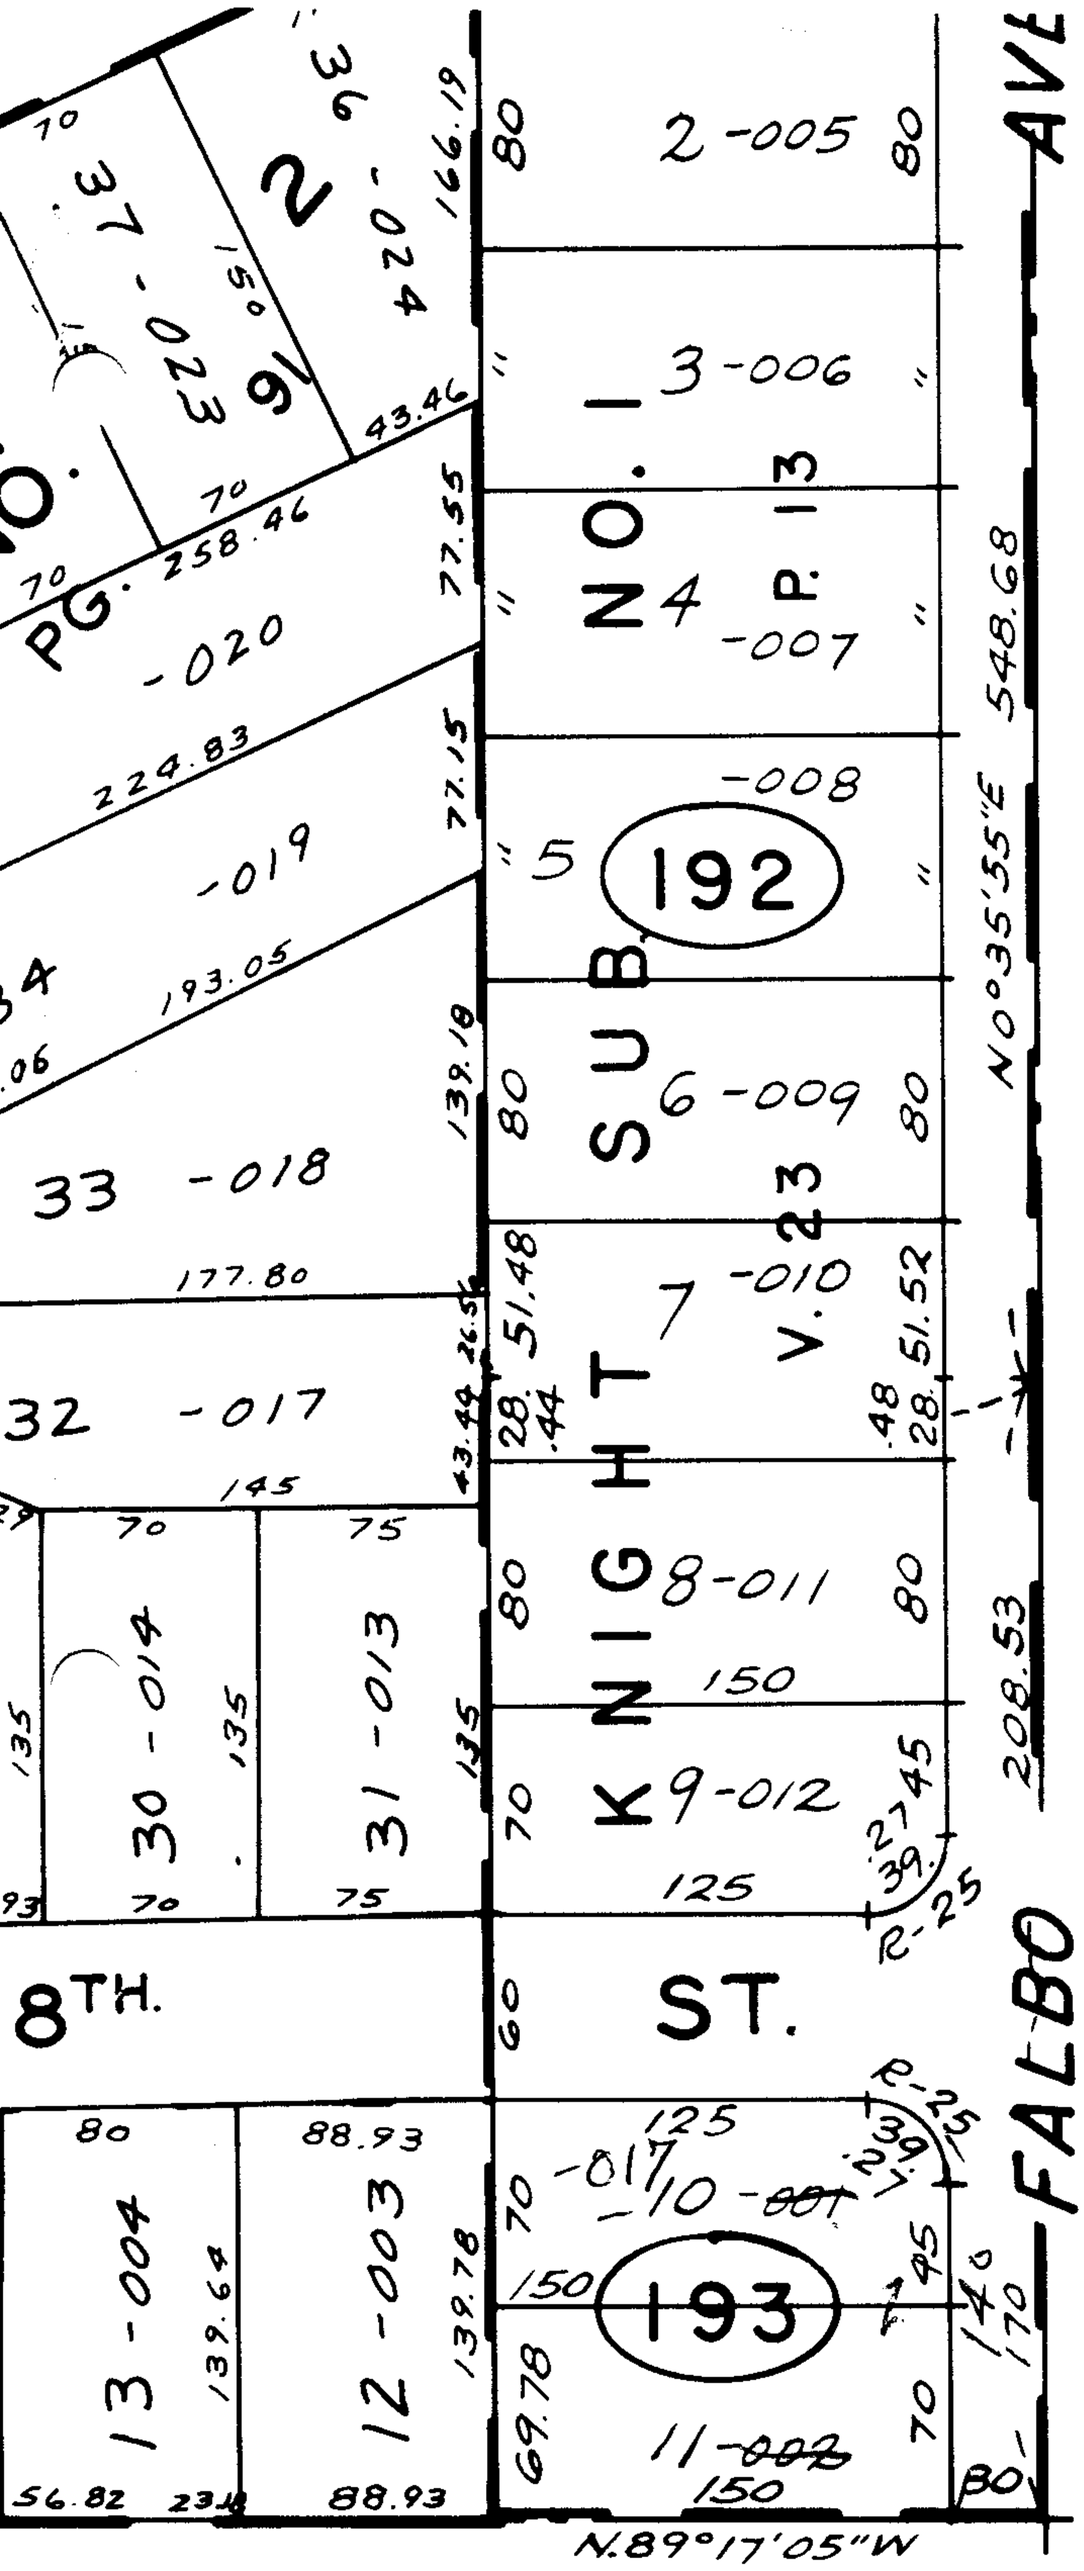

2637

7-15-86 S.S

APPROVED
LORAIN CO.
MAP DEPT.
DATE 4/23/69
2-01-006-H
BY
R.V. Kellington

RACT 1

T. LOT 6

Copyright 1964

REV 4-29-68

2-01-006-H