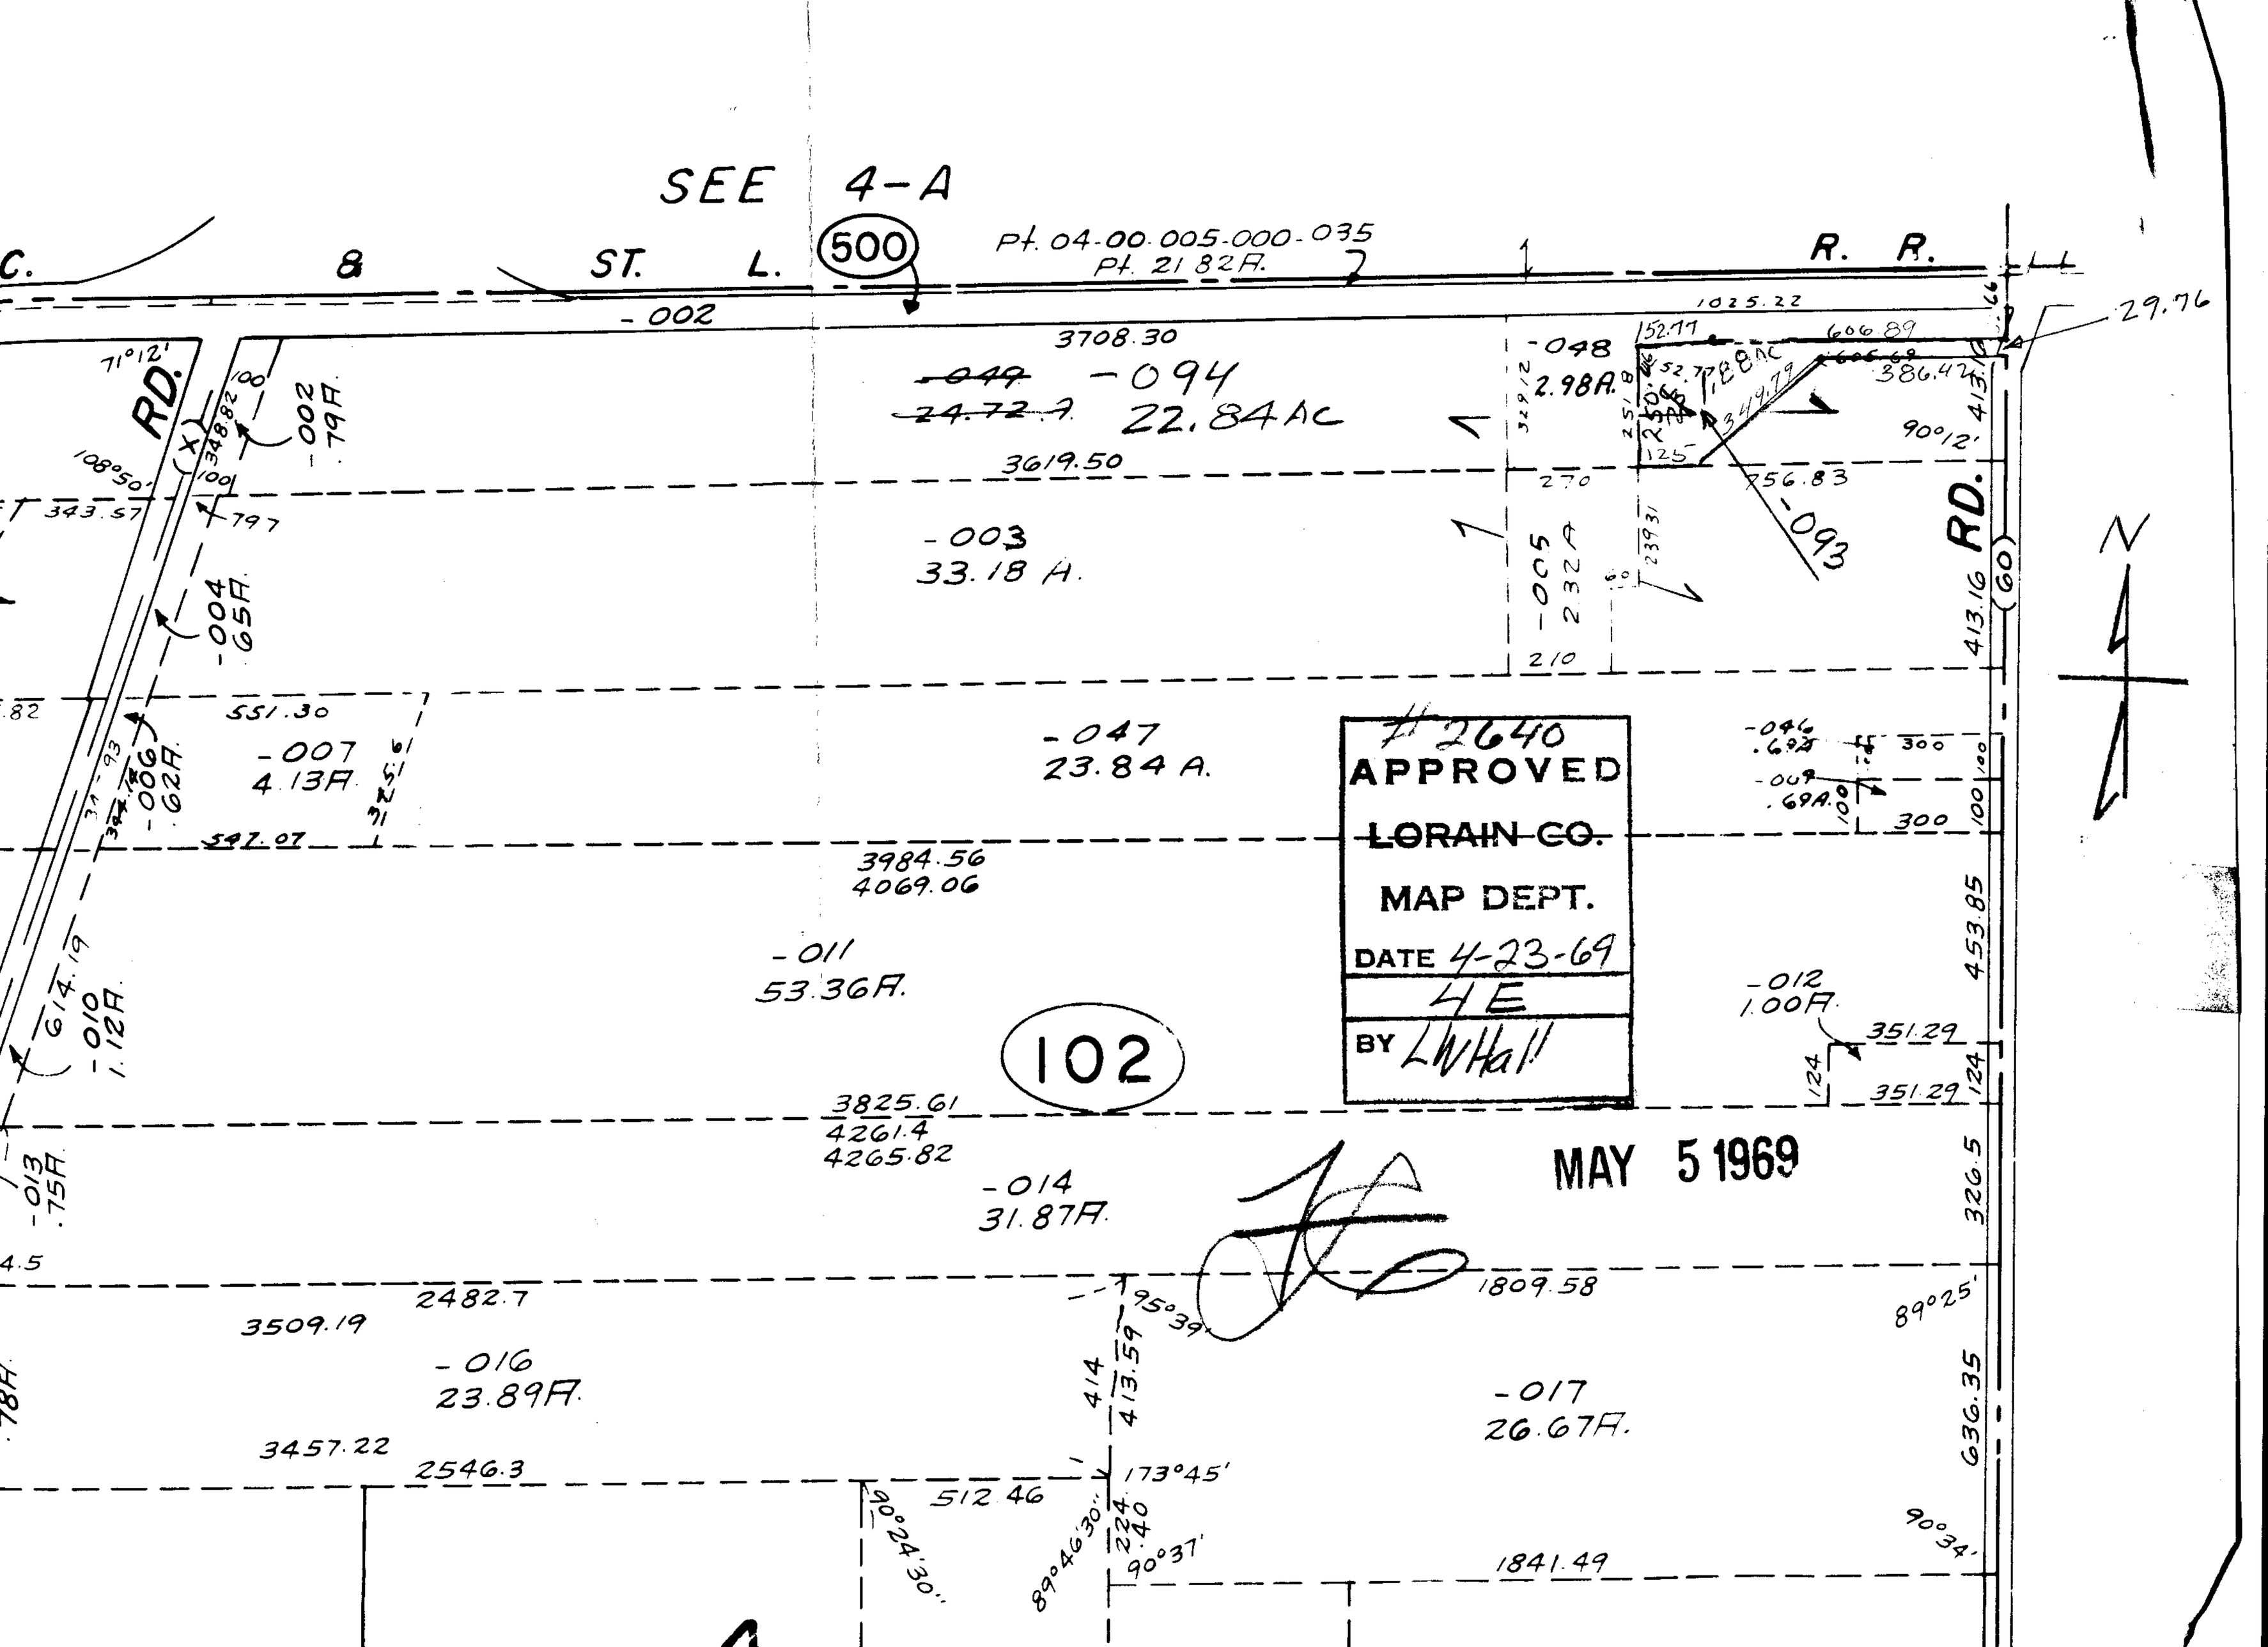
SEE 4-A
C. & ST. L. R. R.
500
Pt. 04-00-005-000-035
Pt. 21.82A.
-002
3708.30
-049
24.72 A.
-094
22.84 AC
3619.50
-003
33.18 A.
-048
2.98A.
-005
2.32A
-093
1025.22
29.76
606.89
386.42
90°12'
756.83
413.16
RD.
(60)
N
71°12'
108°50'
343.57
-002
.79A.
-004
.65A.
551.30
-007
4.13A.
-006
.62A.
547.07
-047
23.84 A.
3984.56
4069.06
-011
53.36A.
-046
.69A.
-009
.69A.
300
453.85
-012
1.00A.
351.29
124
102
3825.61
4261.4
4265.82
-014
31.87A.
-013
.75A.
326.5
2482.7
3509.19
-016
23.89A.
95°39'
1809.58
89°25'
414
413.59
-017
26.67A.
636.35
3457.22
2546.3
173°45'
512.46
90°24'30"
89°46'30"
224.40
90°37'
1841.49
90°34'
614.19
-010
1.12A.
#2640
APPROVED
LORAIN CO.
MAP DEPT.
DATE 4-23-69
4E
BY LWHall
MAY 5 1969