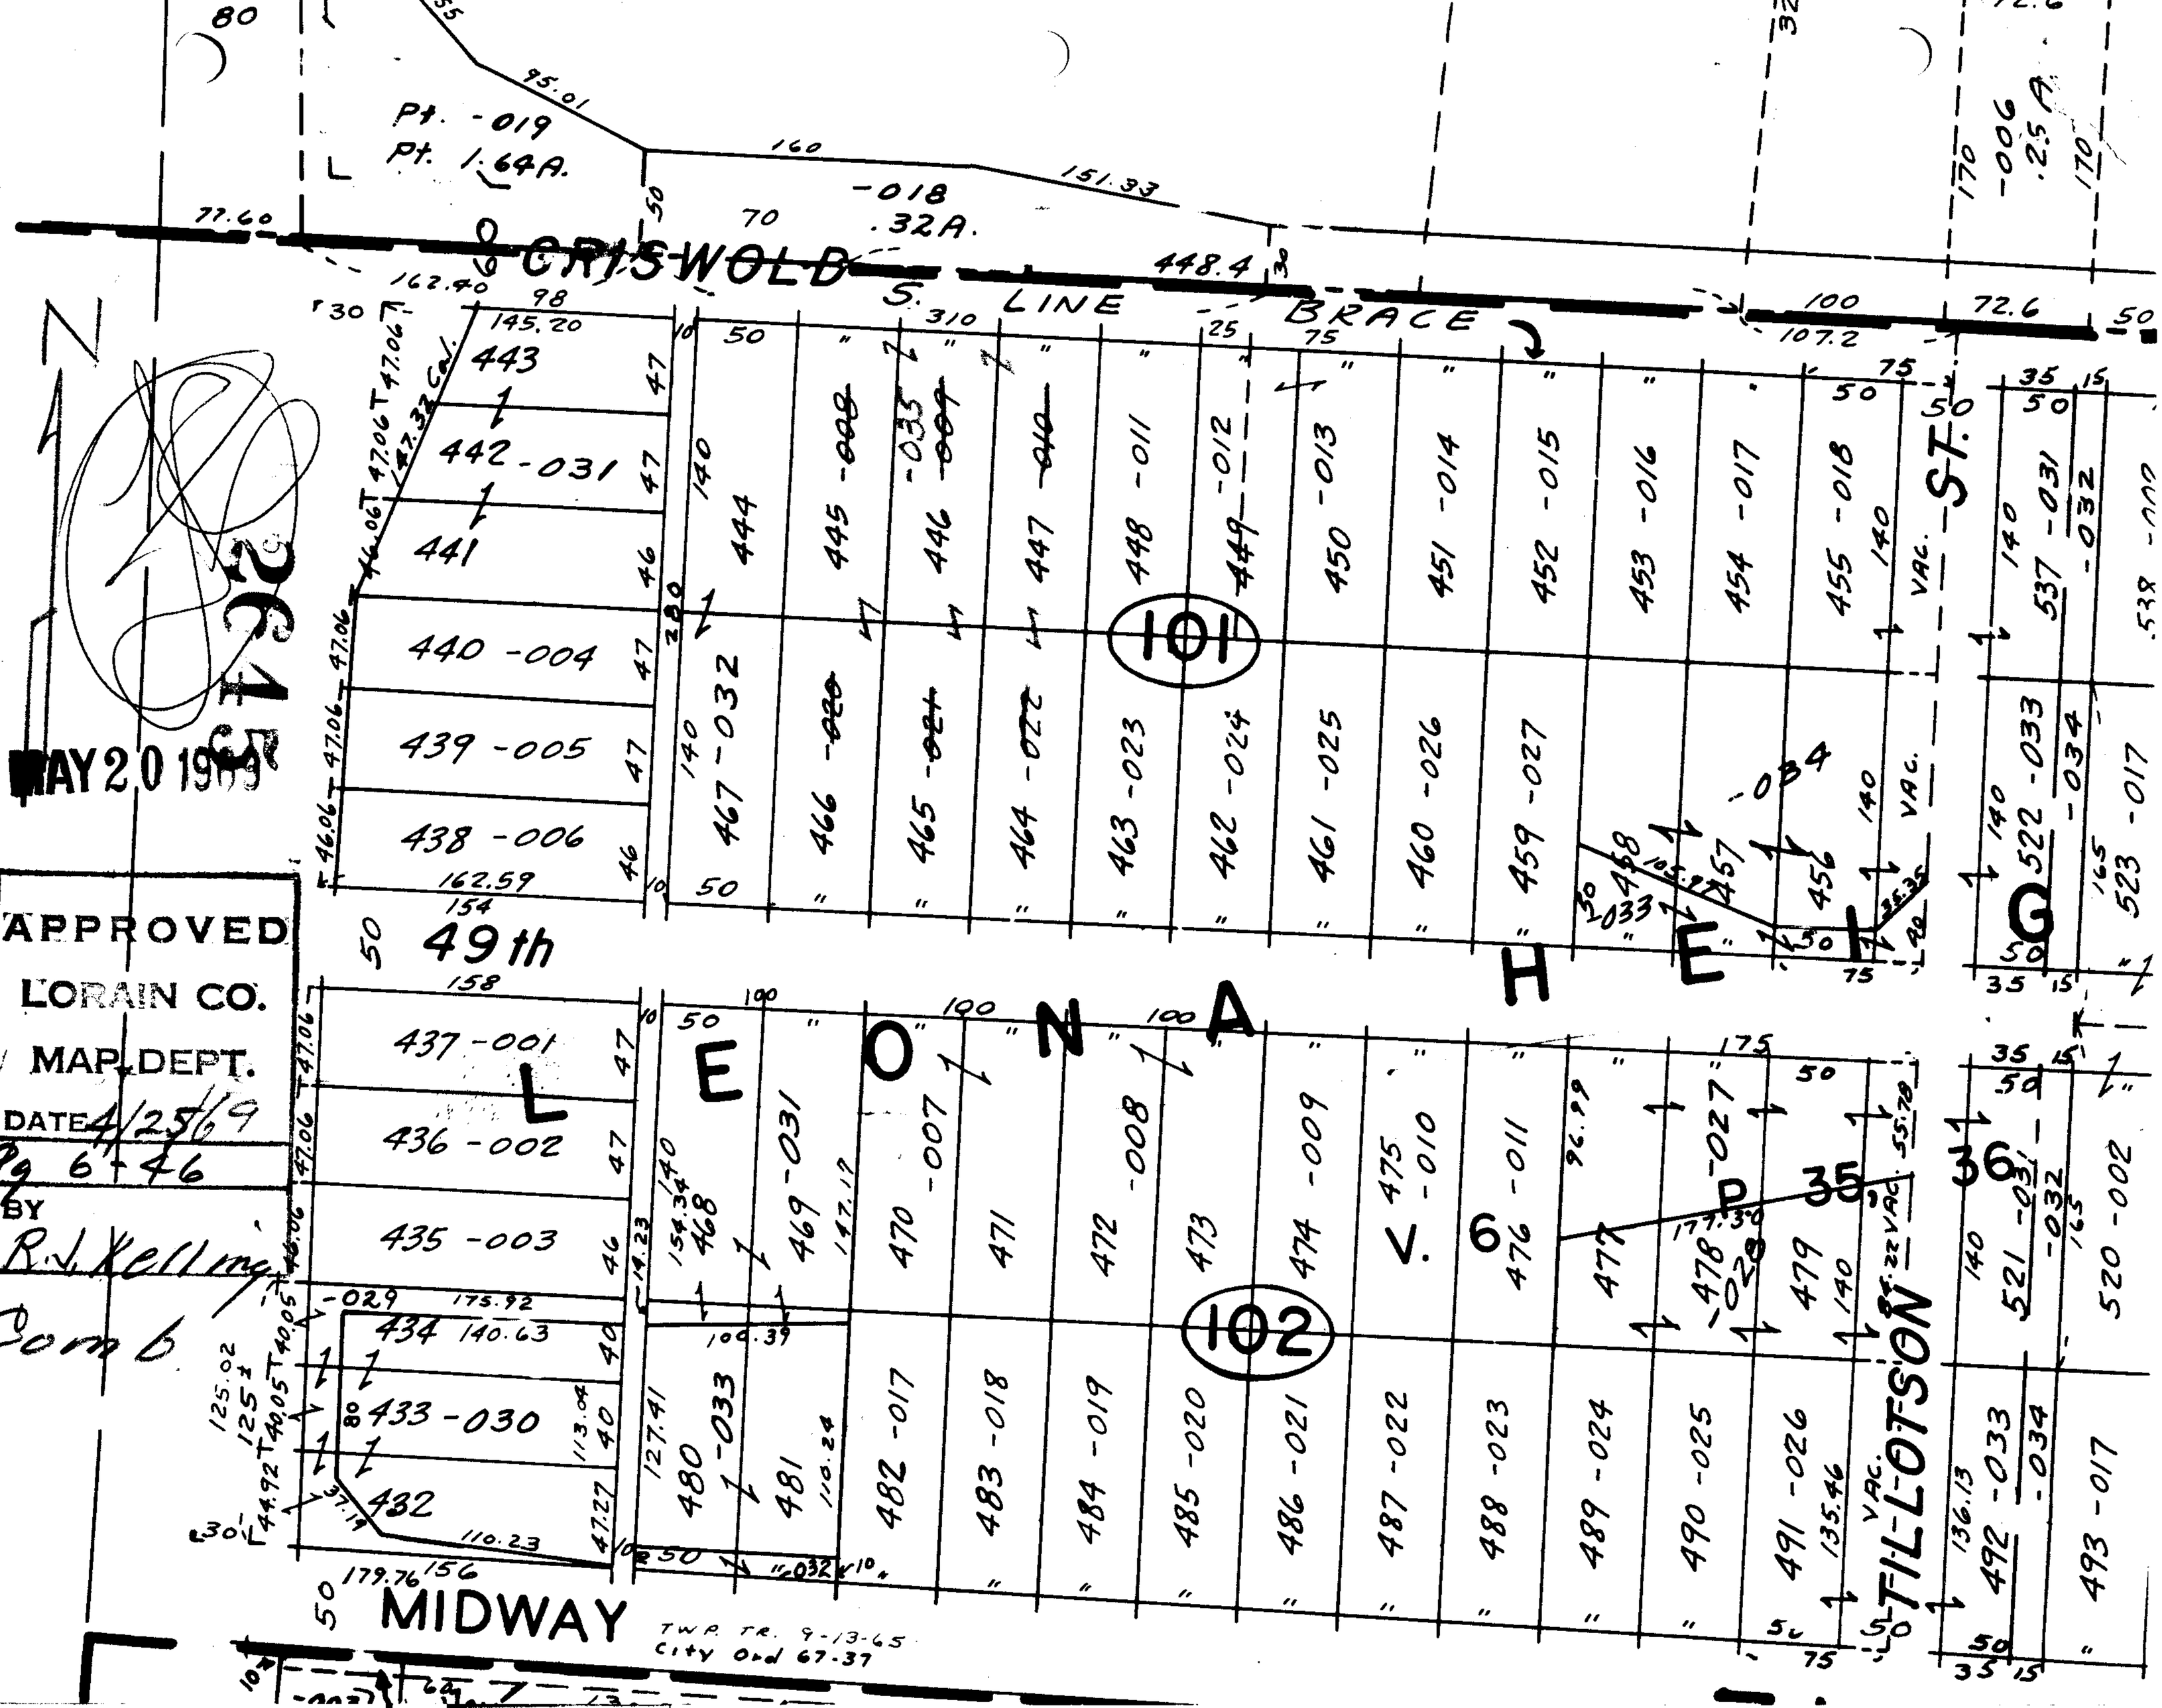

APPROVED
LORAIN CO.
MAP DEPT.
DATE 4/25/69
Pg 6-46
BY R.J. Kelling
Comb

MAY 20 1969

2645