


2F 49

APPROVED
 LORAIN CO.
 MAP DEPT.
 DATE 4/26/69
 BY *R. J. Bell*

MAY 20 1969

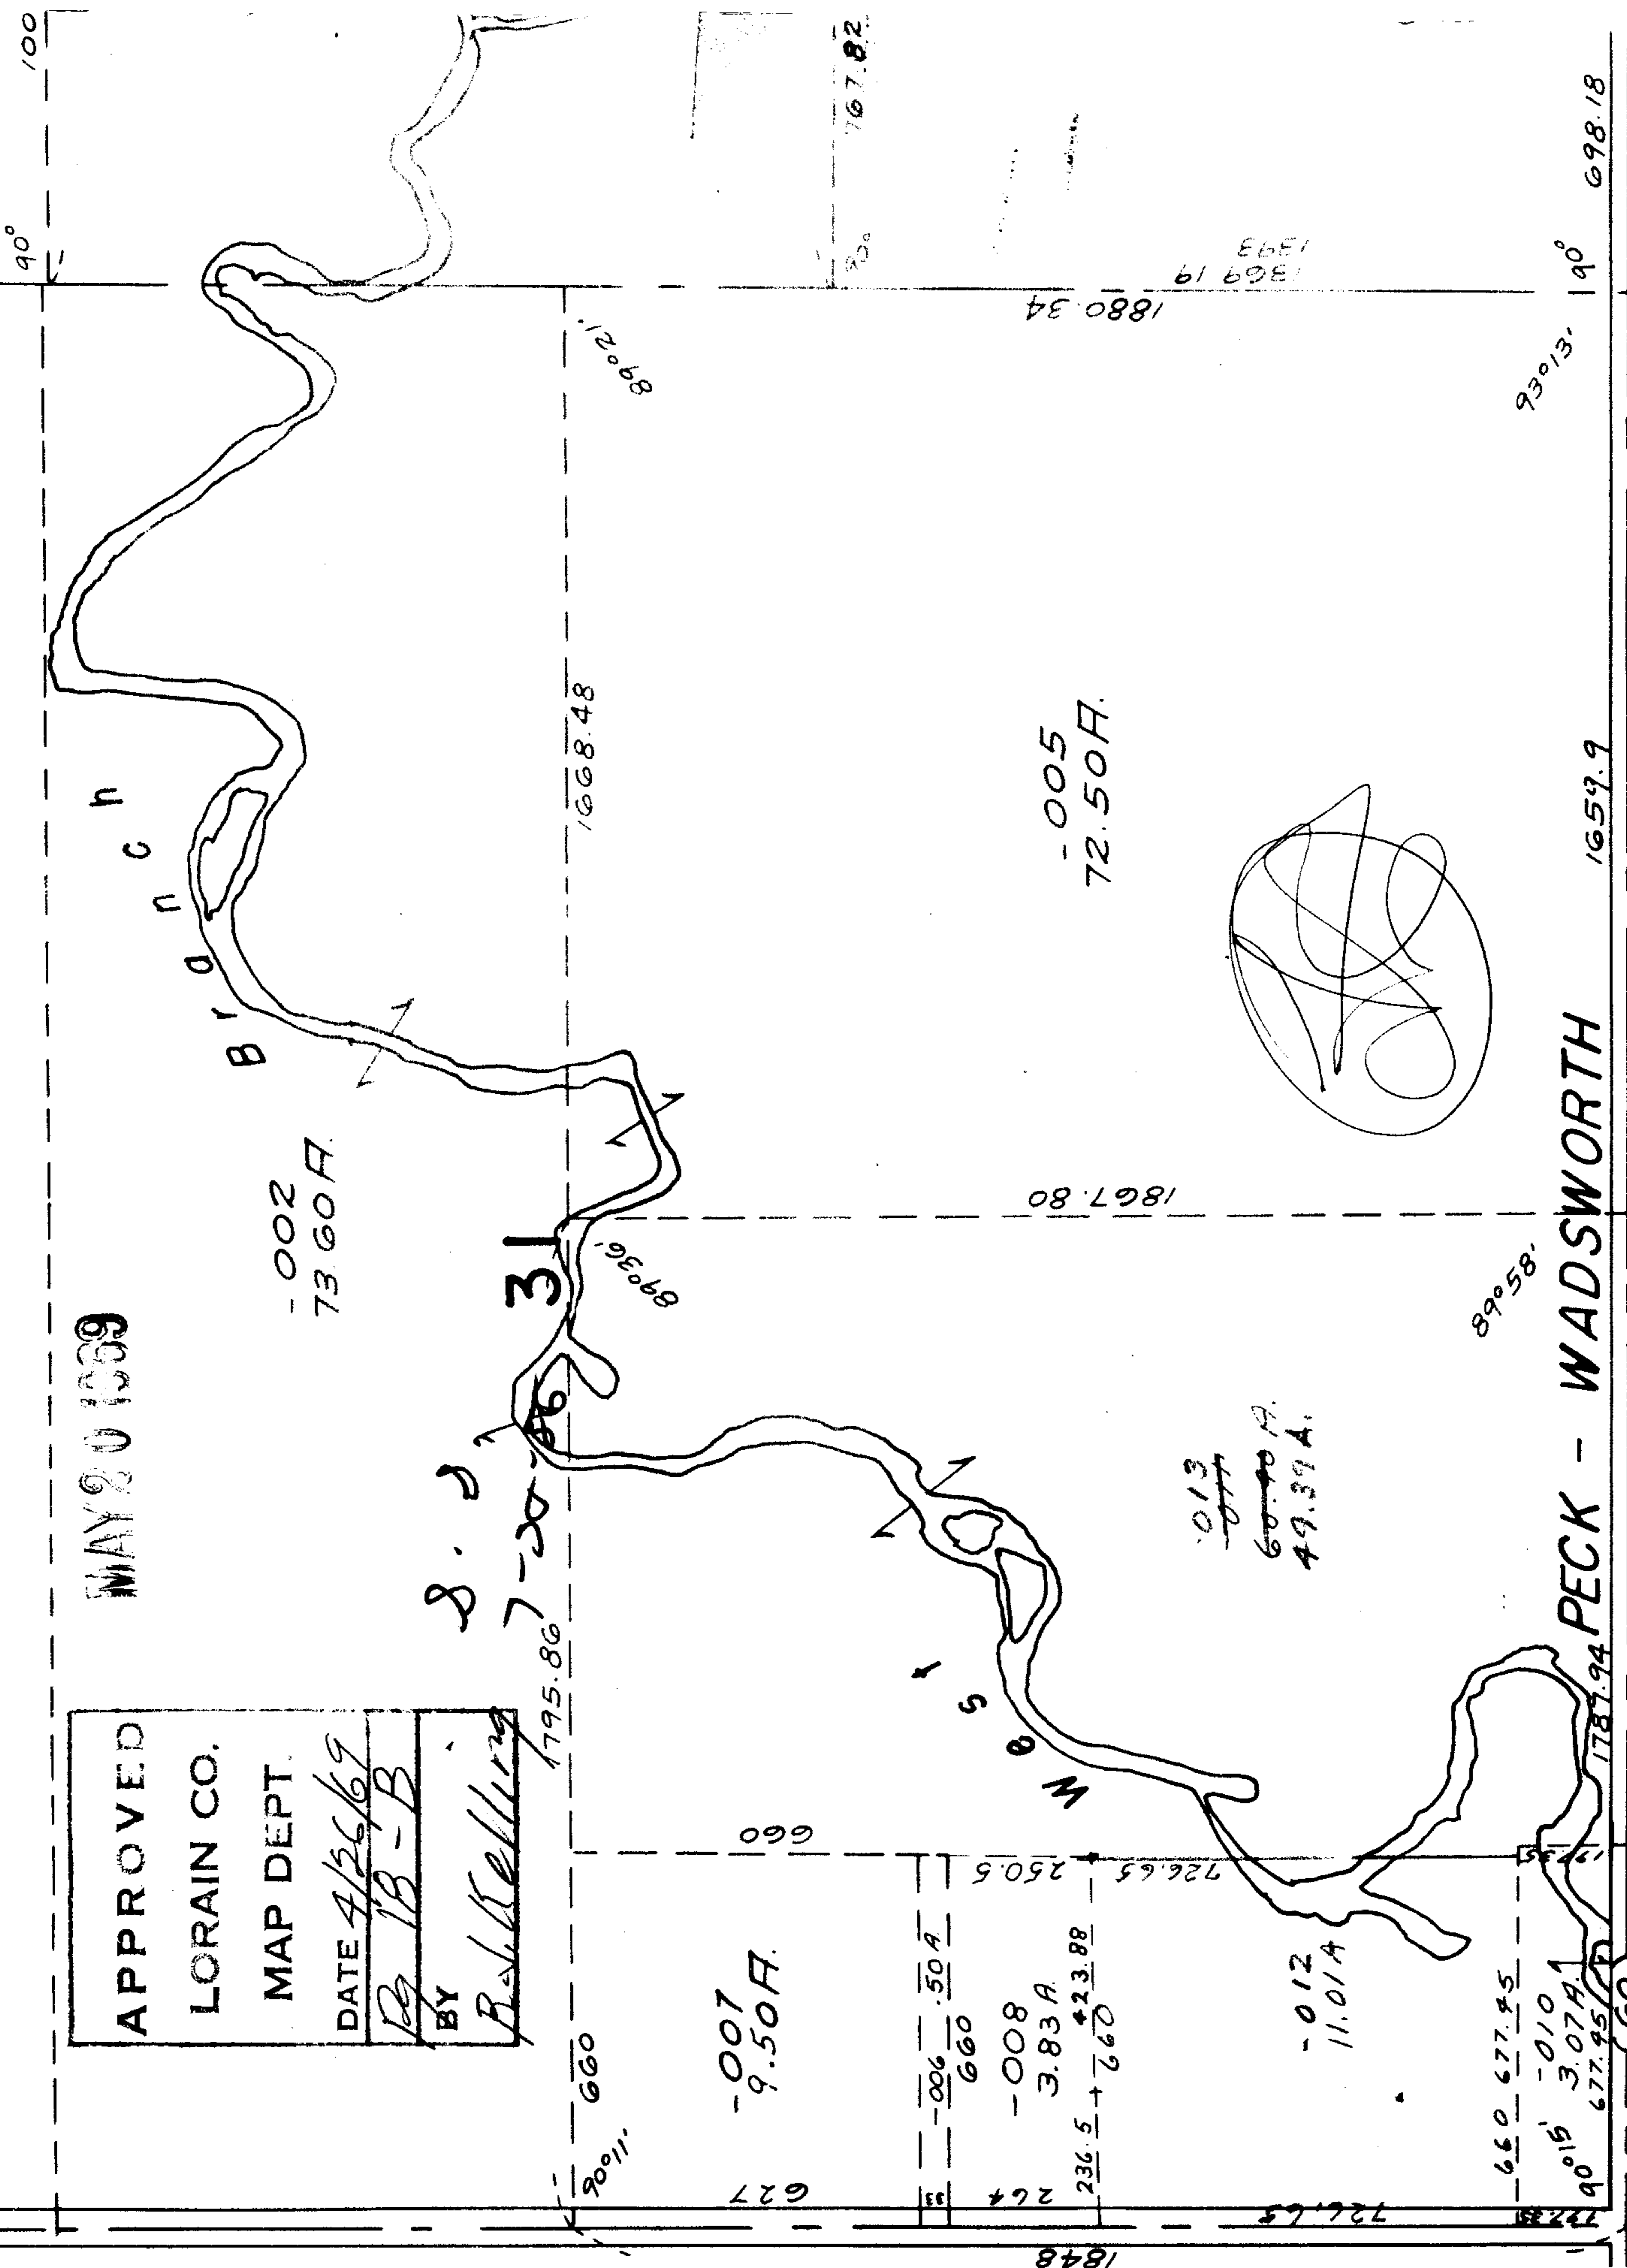

PECK - WADSWORTH

1034.88
 910 559
 300
 300
 550
 (60)