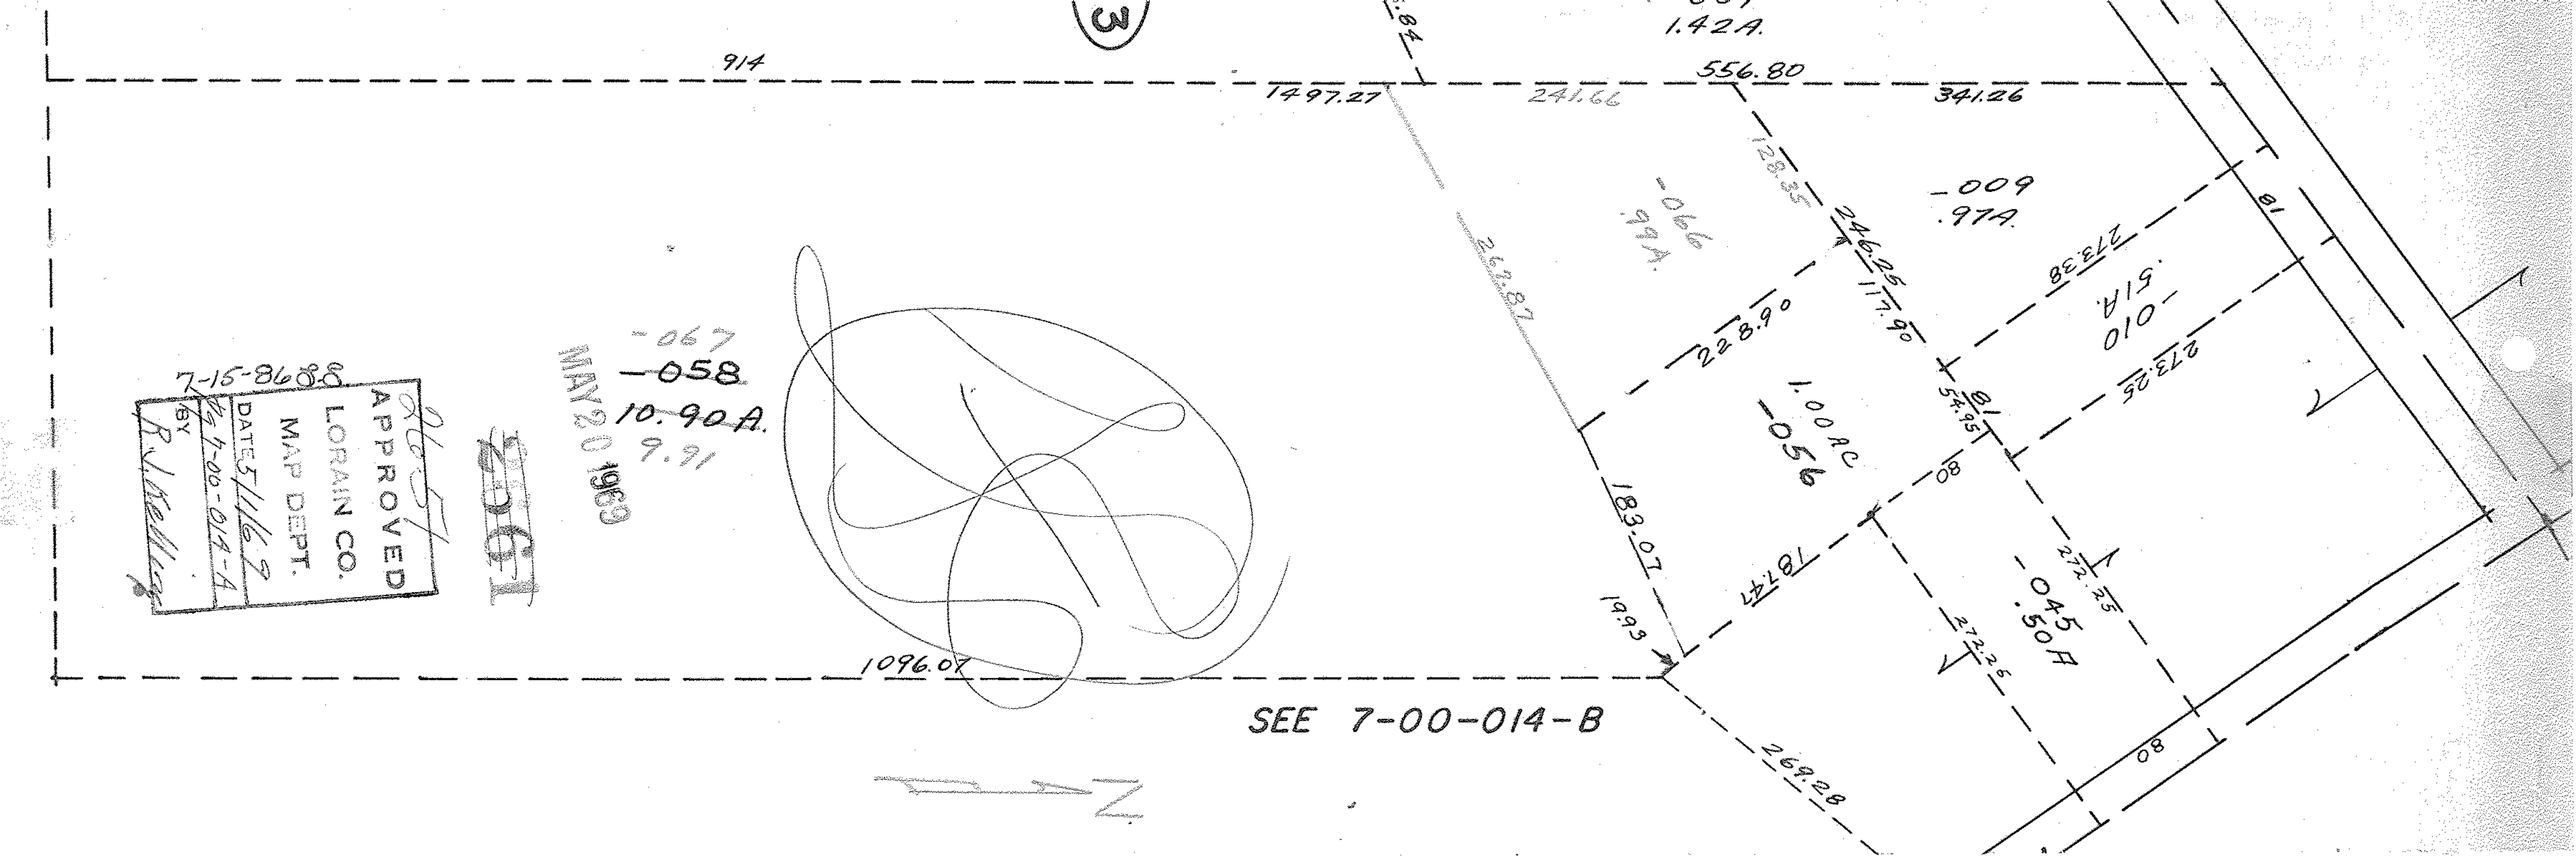
914
1497.27
241.66
556.80
341.26
1.42A.
128.35
246.25
117.90
228.90
262.87
273.38
273.25
1.00 AC
-056
54.95
183.07
19.93
78.74
272.25
272.26
.50A
-045
269.28
1096.07
-009
.97A.
-066
.99A.
-067
-058
10.90A.
9.21
MAY 20 1969
7-15-86 88
APPROVED
LORAIN CO.
MAP DEPT.
DATE 7/16/86
BY
7-00-014-A
SEE 7-00-014-B