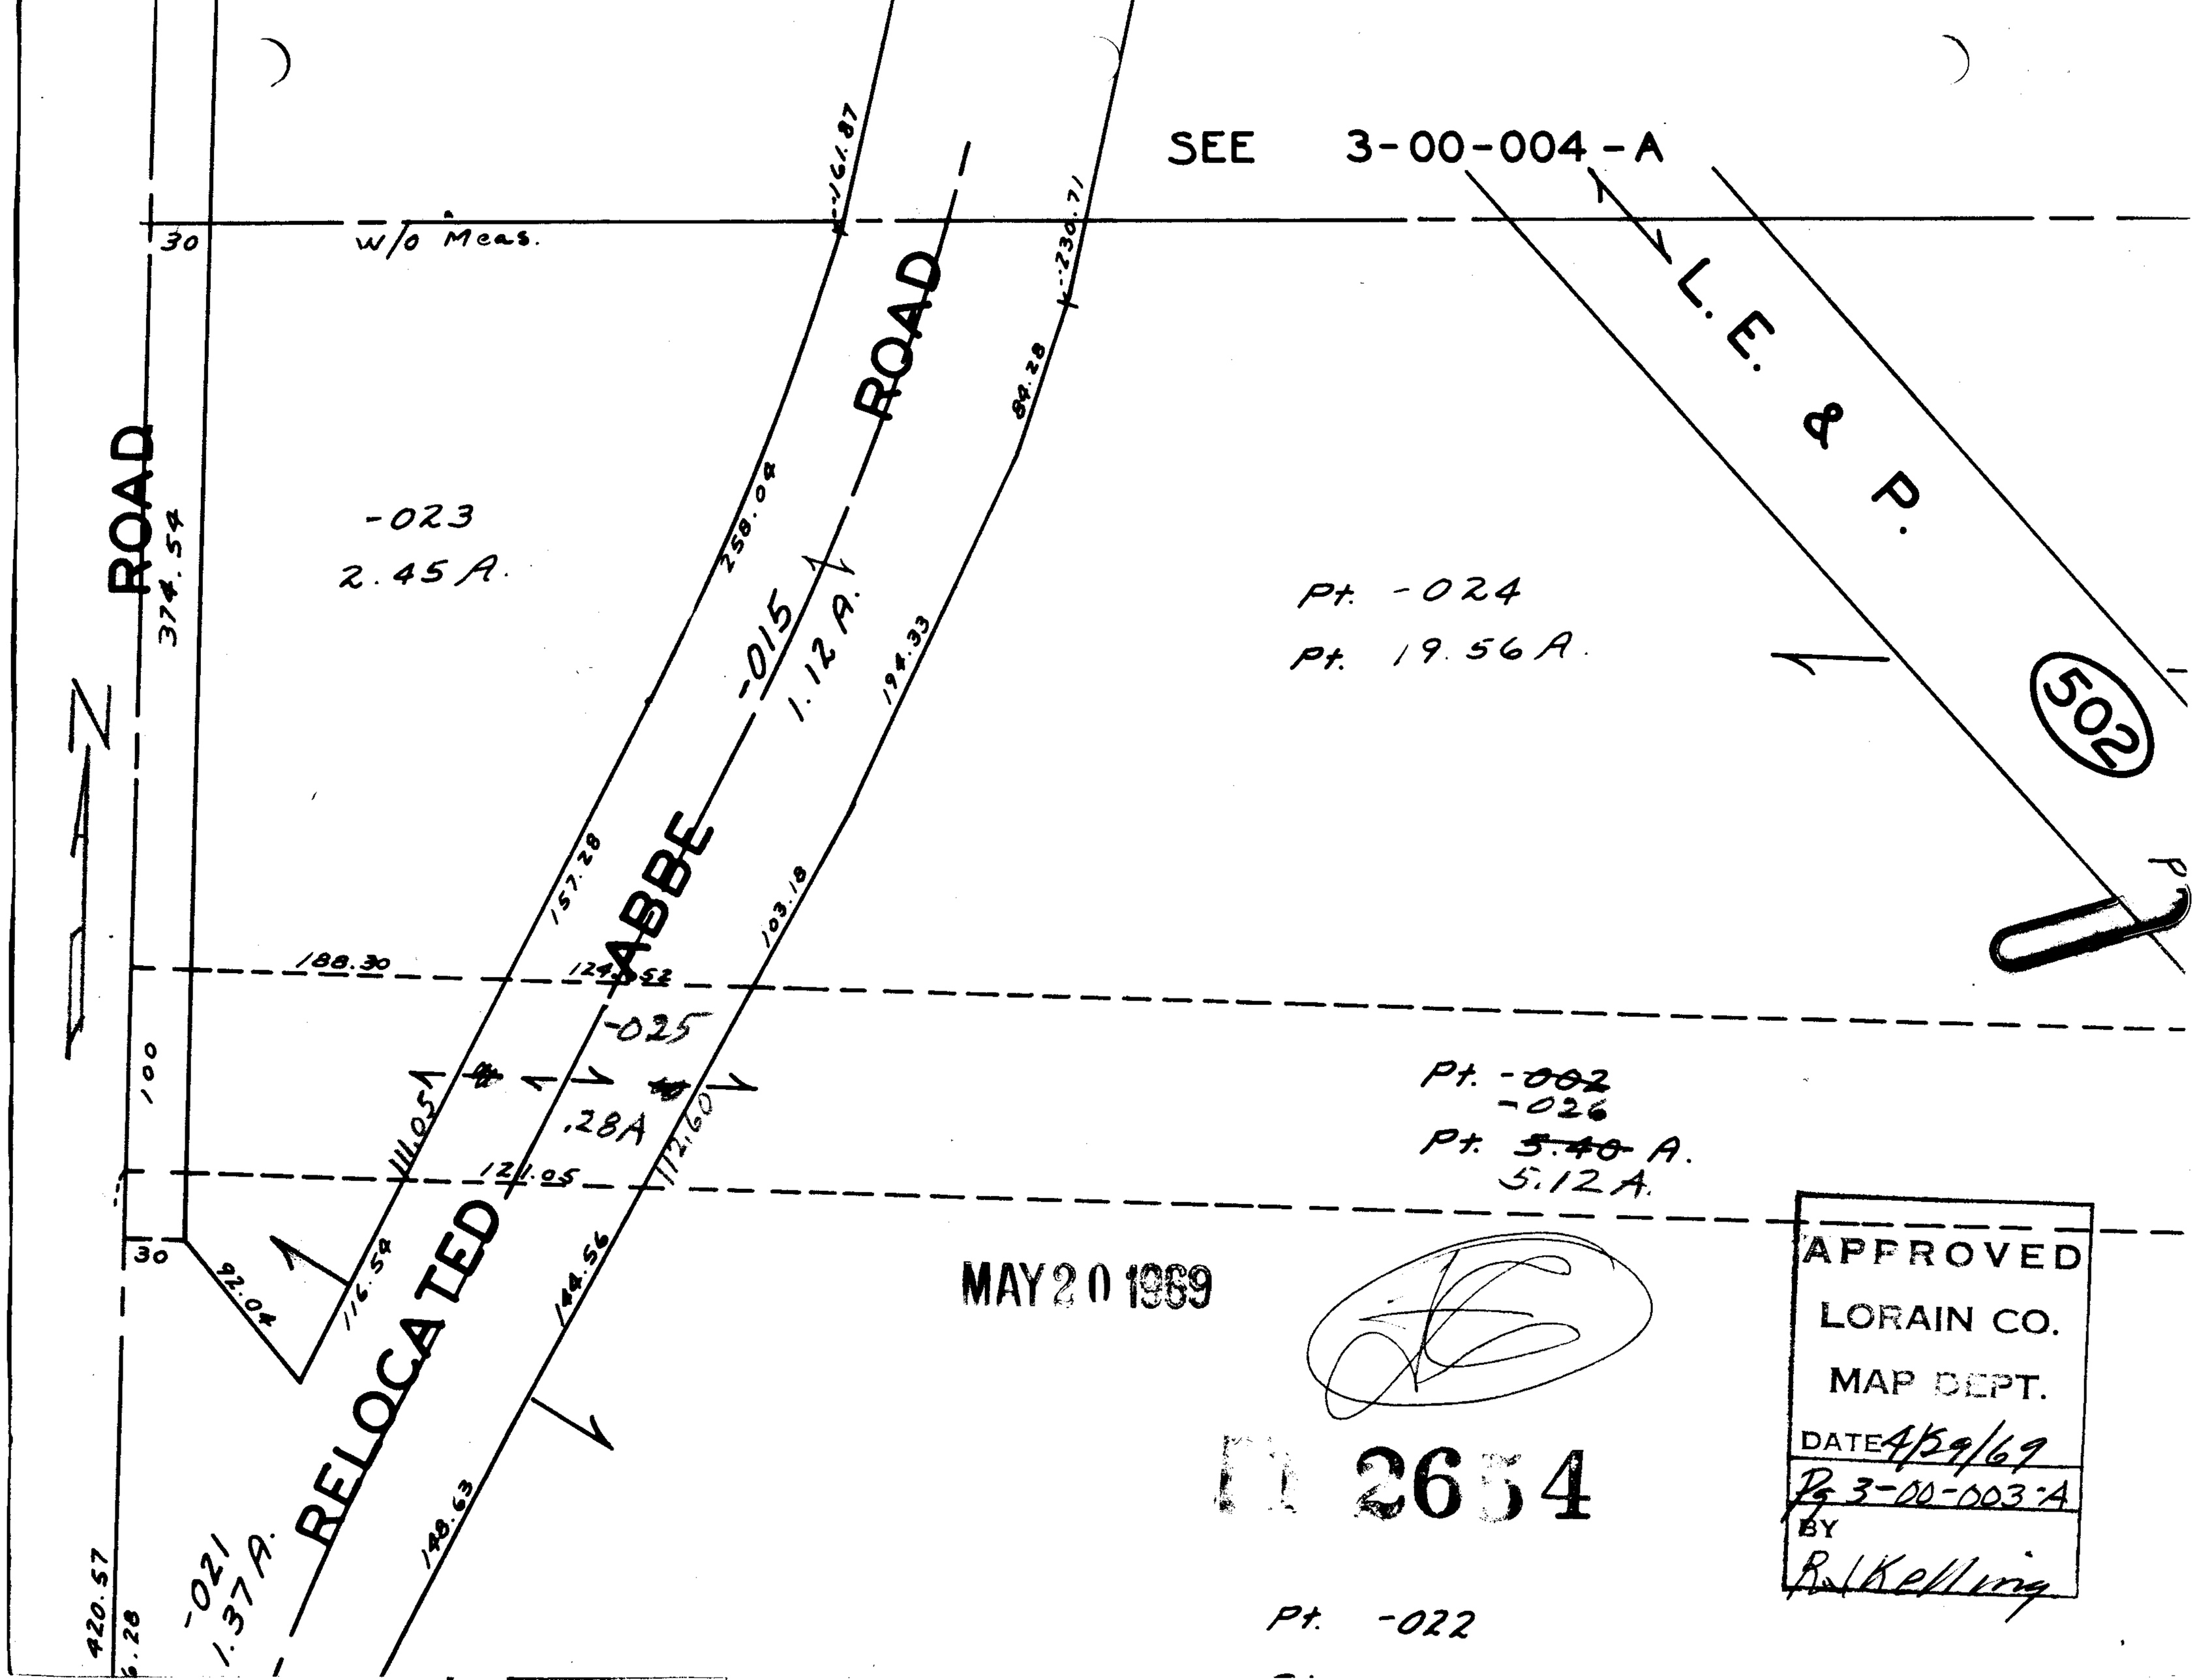
SEE 3-00-004-A
L.E. & P.
502
ROAD
ROAD
ABBE
RELOCATED
N
30
w/o Meas.
374.54
-023
2.45 A.
258.04
-015
1.12 A.
194.33
84.28
-230.71
-161.87
157.28
103.18
188.30
124.52
-025
.28A
111.05
112.60
121.05
100
30
92.04
116.54
144.56
148.63
-021
1.37 A.
420.57
Pt. -024
Pt. 19.56 A.
Pt. -002
-026
Pt. 5.40 A.
5.12 A.
Pt. -022
MAY 20 1969
APPROVED
LORAIN CO.
MAP DEPT.
DATE 4/29/69
Pg 3-00-003-A
BY
R. Kelling
2654