


SEE 10-00-003-C

2653

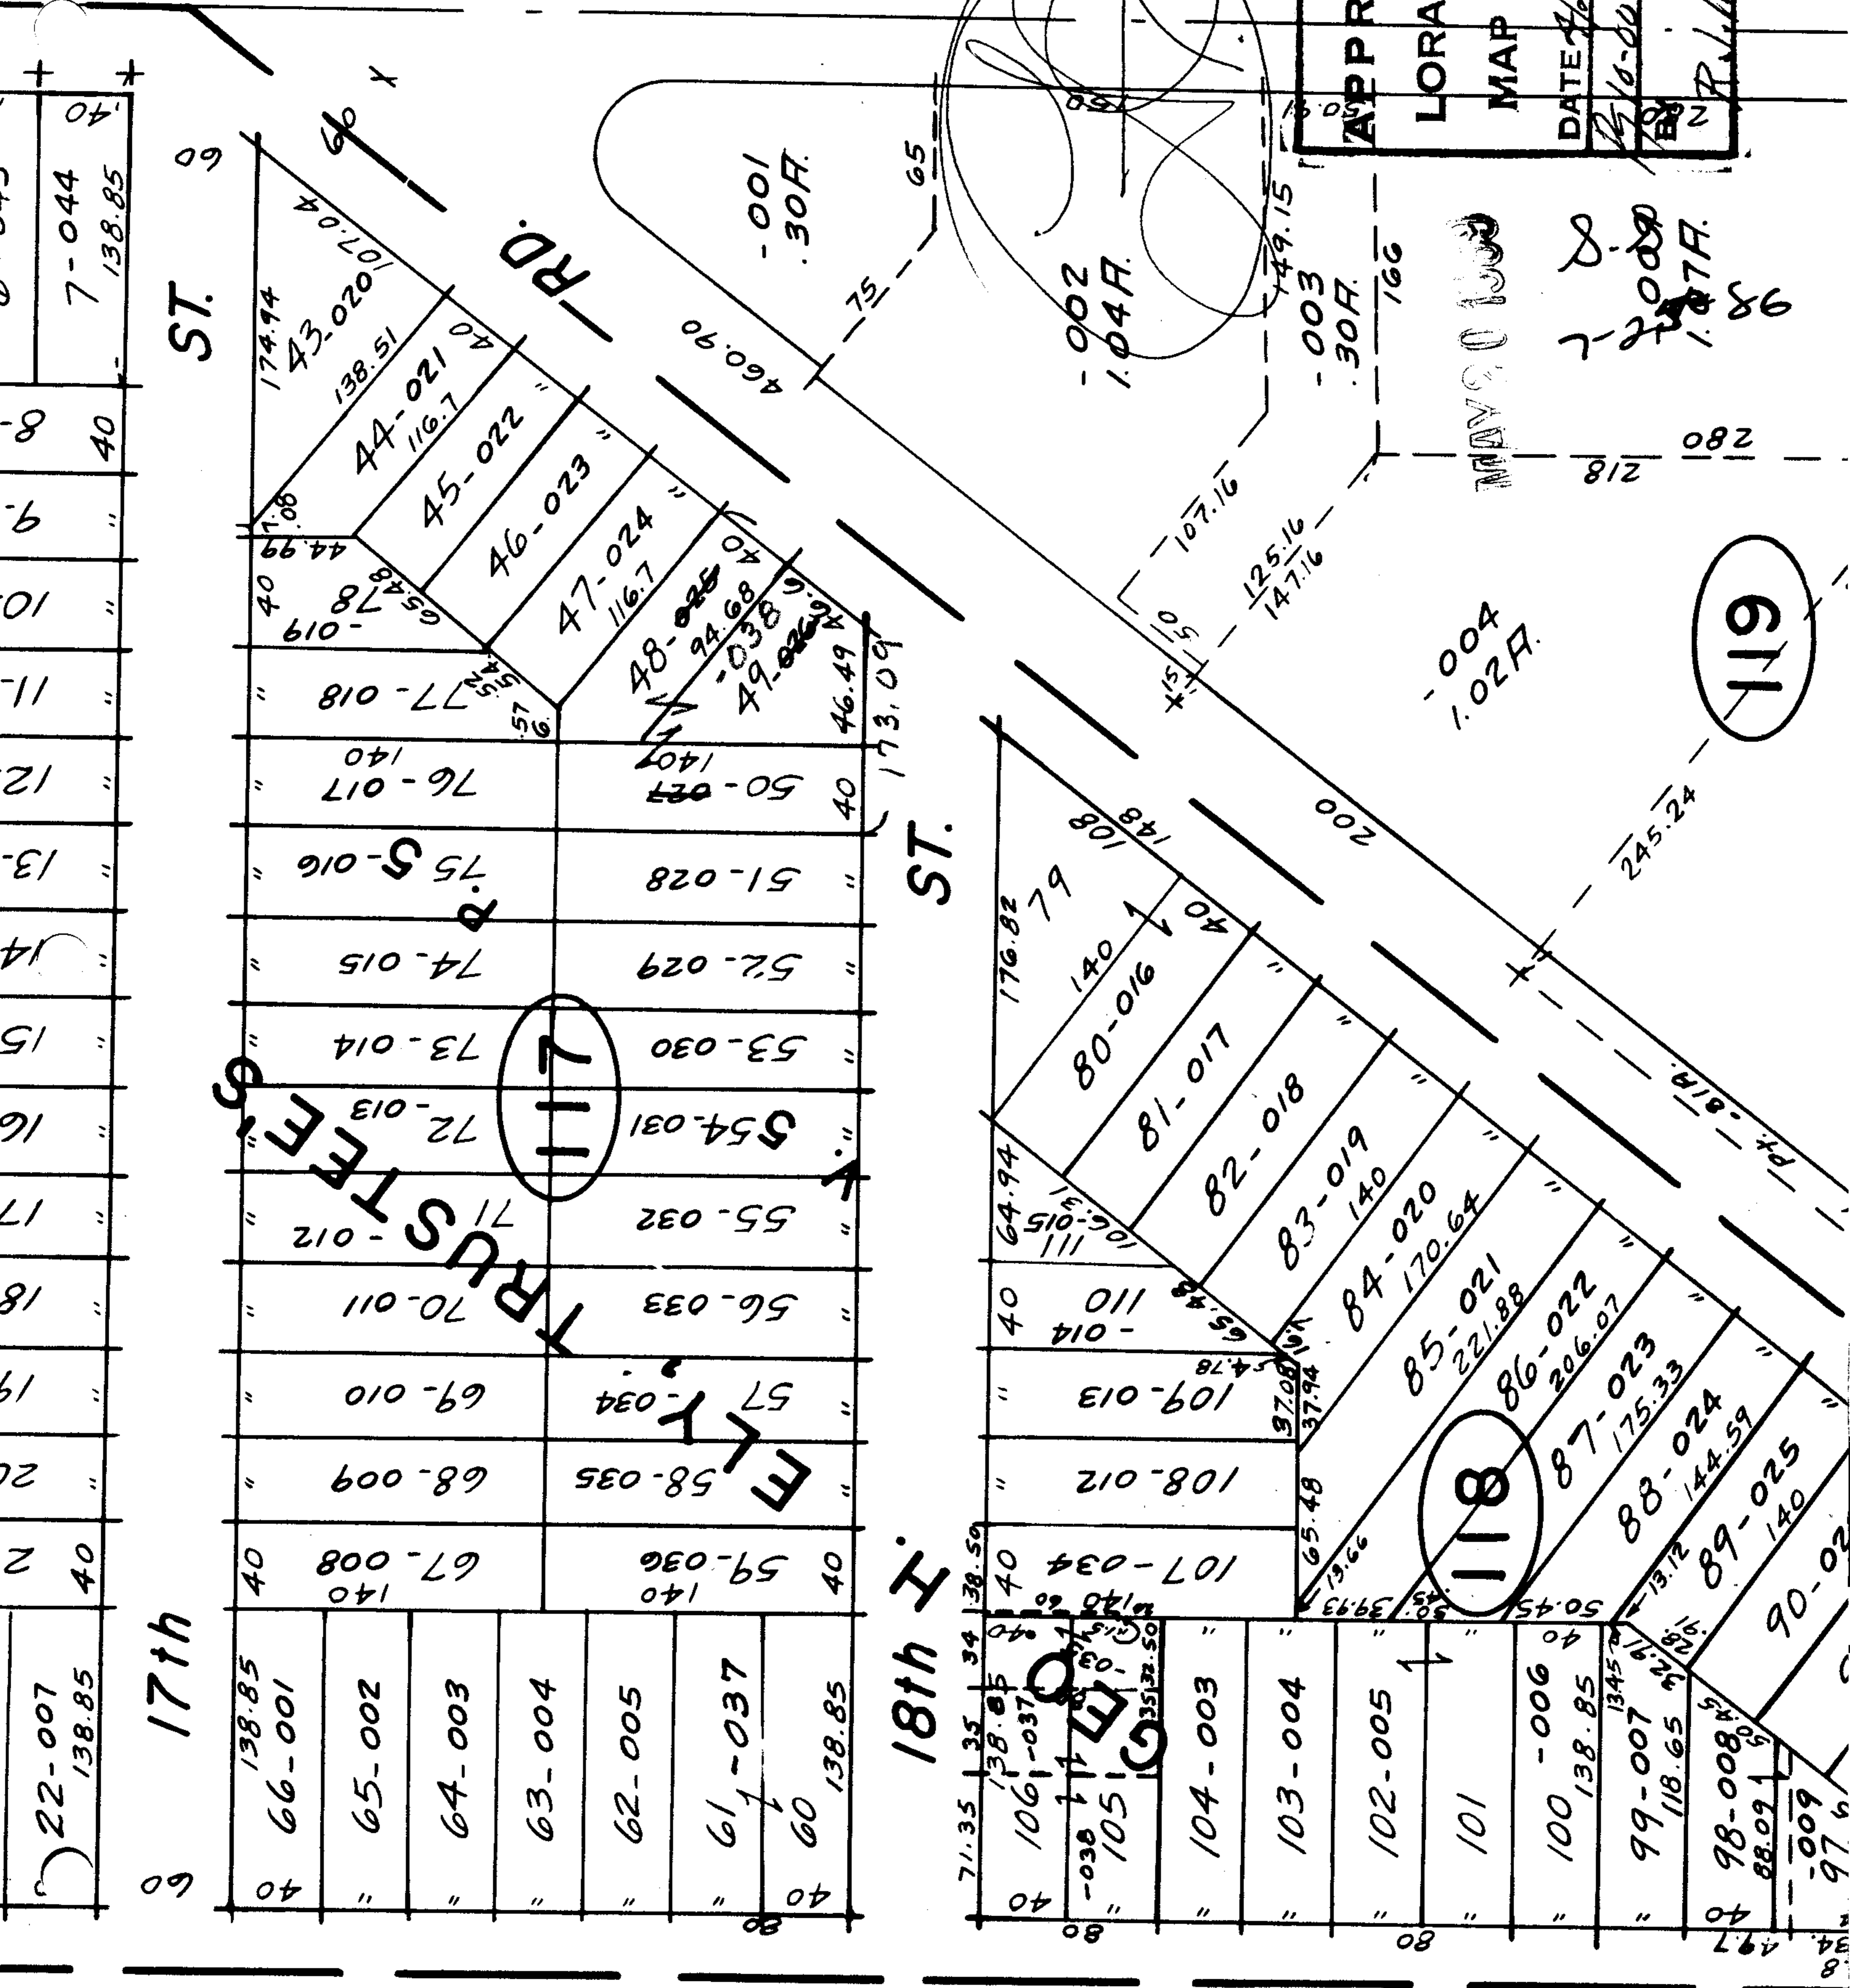

**APPROVED**  
**LORAIN CO.**  
**MAP DEPT.**  
 DATE 4/29/69  
 BY [Signature]  
 10-00-003 D

MAY 20 1969

2-20000  
1.007A  
98


118

117

TRUSTEES