


APPROVED  
 LORAIN CO. MAP DEPT. 1007  
 DATE 4/30/69  
 BY 2-61-003 - E 90.75  
 12-006  
 240'9"  
 247'4"  
 253'1"  
 267'1"  
 273'8"  
 280'3"  
 290'0"

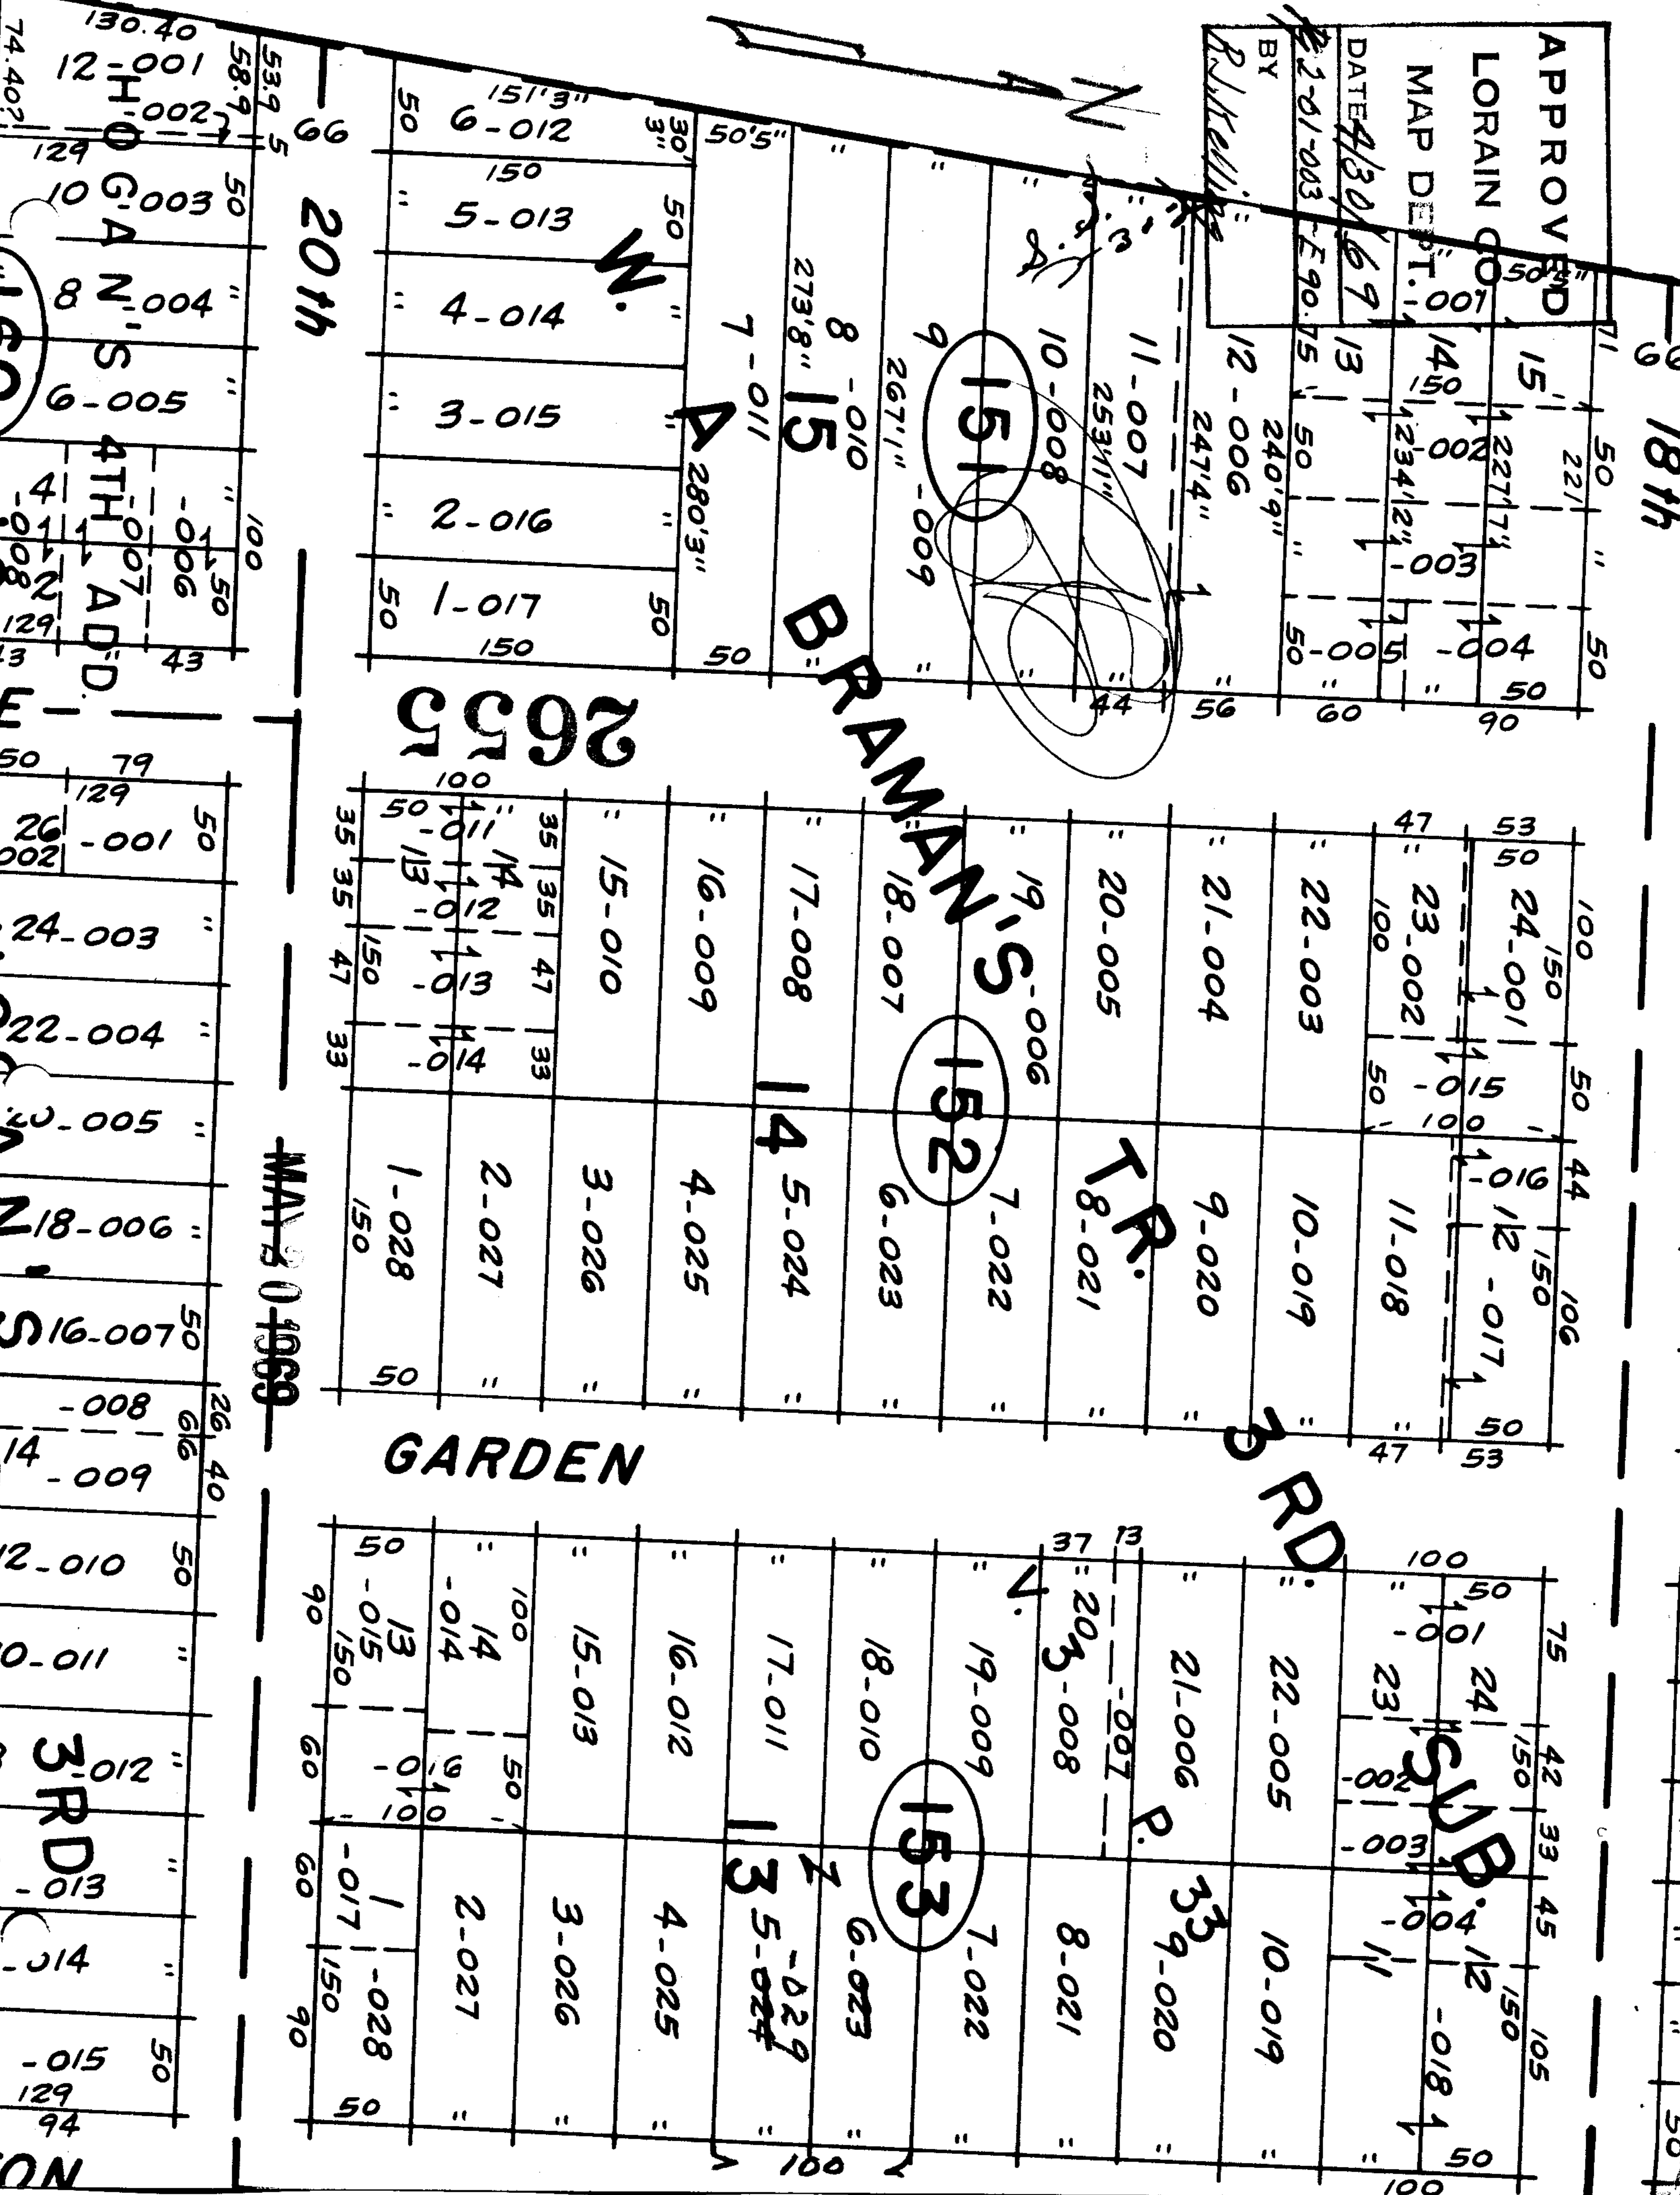

**2655**

**GARDEN**

MAY 30 1969

**3 RD**

**SUB B**

20th

18th

3rd

TON