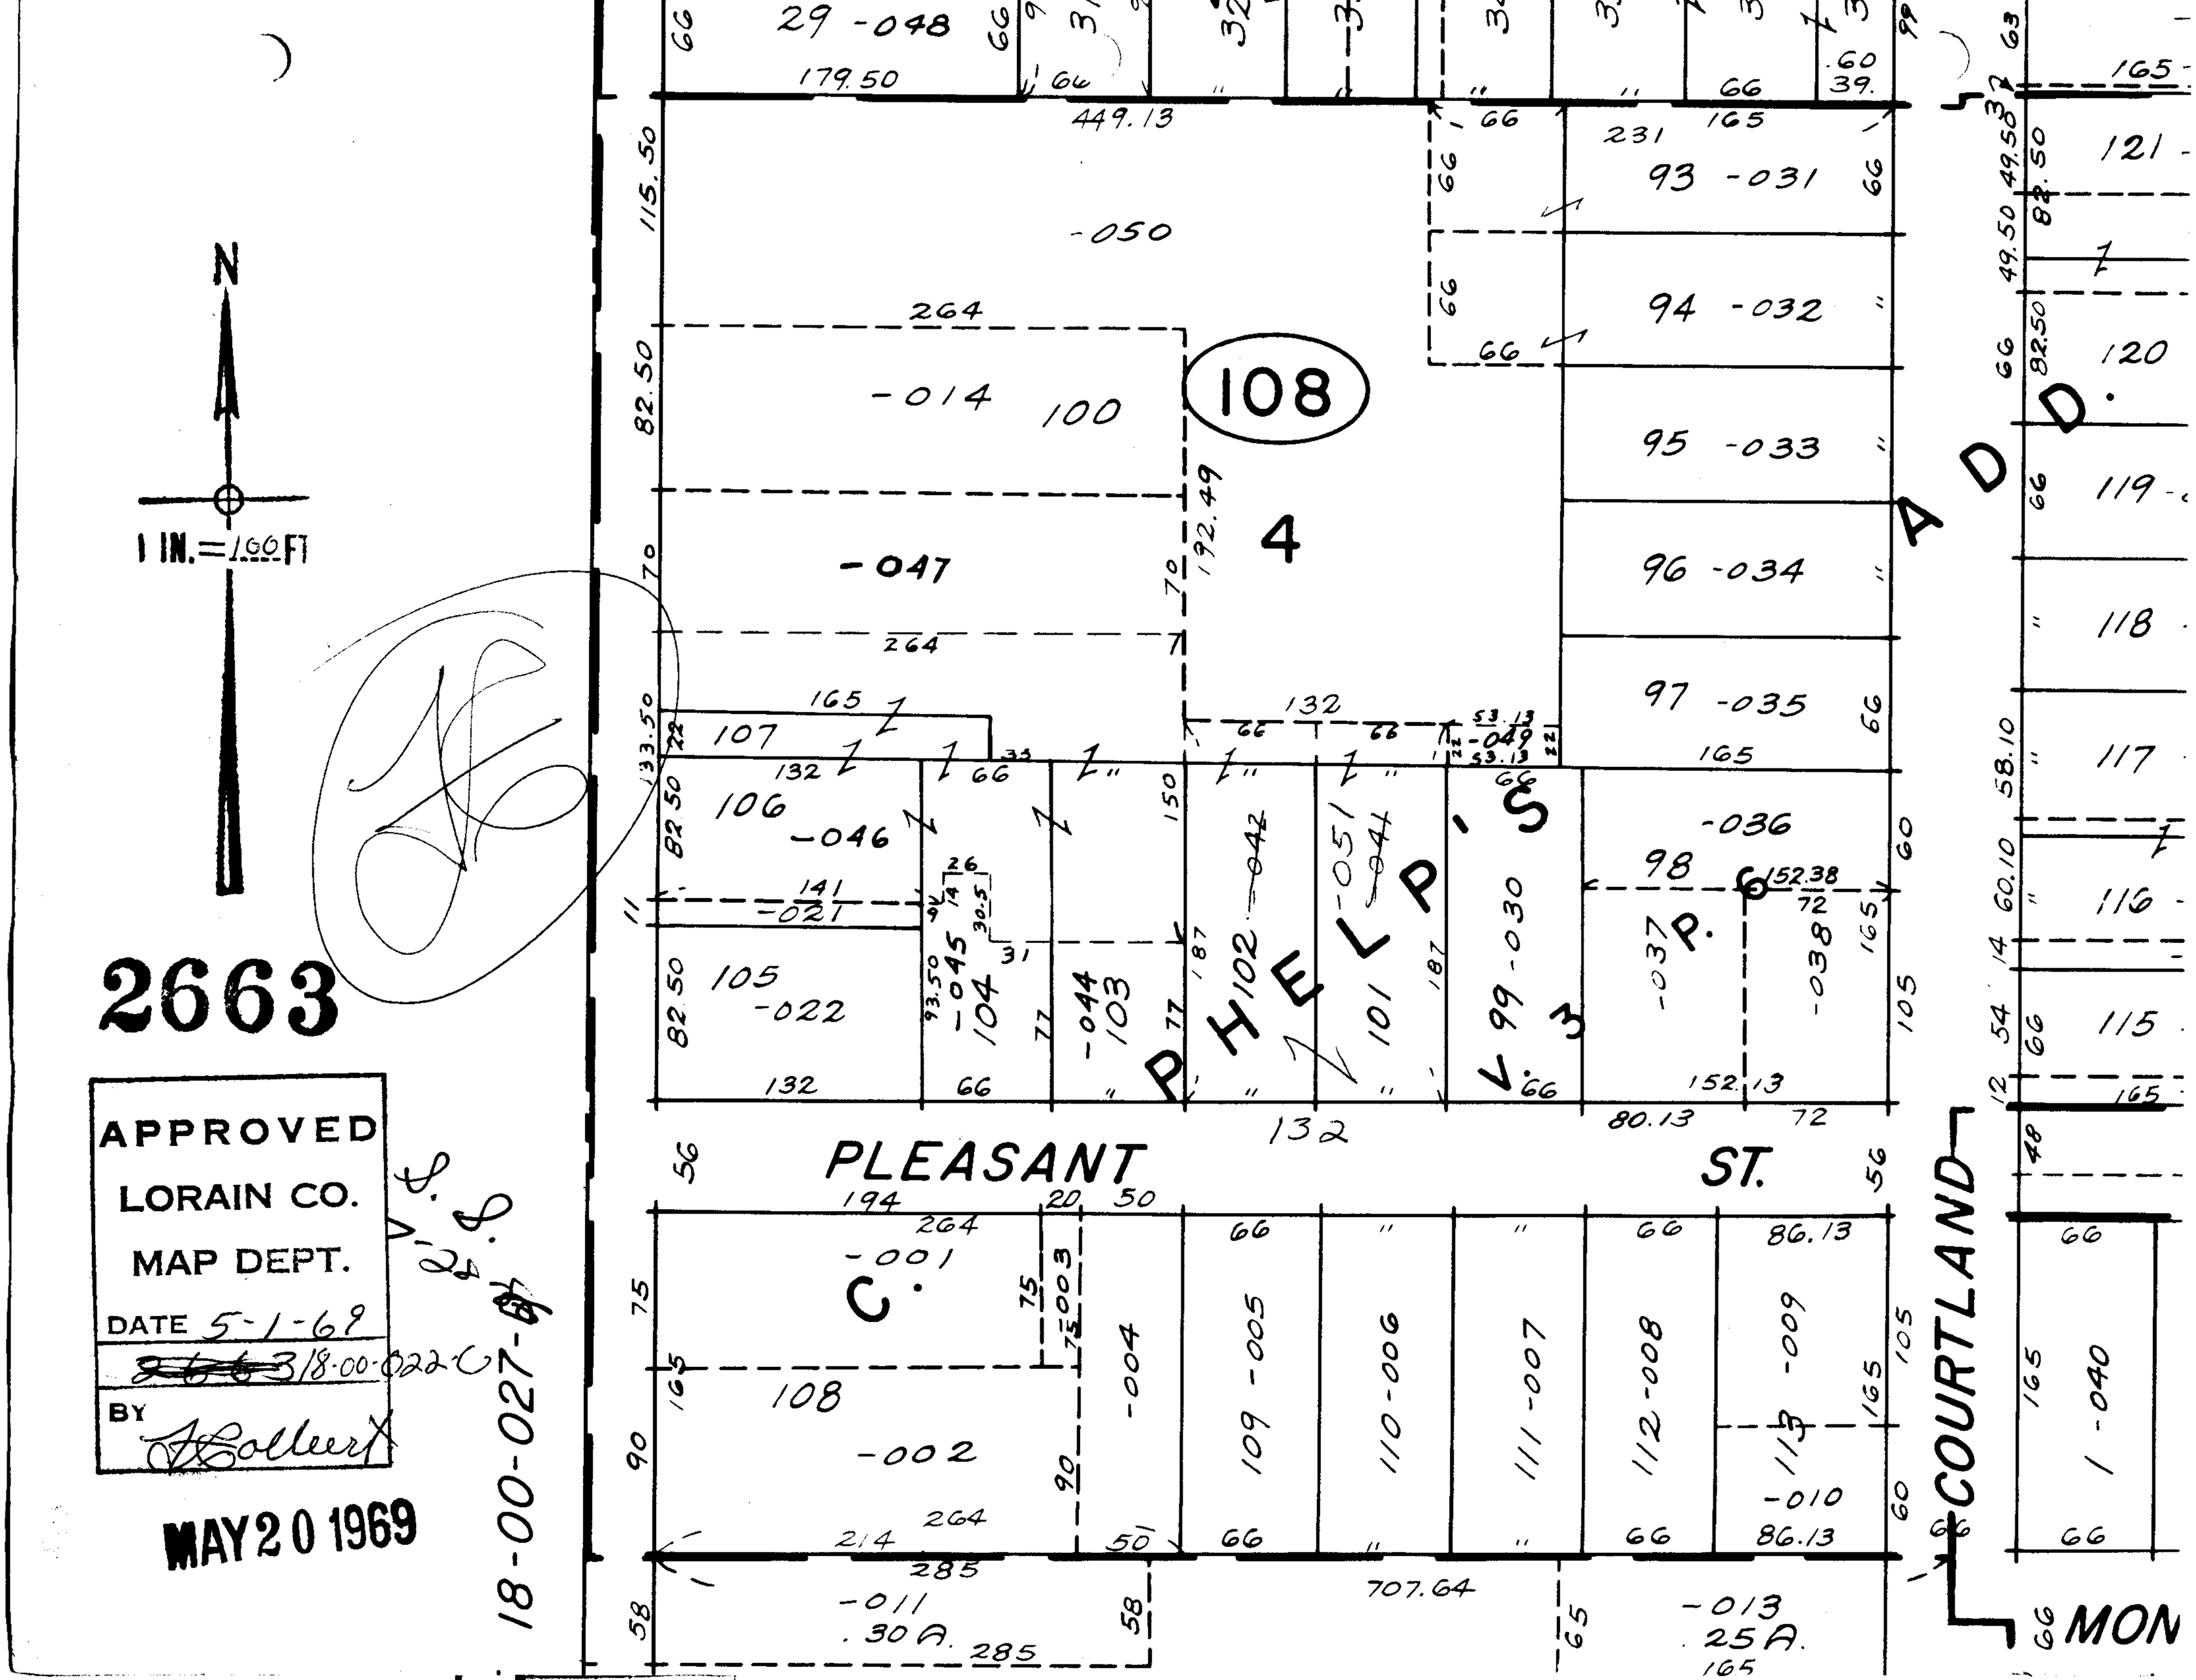

N
1 IN.=100 FT
2663
APPROVED
LORAIN CO.
MAP DEPT.
DATE 5-1-69
18-00-022-C
BY
MAY 20 1969
18-00-027-
PLEASANT ST.
COURTLAND
PHELP'S
ADD.
108
4
C.
MON