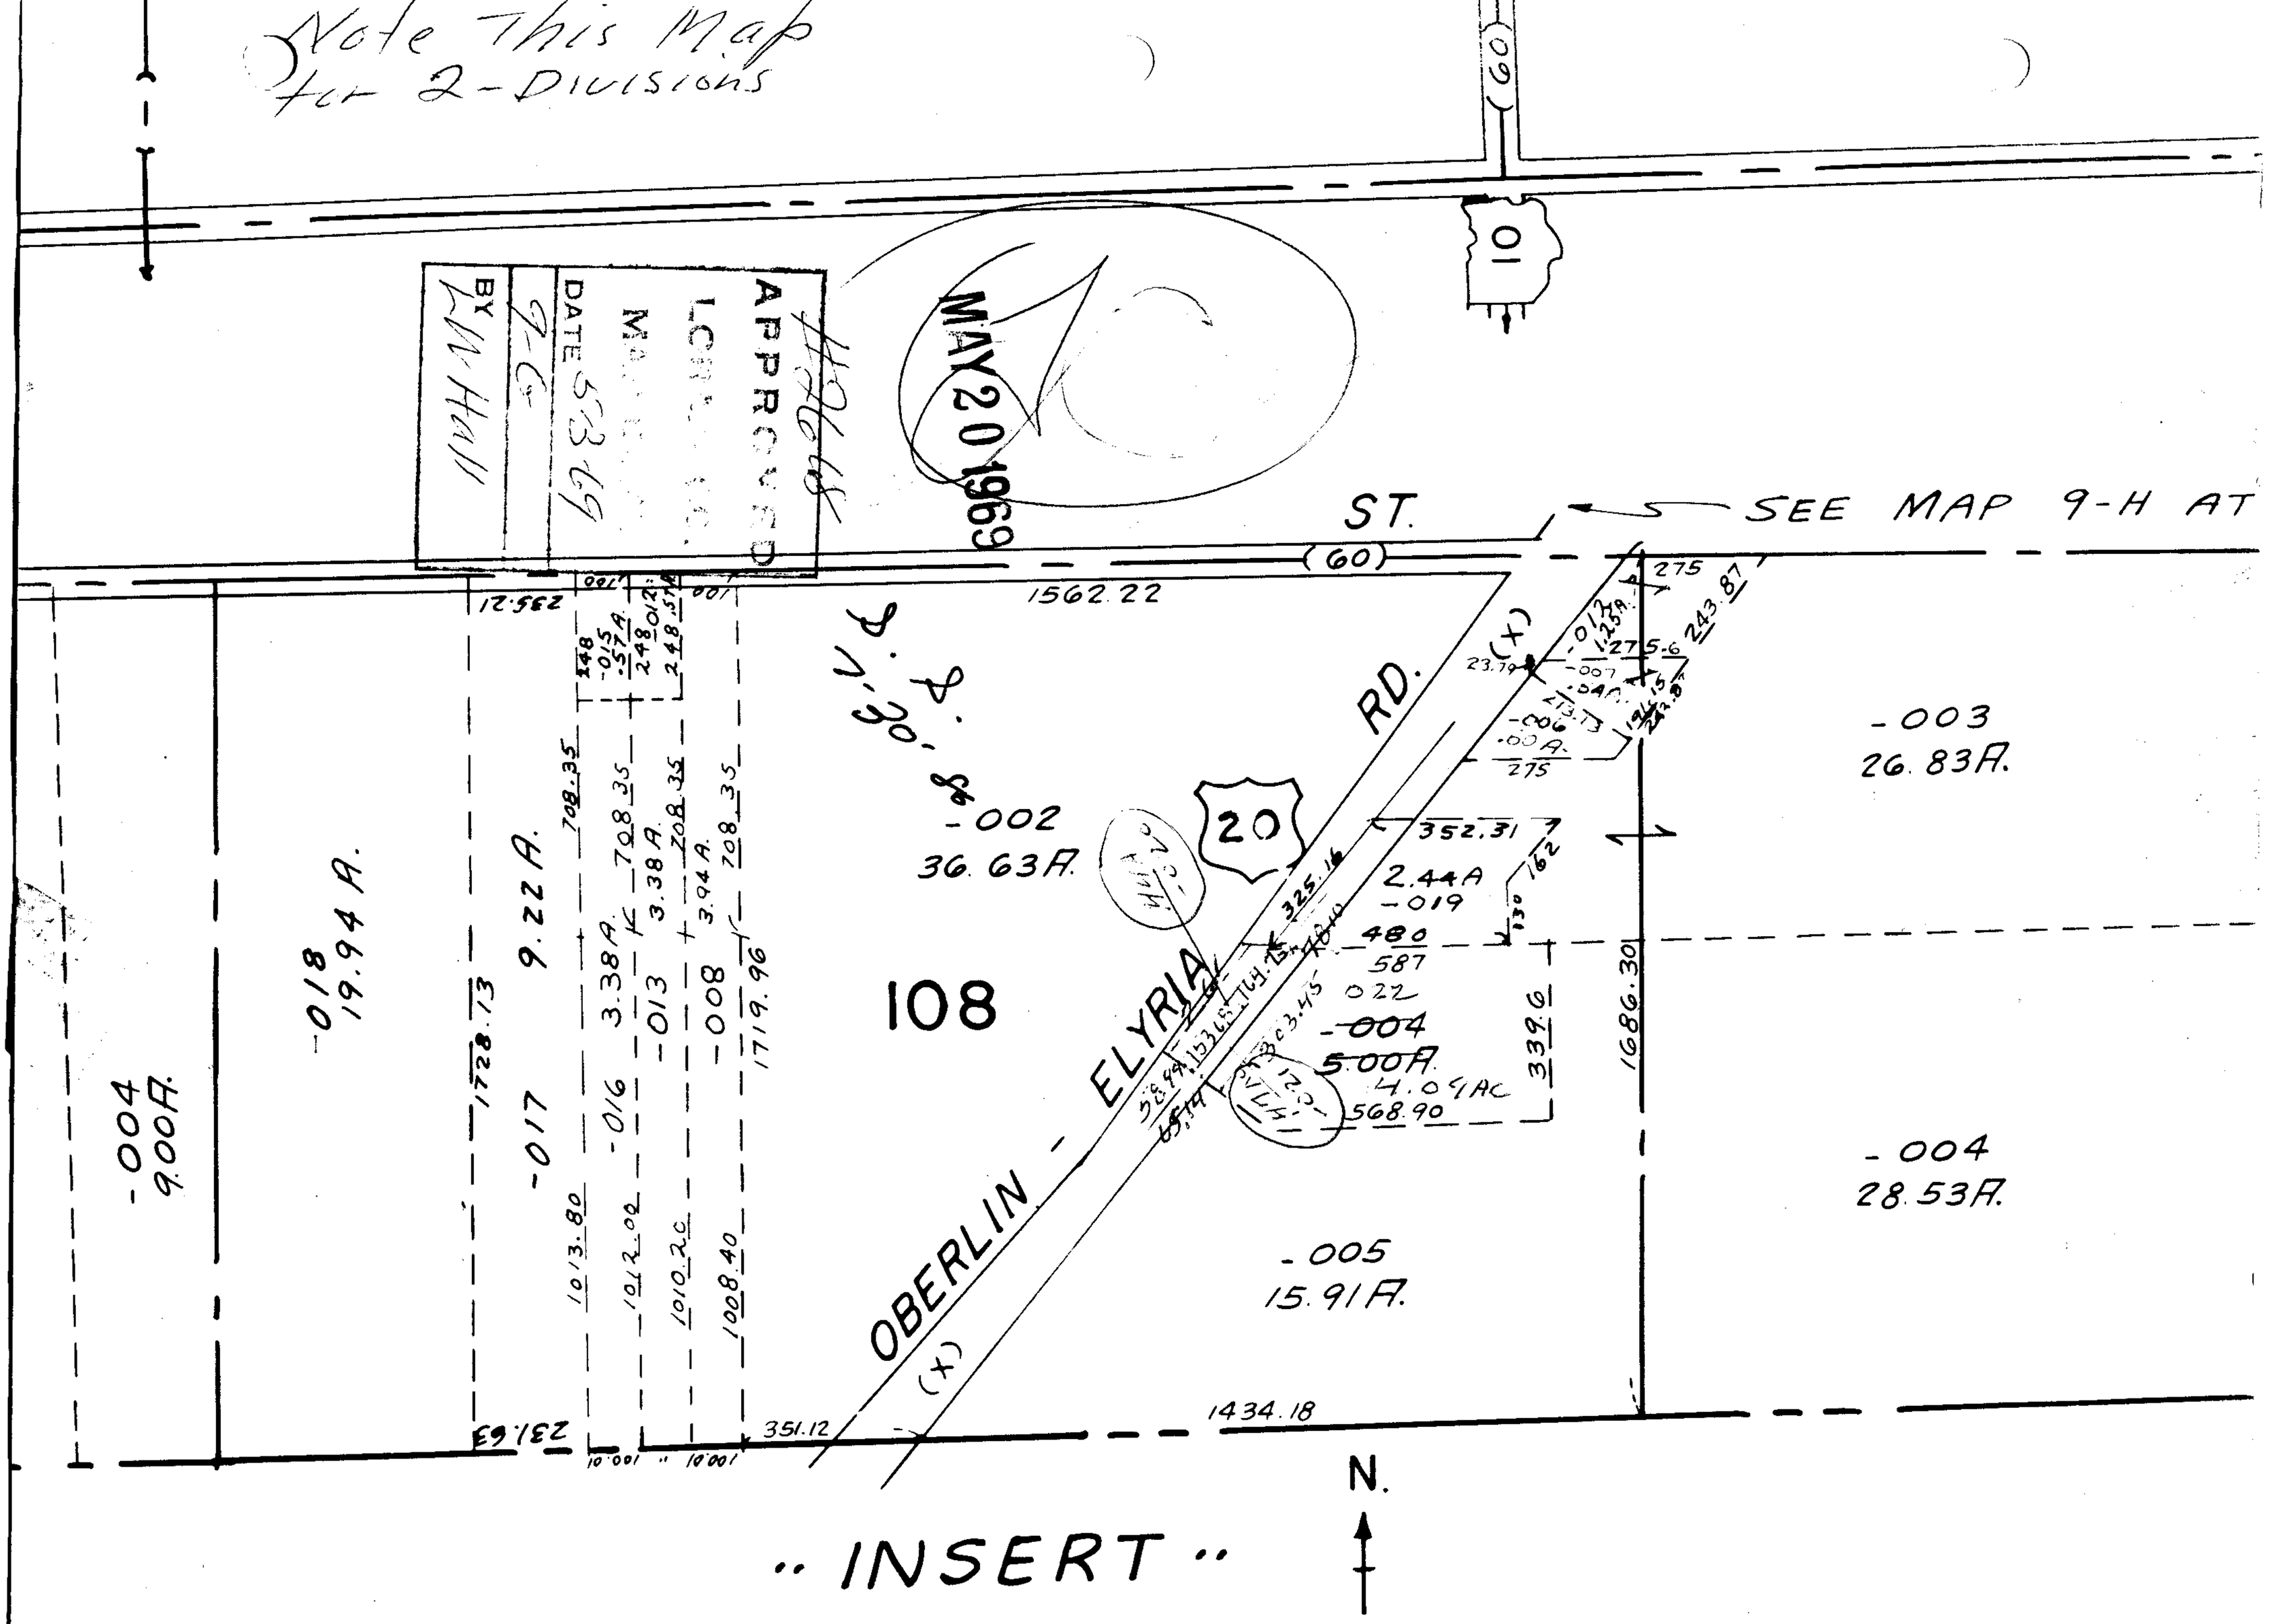
Note This Map for 2-Divisions
APPROVED
DATE 5-3-69
BY LW Hall
MAY 20 1969
ST.
SEE MAP 9-H AT
(60)
1562.22
RD.
20
OBERLIN - ELYRIA
108
-002
36.63A.
-003
26.83A.
-004
28.53A.
-005
15.91A.
-004
9.00A.
-018
19.94A.
-017
9.22A.
-016
3.38A.
-013
3.38A.
-008
3.94A.
1728.13
1719.96
1013.80
1012.00
1010.20
1008.40
1434.18
351.12
231.63
352.31
2.44A
-019
480
587
022
-004
5.00A.
4.09AC
568.90
339.6
1686.30
243.87
275
N.
.. INSERT ..