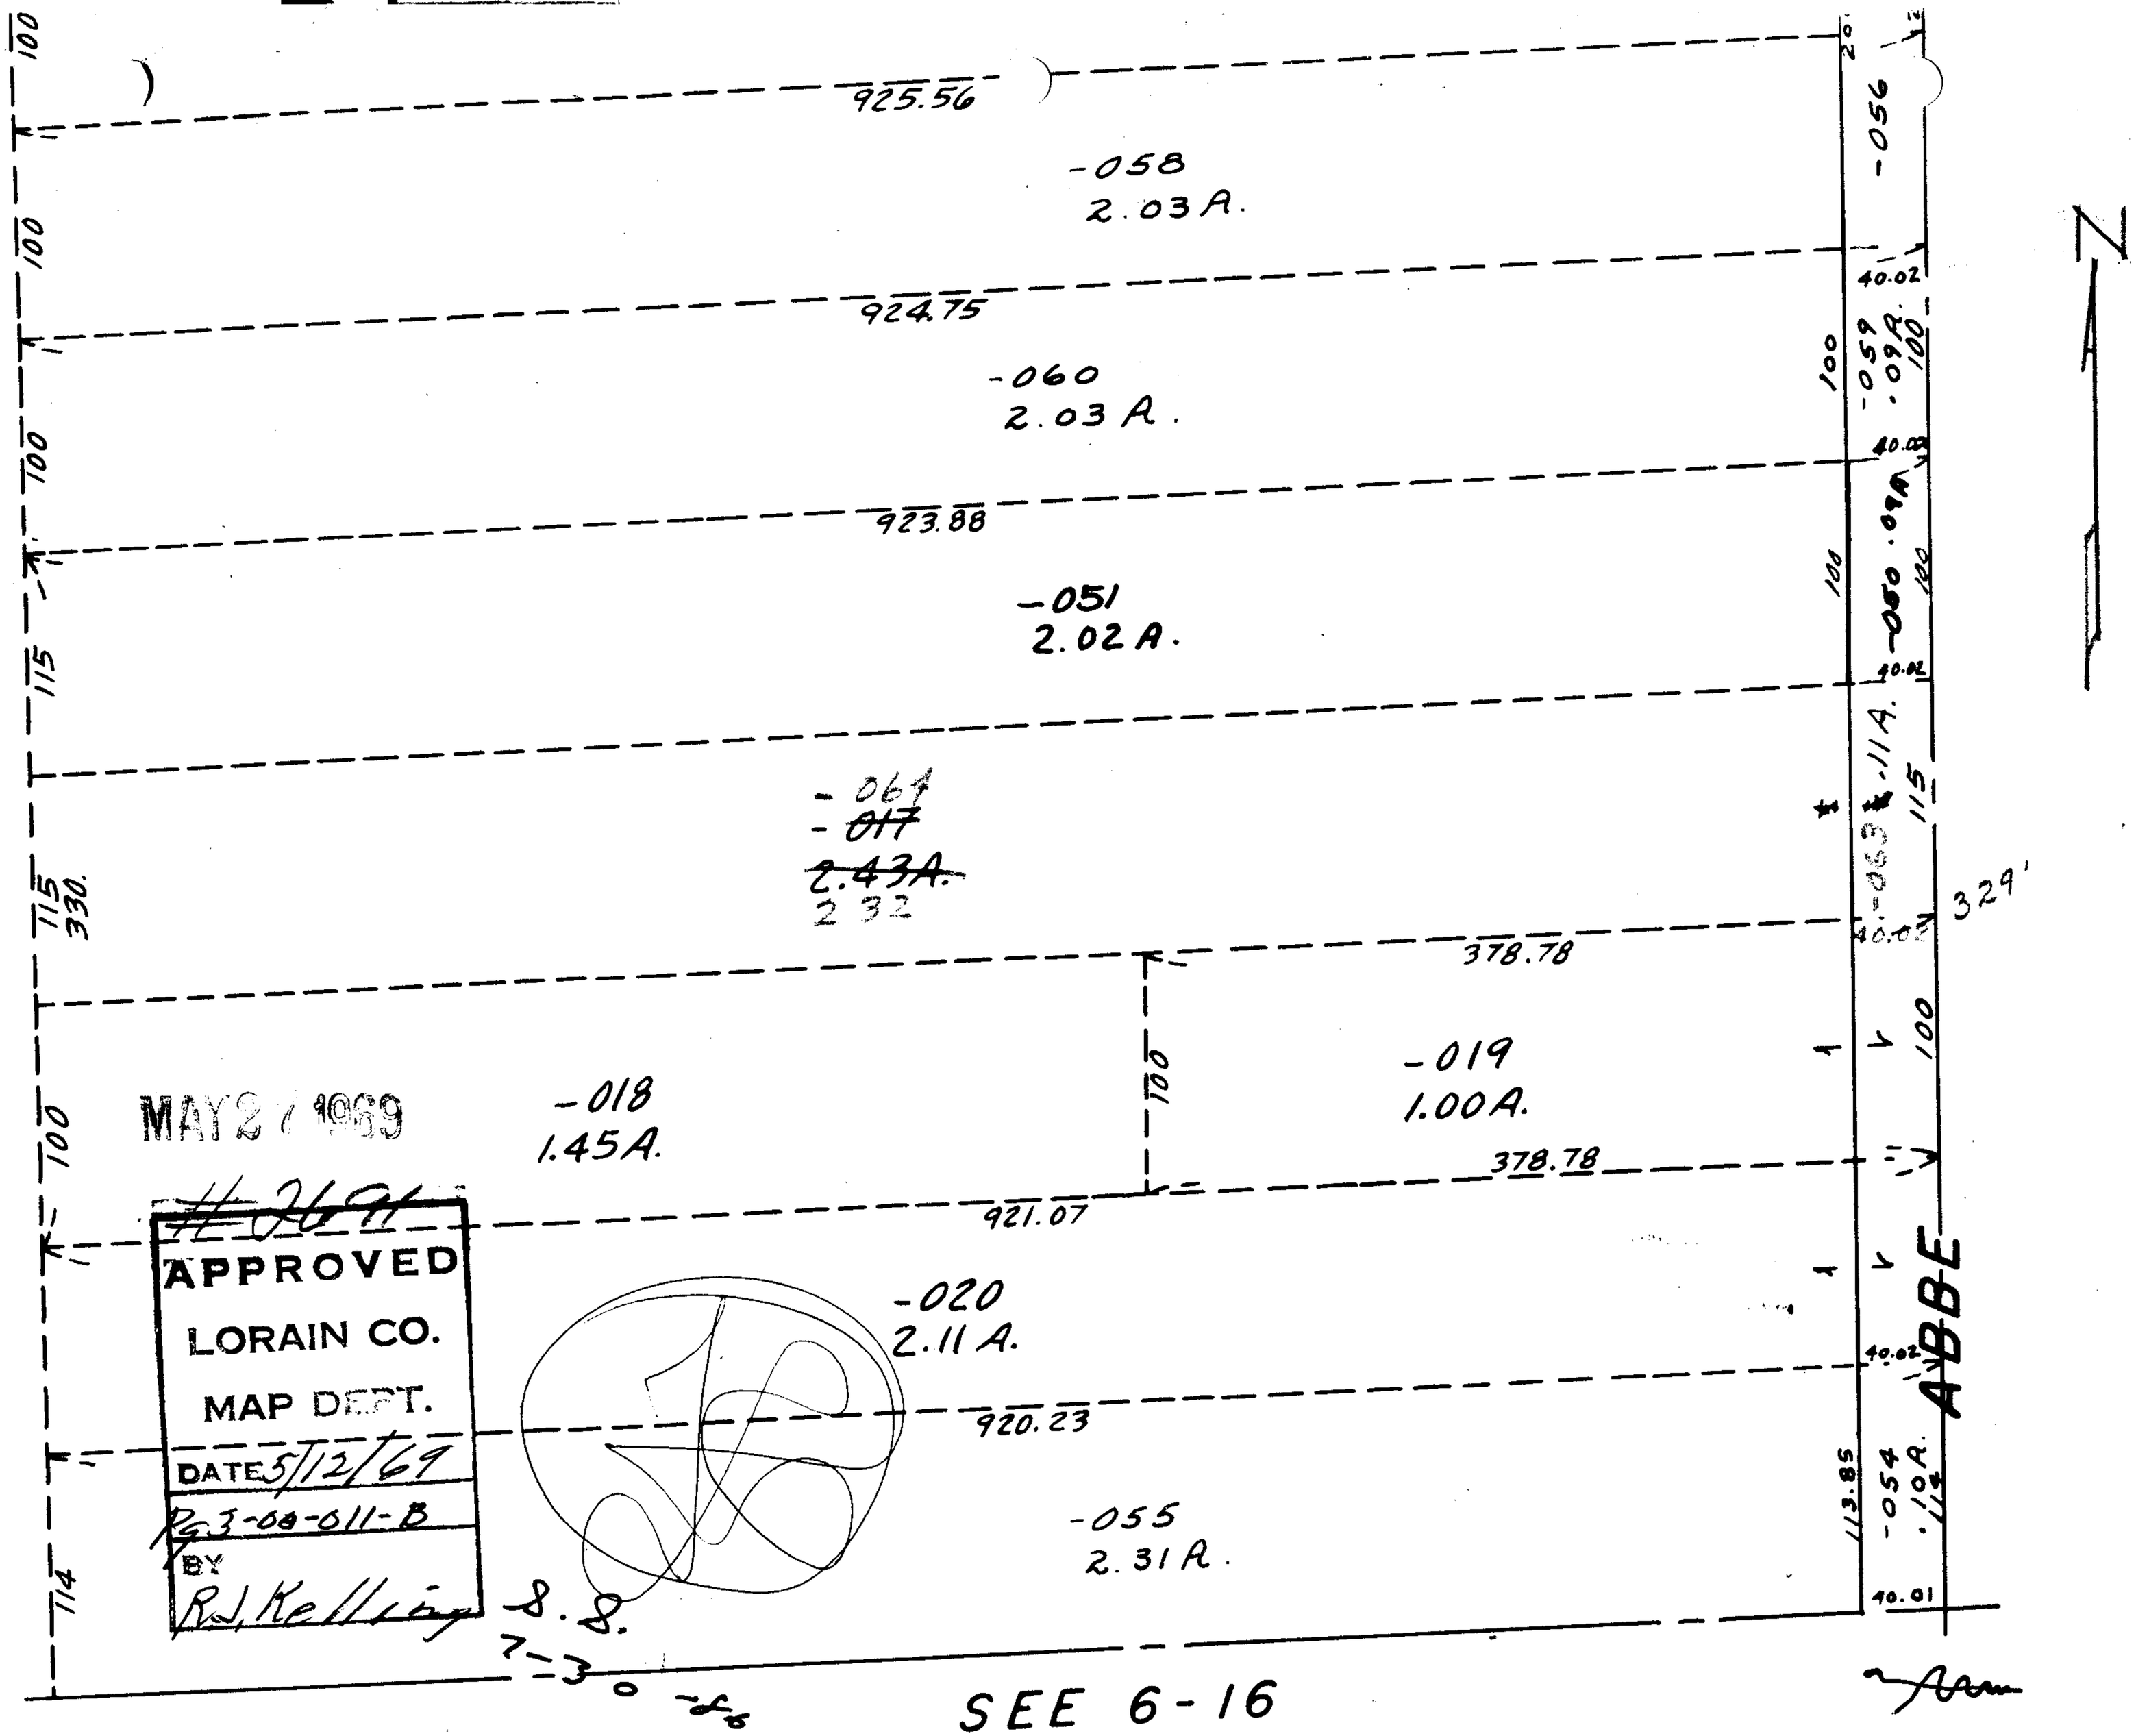

925.56
-058
2.03 A.
924.75
-060
2.03 A.
923.88
-051
2.02 A.
-064
-017
2.43A.
2 32
378.78
-019
1.00A.
-018
1.45A.
378.78
921.07
-020
2.11 A.
920.23
-055
2.31 A.
-056
-059
.09A.
-050
.09A
-063
.11A.
-054
.10A.
113.85
40.02
40.01
100
115
330.
114
329'
ABBE
N
MAY 27 1969
APPROVED
LORAIN CO.
MAP DEPT.
DATE 5/12/69
Pg 3-08-011-B
BY
R.J. Kelling
S.S.
7-30-86
SEE 6-16