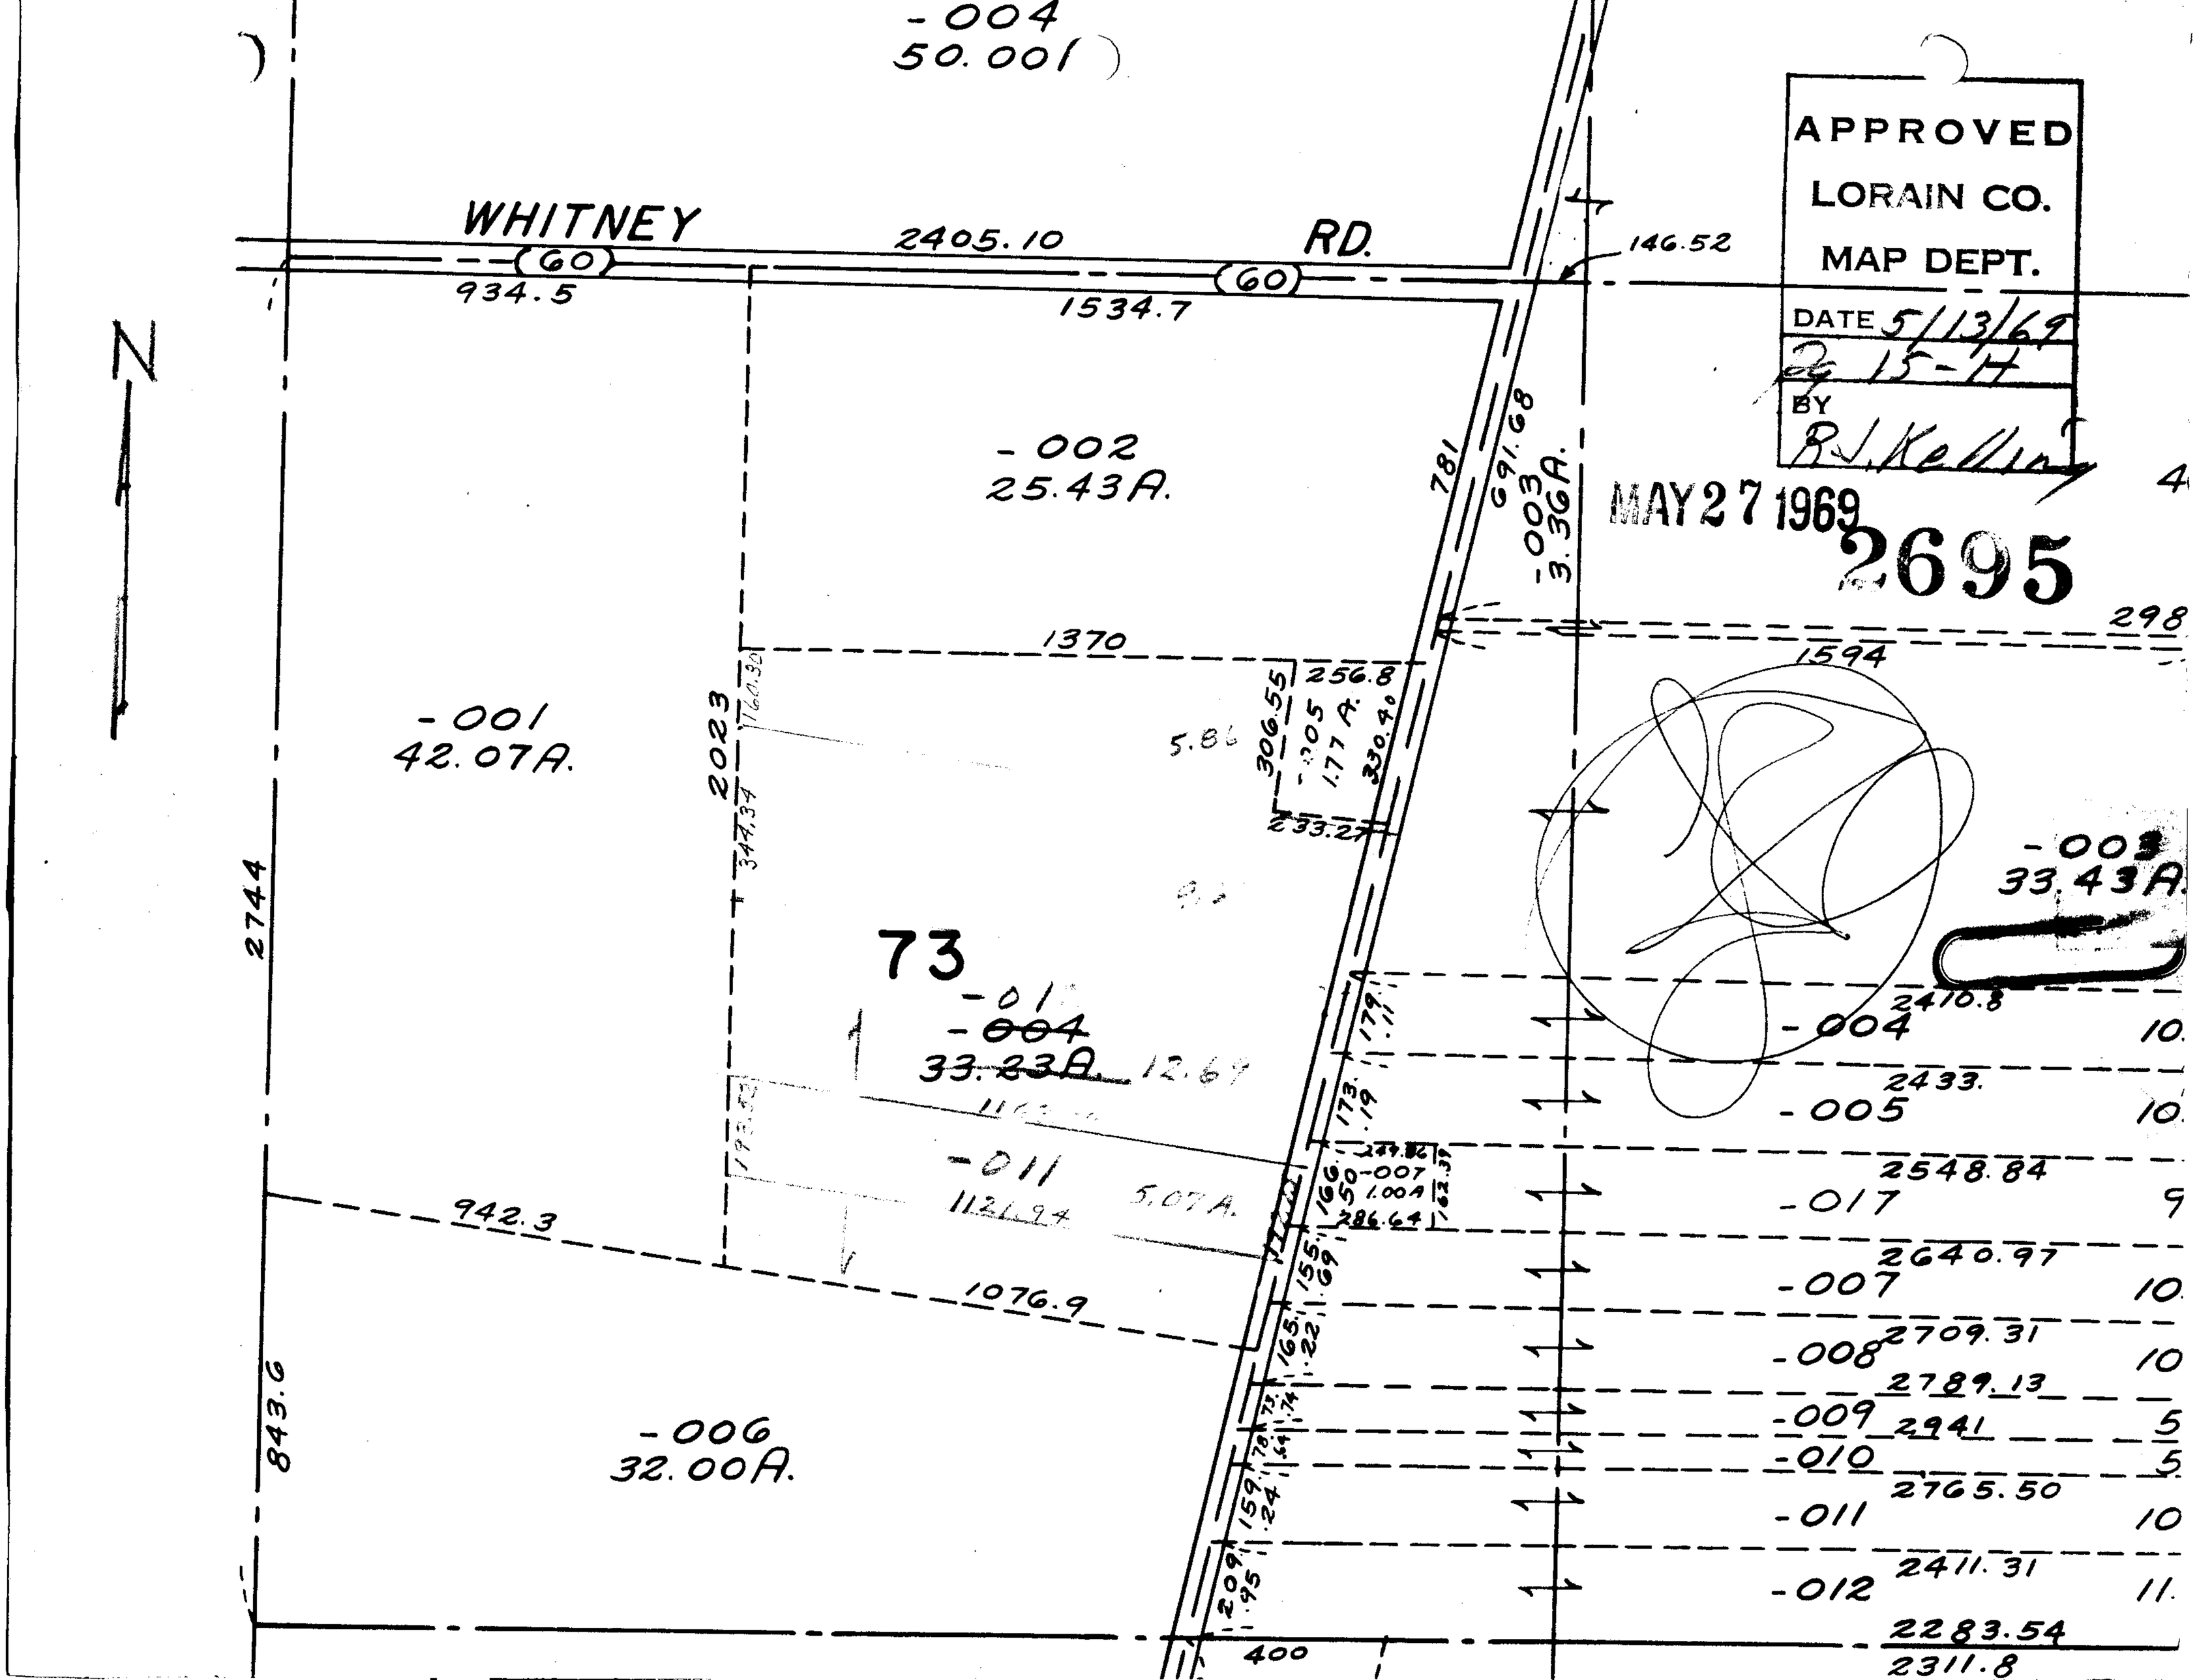

APPROVED
LORAIN CO.
MAP DEPT.
DATE 5/13/69
BY R.J. Kelling
MAY 27 1969
2695
WHITNEY RD.
2405.10
934.5
1534.7
146.52
-004
50.001
-002
25.43A.
-001
42.07A.
-003
3.36A.
-003
33.43A.
-006
32.00A.
-004
33.23A.
-011
1121.94
5.07A.
-007
1.00A
2744
843.6
942.3
1076.9
1370
1594
2023
344.34
781
691.68
256.8
306.55
330.40
233.27
12.69
2410.8
2433.
2548.84
2640.97
2709.31
2789.13
2941
2765.50
2411.31
2283.54
2311.8
400
73