


SEE 6-34

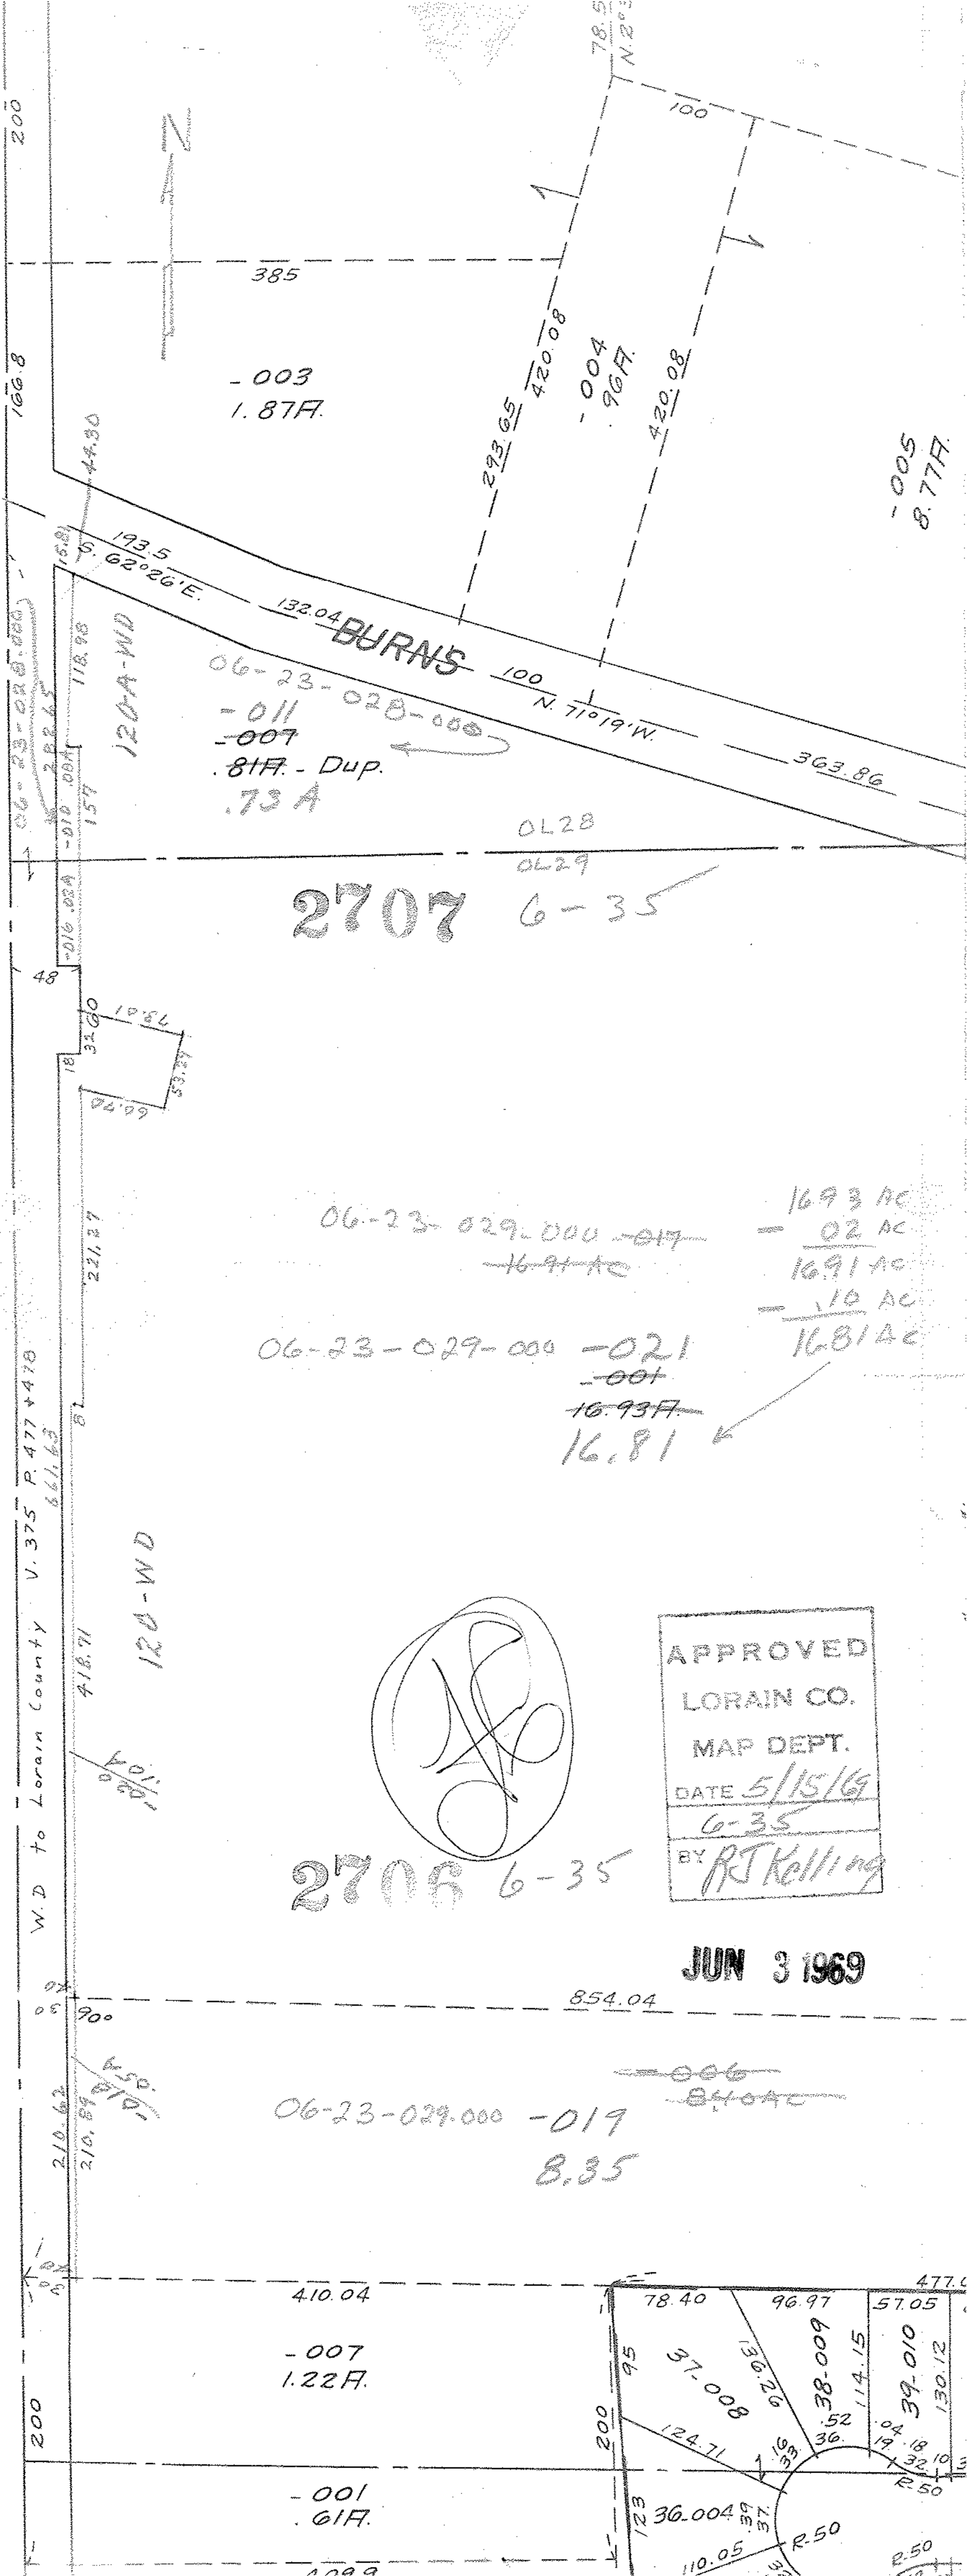

-003
1.87F.

06-23-028-000
-011
-007
81F. - Dup.
.73 A

2707

6-35

06-23-029-000 -017
~~16.91 AC~~
06-23-029-000 -021
-001
~~16.93F.~~
16.81

16.93 AC
- 02 AC
16.91 AC
- 10 AC
16.81 AC

[Handwritten Signature]

2706 6-35

APPROVED
LORAIN CO.
MAP DEPT.
DATE 5/15/69
6-35
BY RT Kelling

JUN 3 1969

06-23-029-000 -019
~~8.40 AC~~
8.35

410.04
-007
1.22F.

-001
61F.

