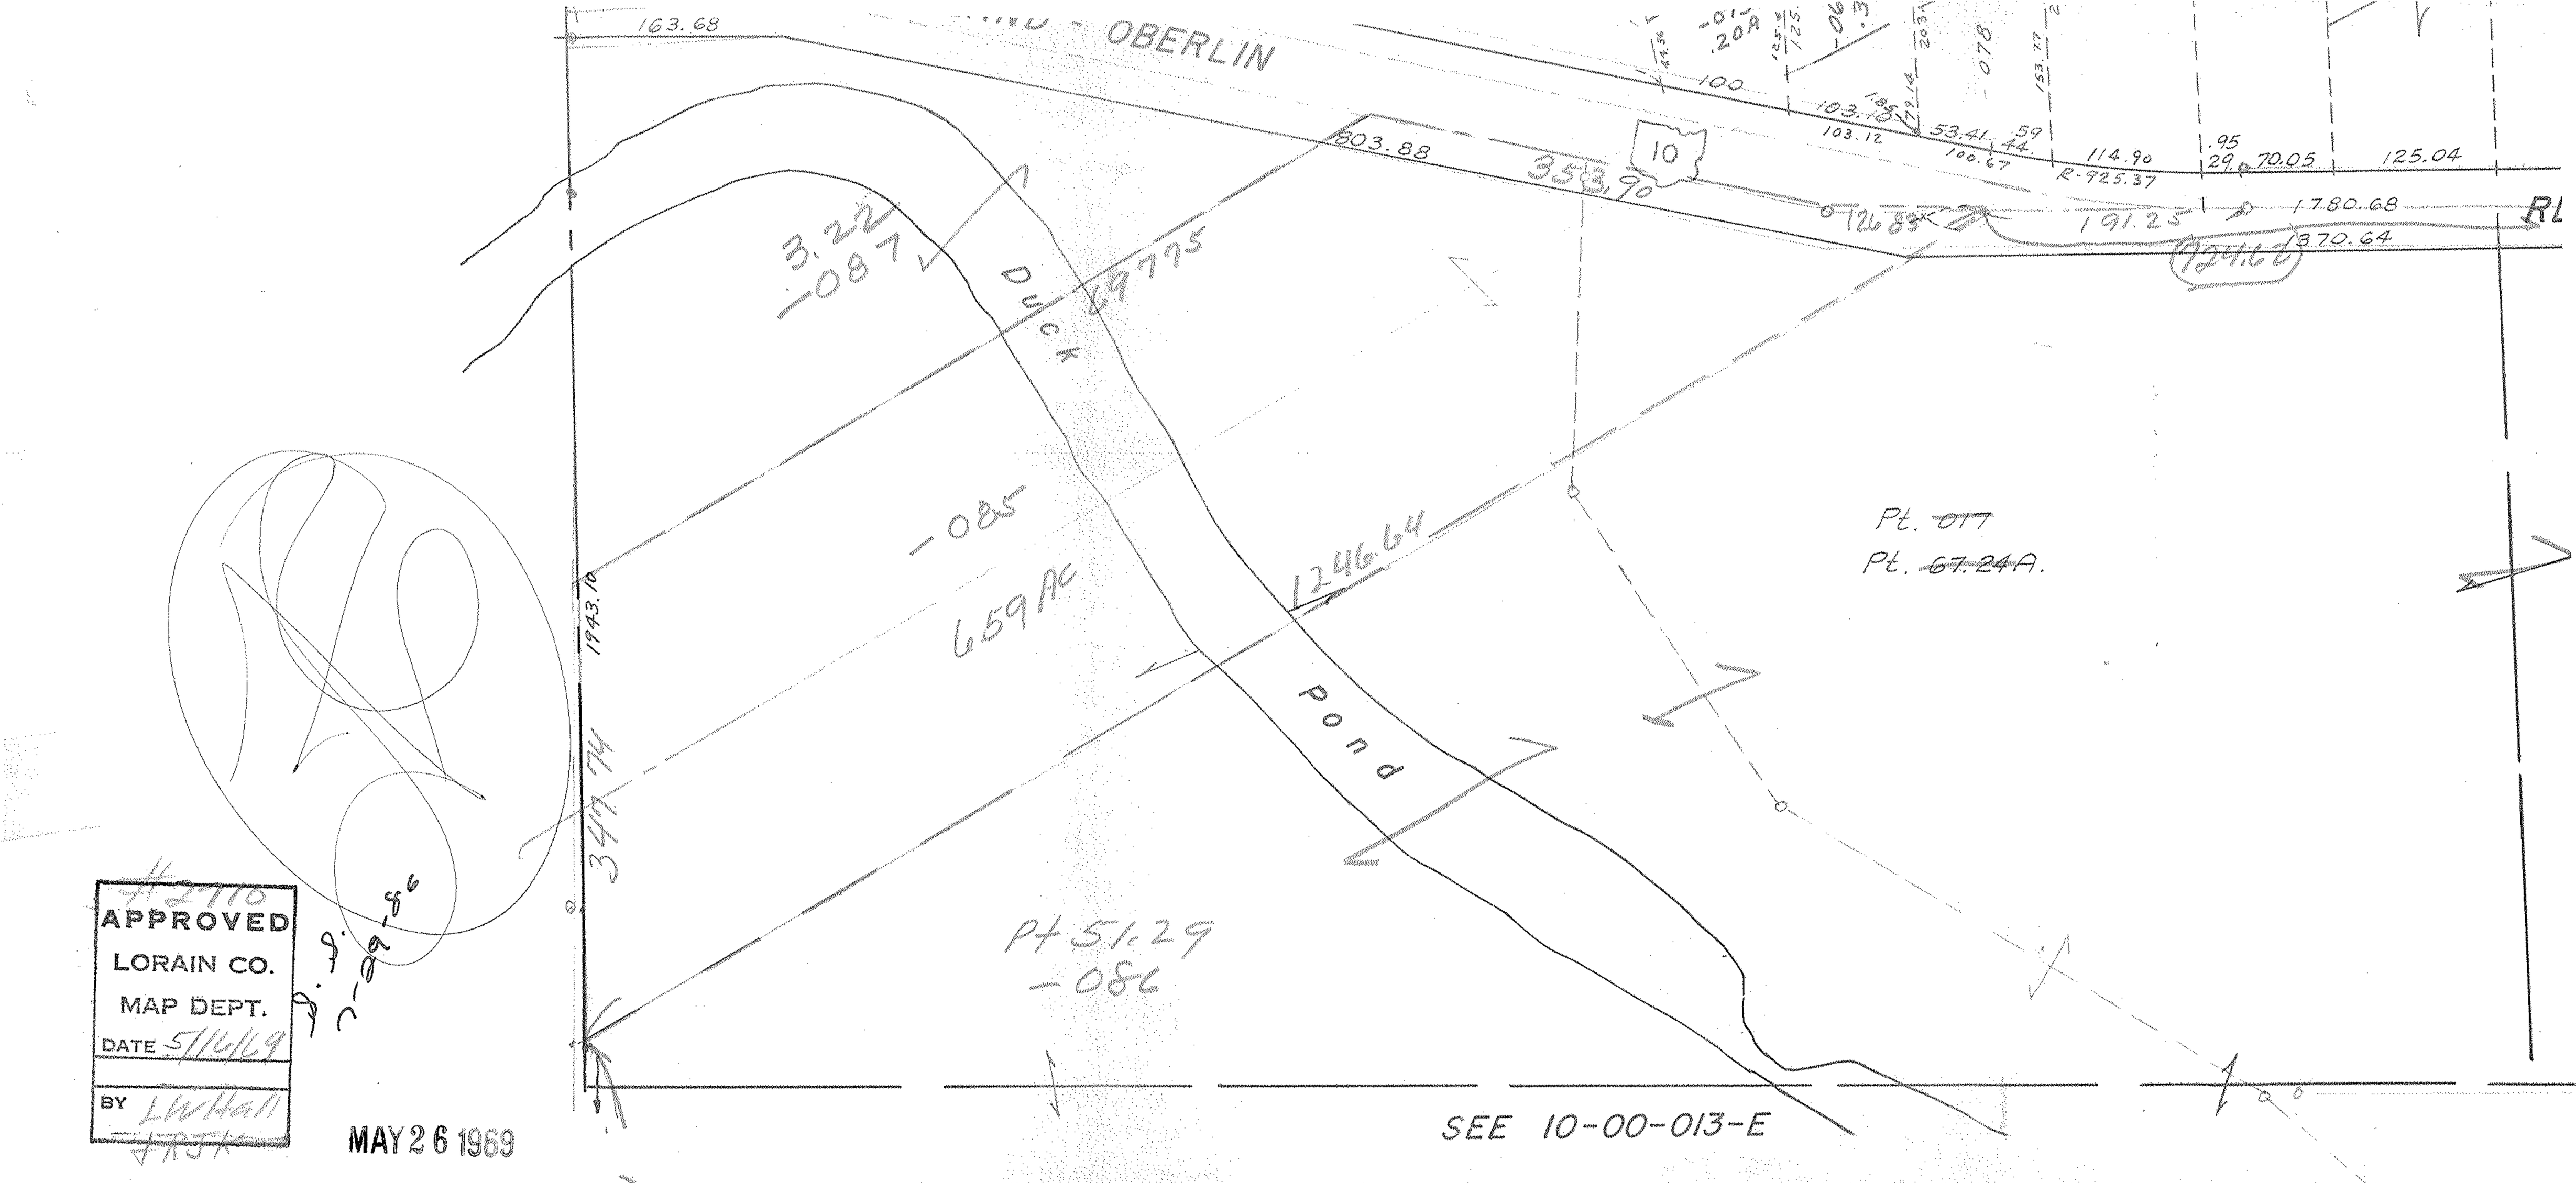

APPROVED
LORAIN CO.
MAP DEPT.
DATE 5/16/69
BY LWHall

MAY 26 1969

Copyright 1963
Revised

CARLISLE TWP.

10-00-013-A

SCALE: 1" = 100'

W. 1/2 N.W. 1/4 SEC. 13