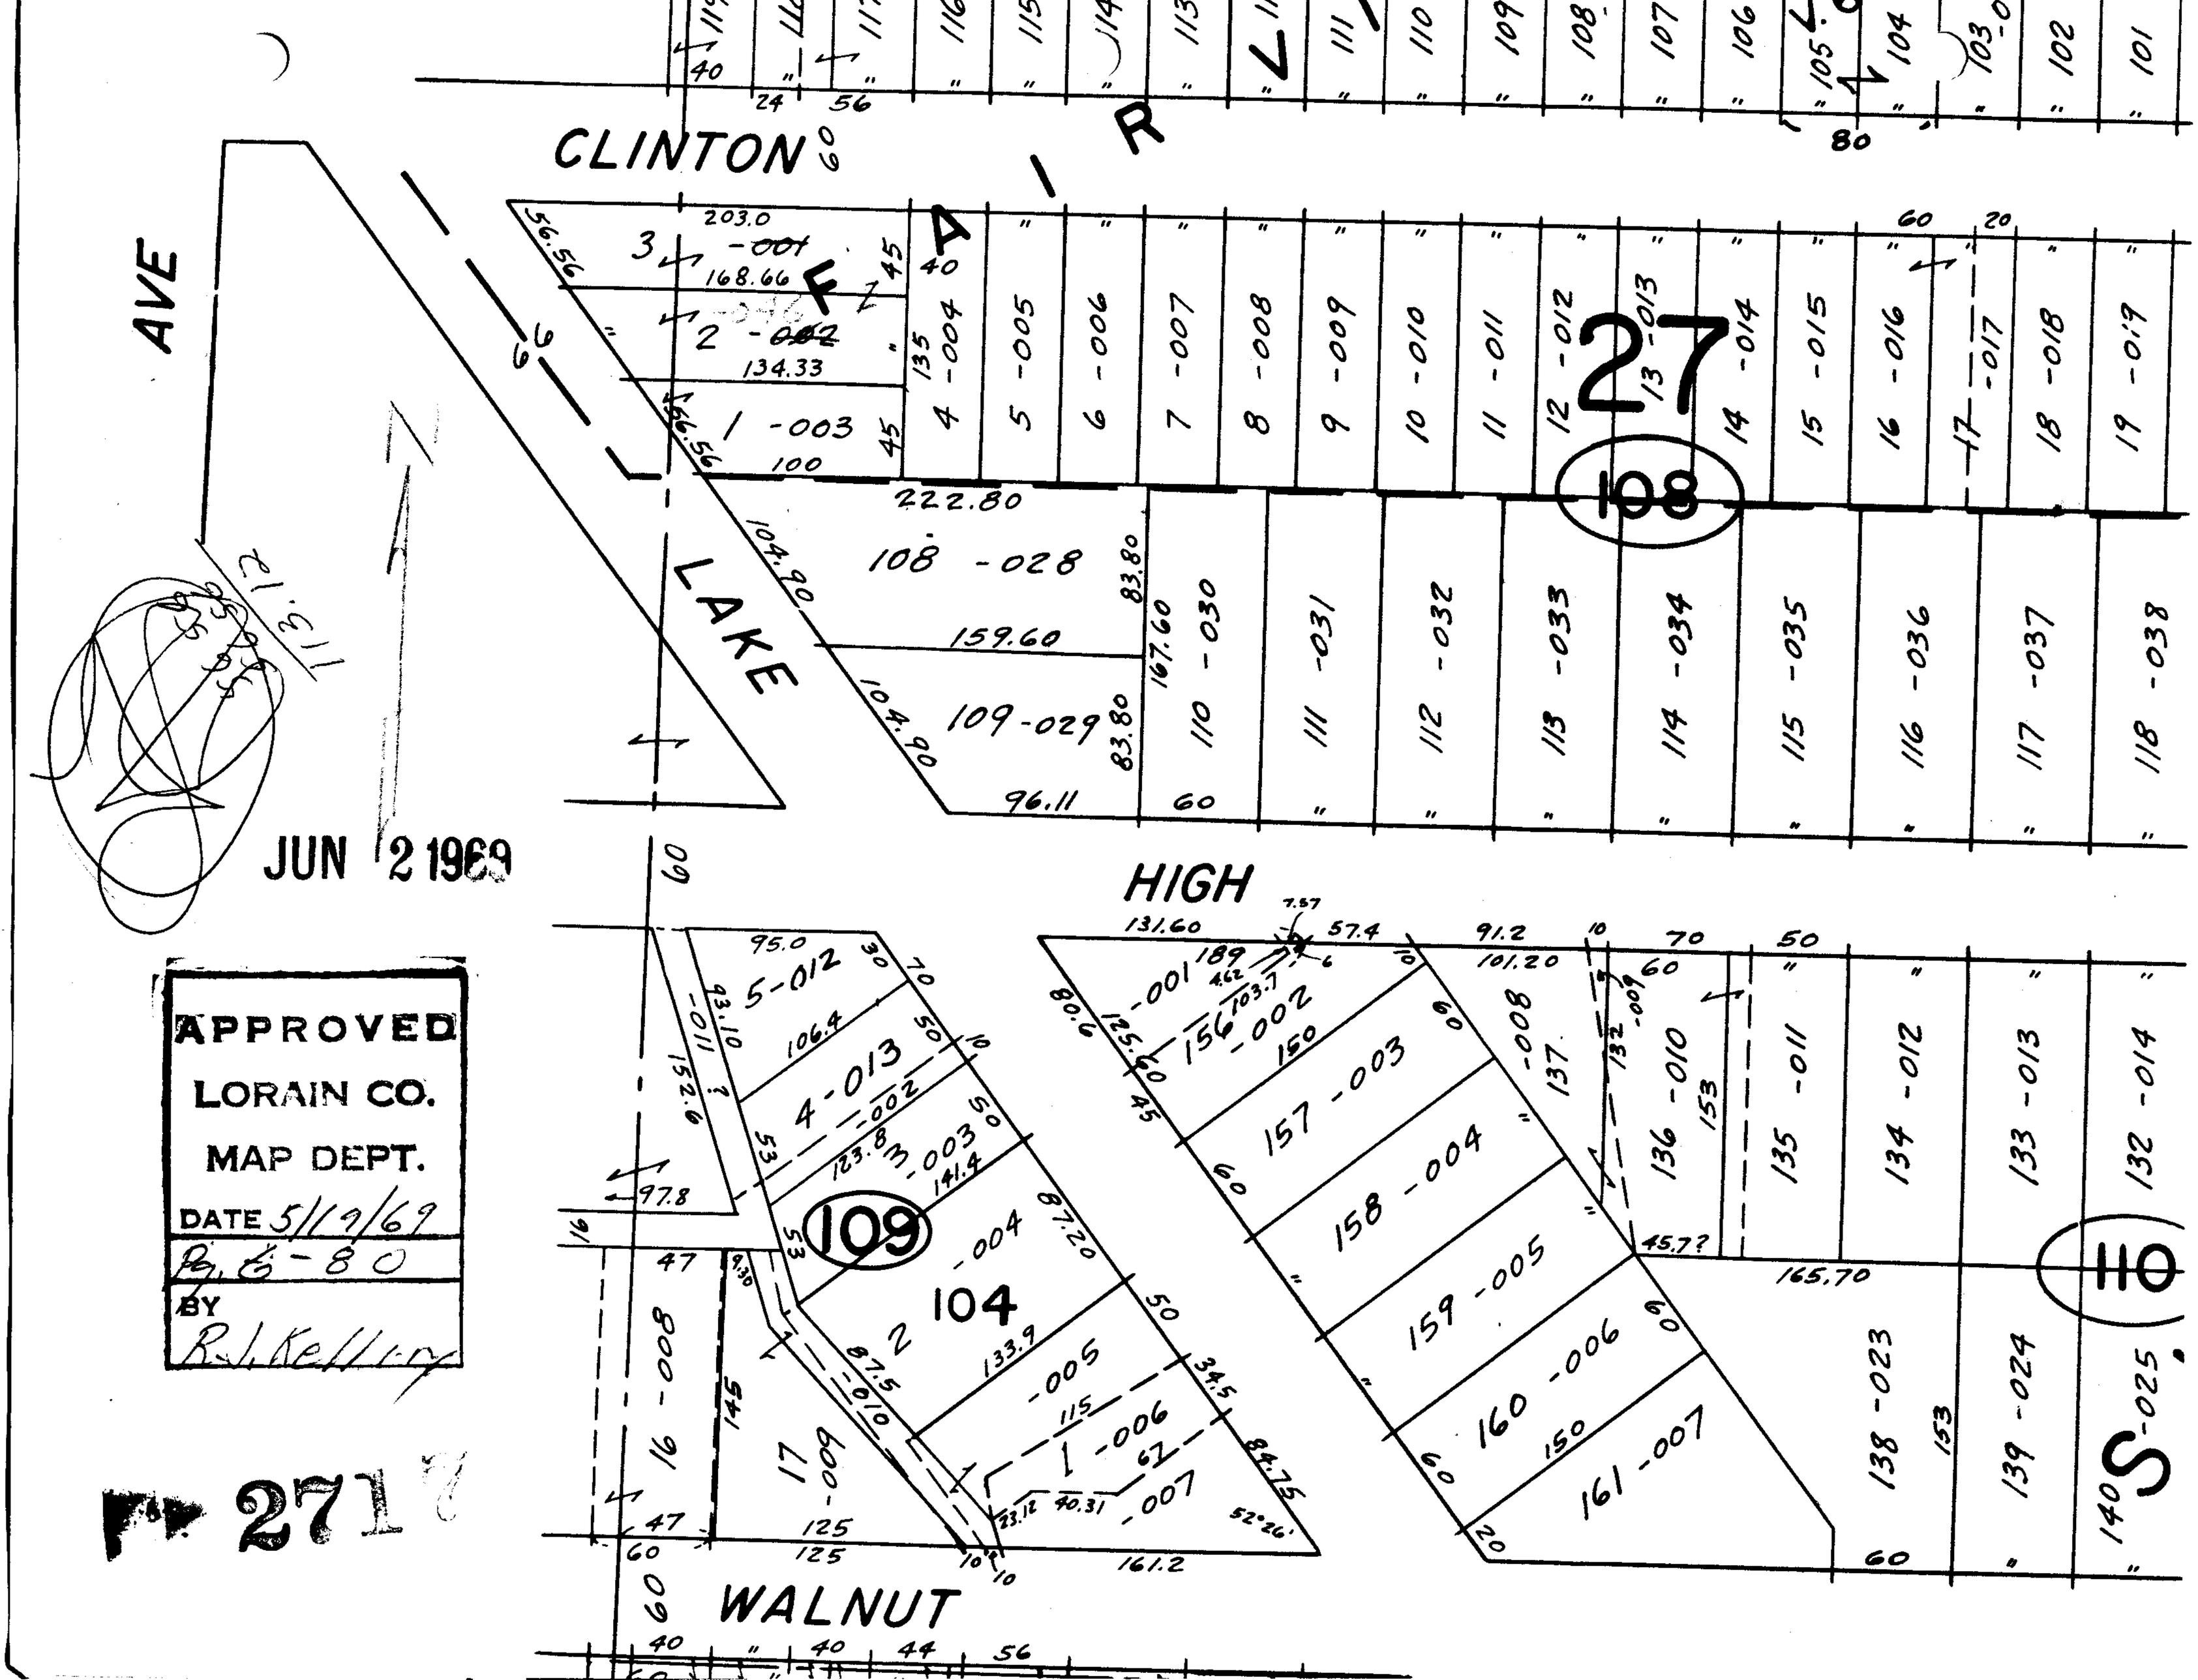
CLINTON
FAIRLAND
AVE
LAKE
HIGH
WALNUT
27
108
109
110
JUN 2 1969
APPROVED
LORAIN CO.
MAP DEPT.
DATE 5/19/69
Pg. 6-80
BY
R.J. Kelley
2717