


ELMWOOD

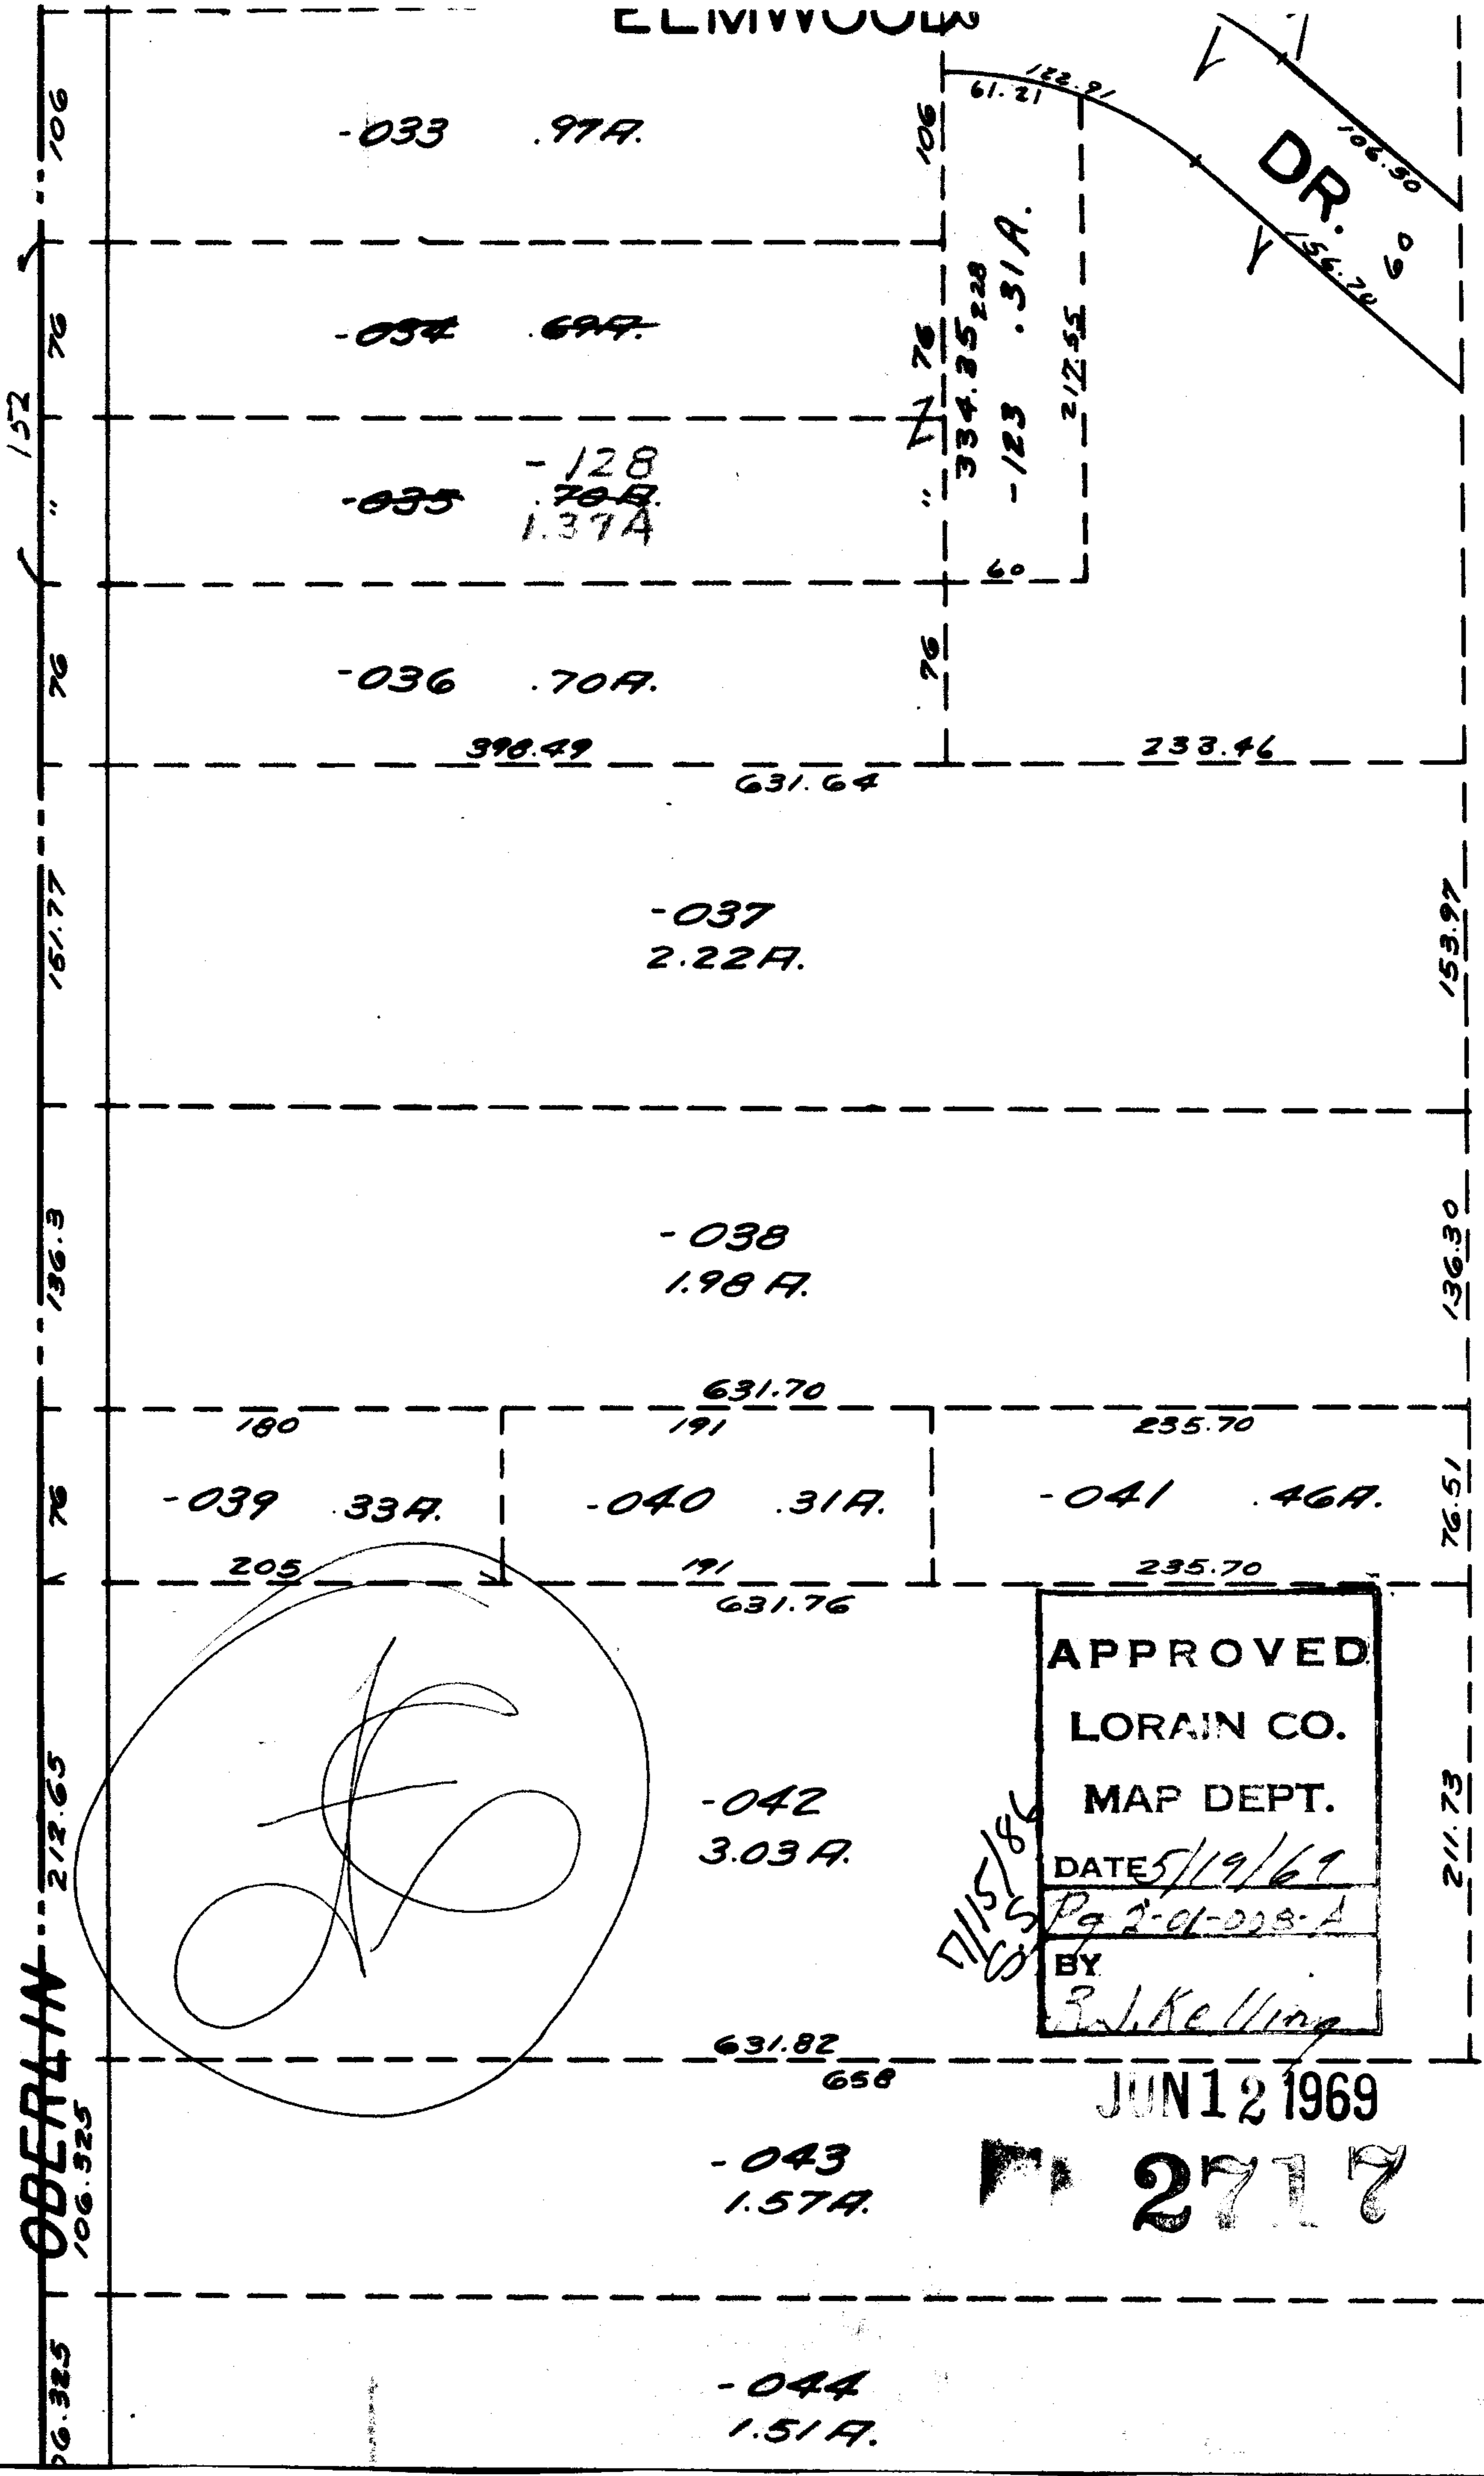

APPROVED
LORAIN CO.
MAP DEPT.
DATE 5/19/69
Pg 2 of 208-A
BY
R. L. Kelling

7/15/86
65

JUN 12 1969

2717

01-784