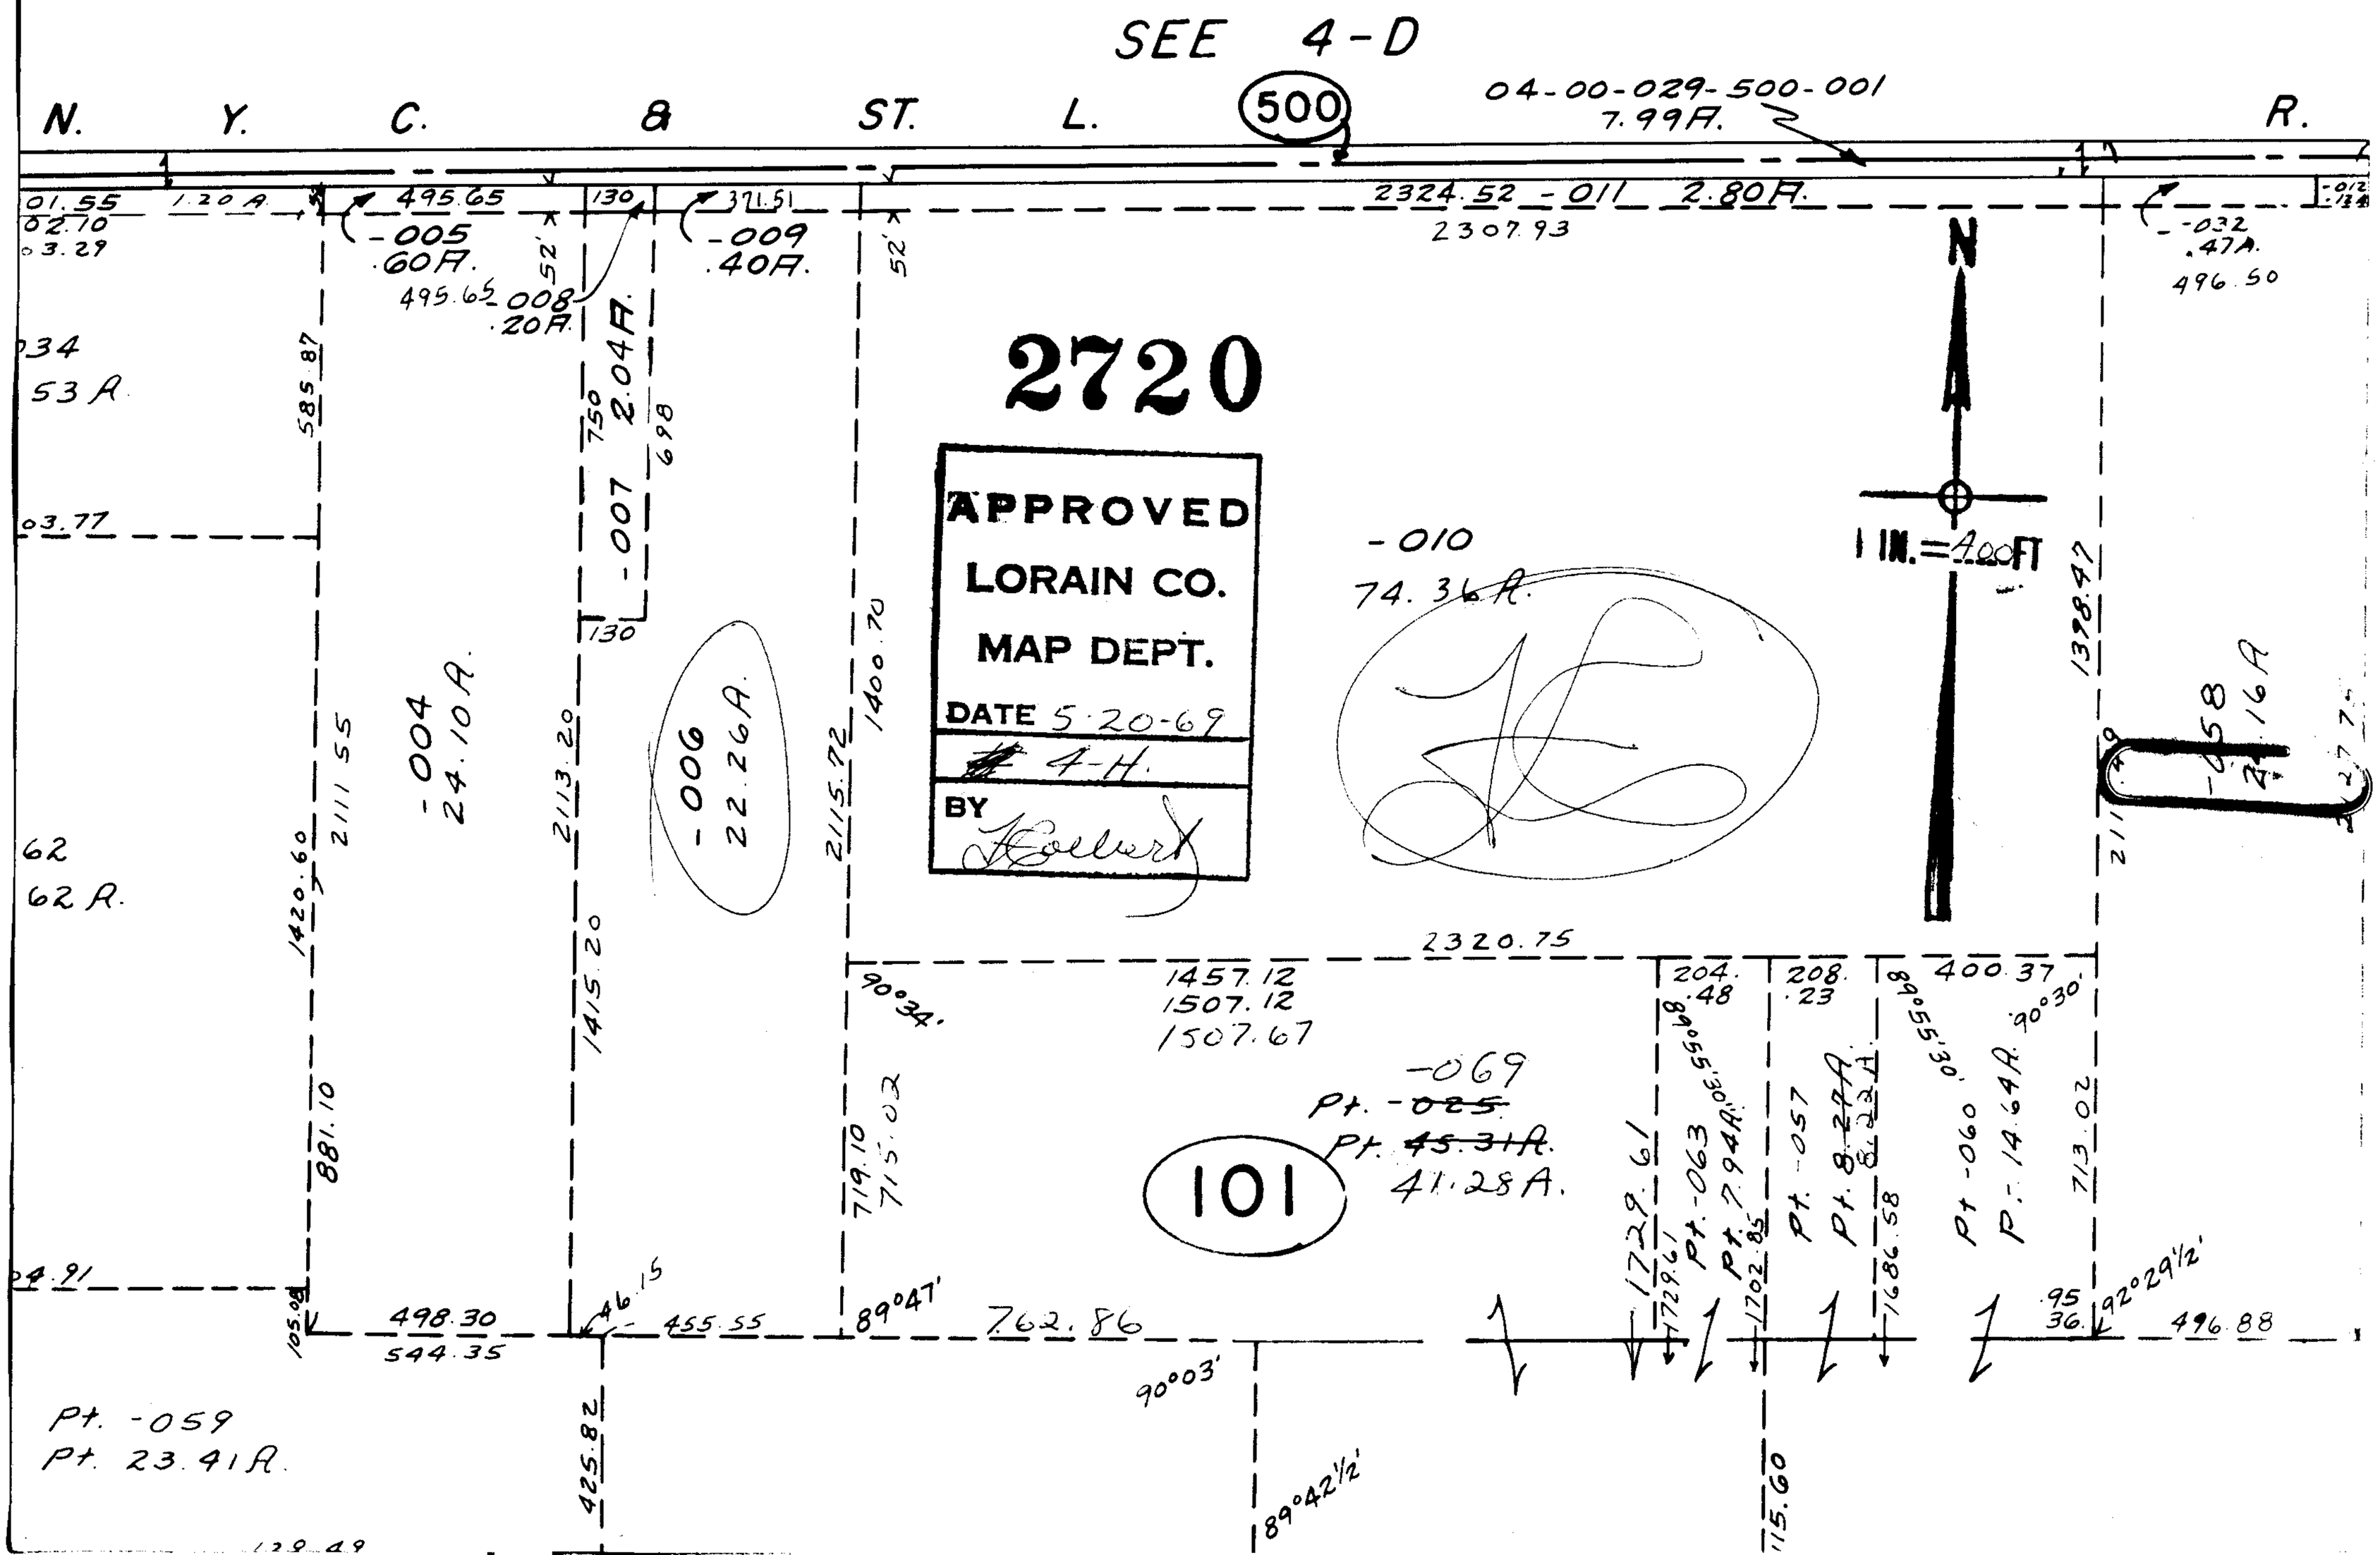
SEE 4-D
N. Y. C. & ST. L. R.
500
04-00-029-500-001
7.99A.
2324.52 -011 2.80A.
2307.93
-005
.60A.
495.65
-008
.20A.
-009
.40A.
-032
.47A.
496.50
2720
APPROVED
LORAIN CO.
MAP DEPT.
DATE 5-20-69
4-H.
BY
-010
74.36A.
1 IN.=400FT
-004
24.10A.
-006
22.26A.
-007
2.04A.
-058
24.16A
2320.75
1457.12
1507.12
1507.67
-069
Pt. -025
Pt. 45.31A.
41.28A.
101
Pt. -063
Pt. 7.94A.
Pt. -057
Pt. 8.27A.
Pt. -060
Pt. 14.64A.
Pt. -059
Pt. 23.41A.
498.30
544.35
455.55
762.86
496.88
89°47'
90°03'
89°42½'
92°29½'
89°55'30'
90°30'
1400.70
2115.72
2113.20
1415.20
2111.55
1420.60
881.10
585.87
1398.47
713.02
715.02
719.10
1729.61
1702.85
1686.58
1115.60
425.82
46.15
105.08
53 A.
62
62 A.