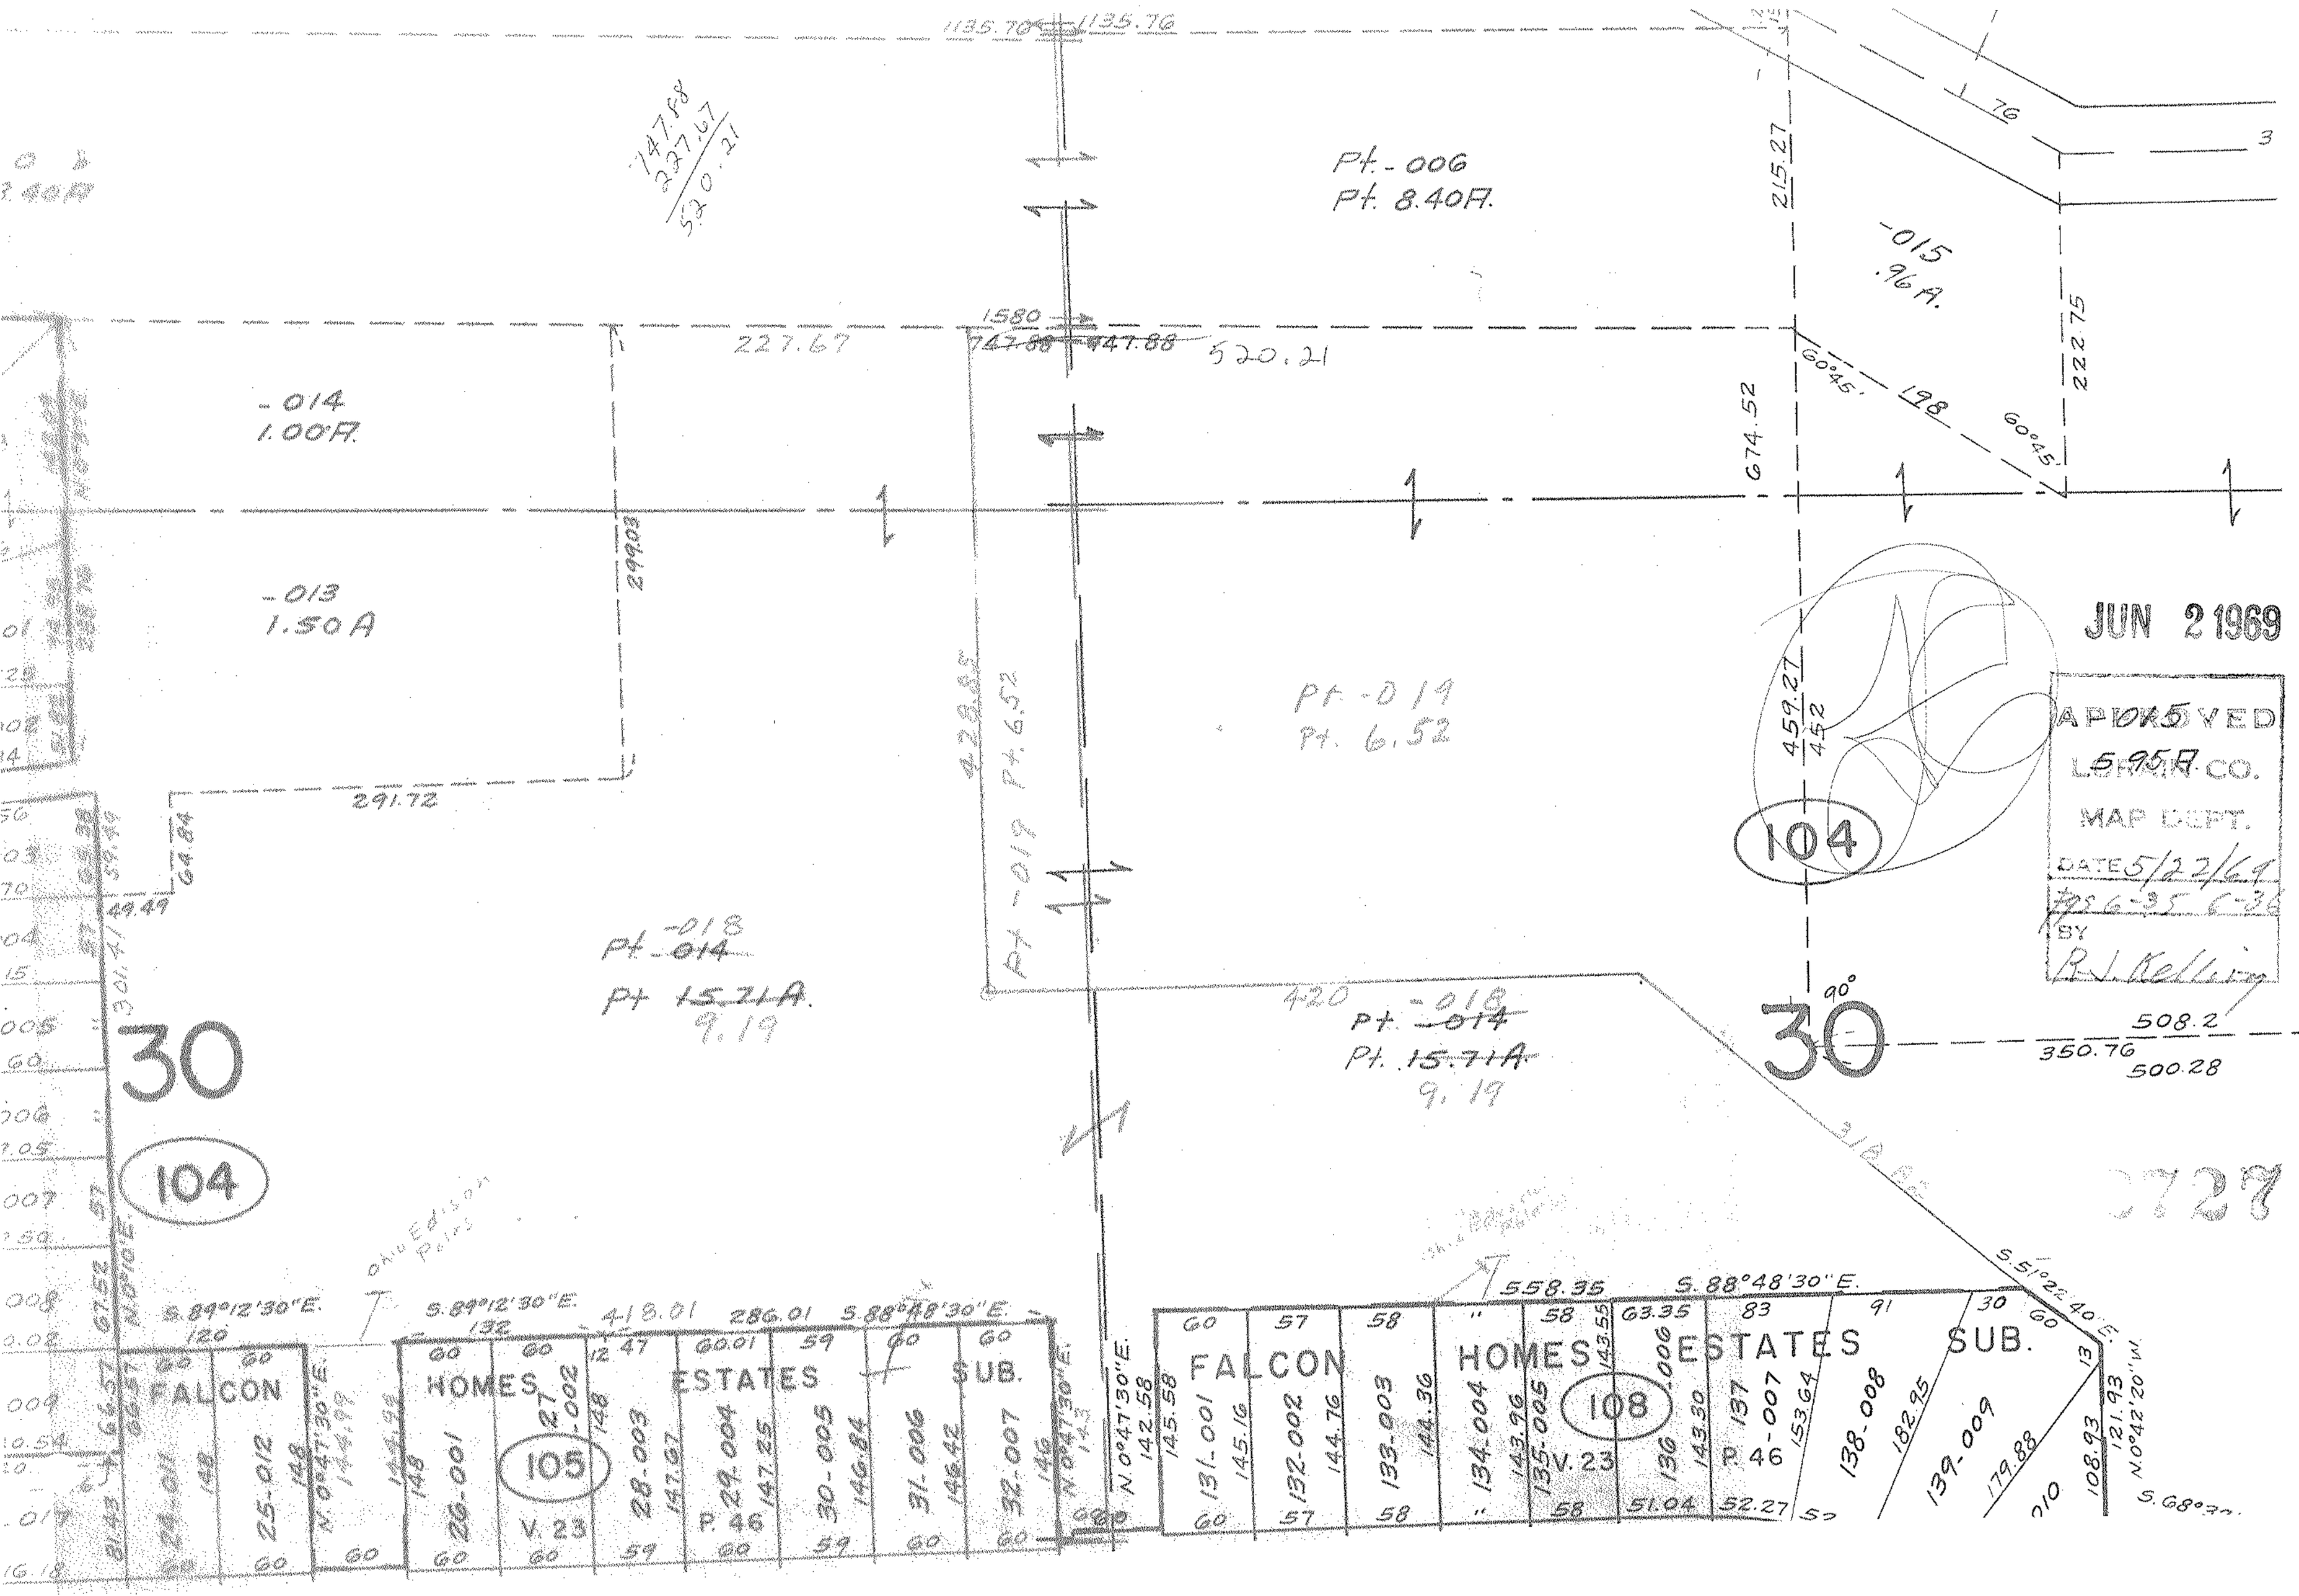

1135.76
1135.76
747.88
227.67
520.21
Pt.-006
Pt. 8.40A.
215.27
-015
.96A.
222.75
1580
747.88
747.88
520.21
227.67
-014
1.00A.
-013
1.50A
299.03
674.52
60°45'
198
60°45'
JUN 2 1969
APPROVED
LORAIN CO.
MAP DEPT.
DATE 5/22/69
BY
R.J. Kelling
Pt.-019
Pt. 6.52
459.27
452
104
291.72
428.85
Pt. 6.52
Pt.-019
Pt.-018
Pt. 15.71A.
9.19
420
Pt.-018
Pt. 15.71A.
9.19
90°
30
508.2
350.76
500.28
30
104
318.85
S.51°22'40"E.
S.89°12'30"E.
S.89°12'30"E.
418.01
286.01
S.88°48'30"E.
558.35
S.88°48'30"E.
FALCON
HOMES
ESTATES
SUB.
105
V. 23
P. 46
108
V. 23
P. 46
25-012
26-001
27-002
28-003
29-004
30-005
31-006
32-007
131-001
132-002
133-003
134-004
135-005
136-006
137-007
138-008
139-009
N.0°47'30"E.
N.0°42'20"W.
S.68°30'