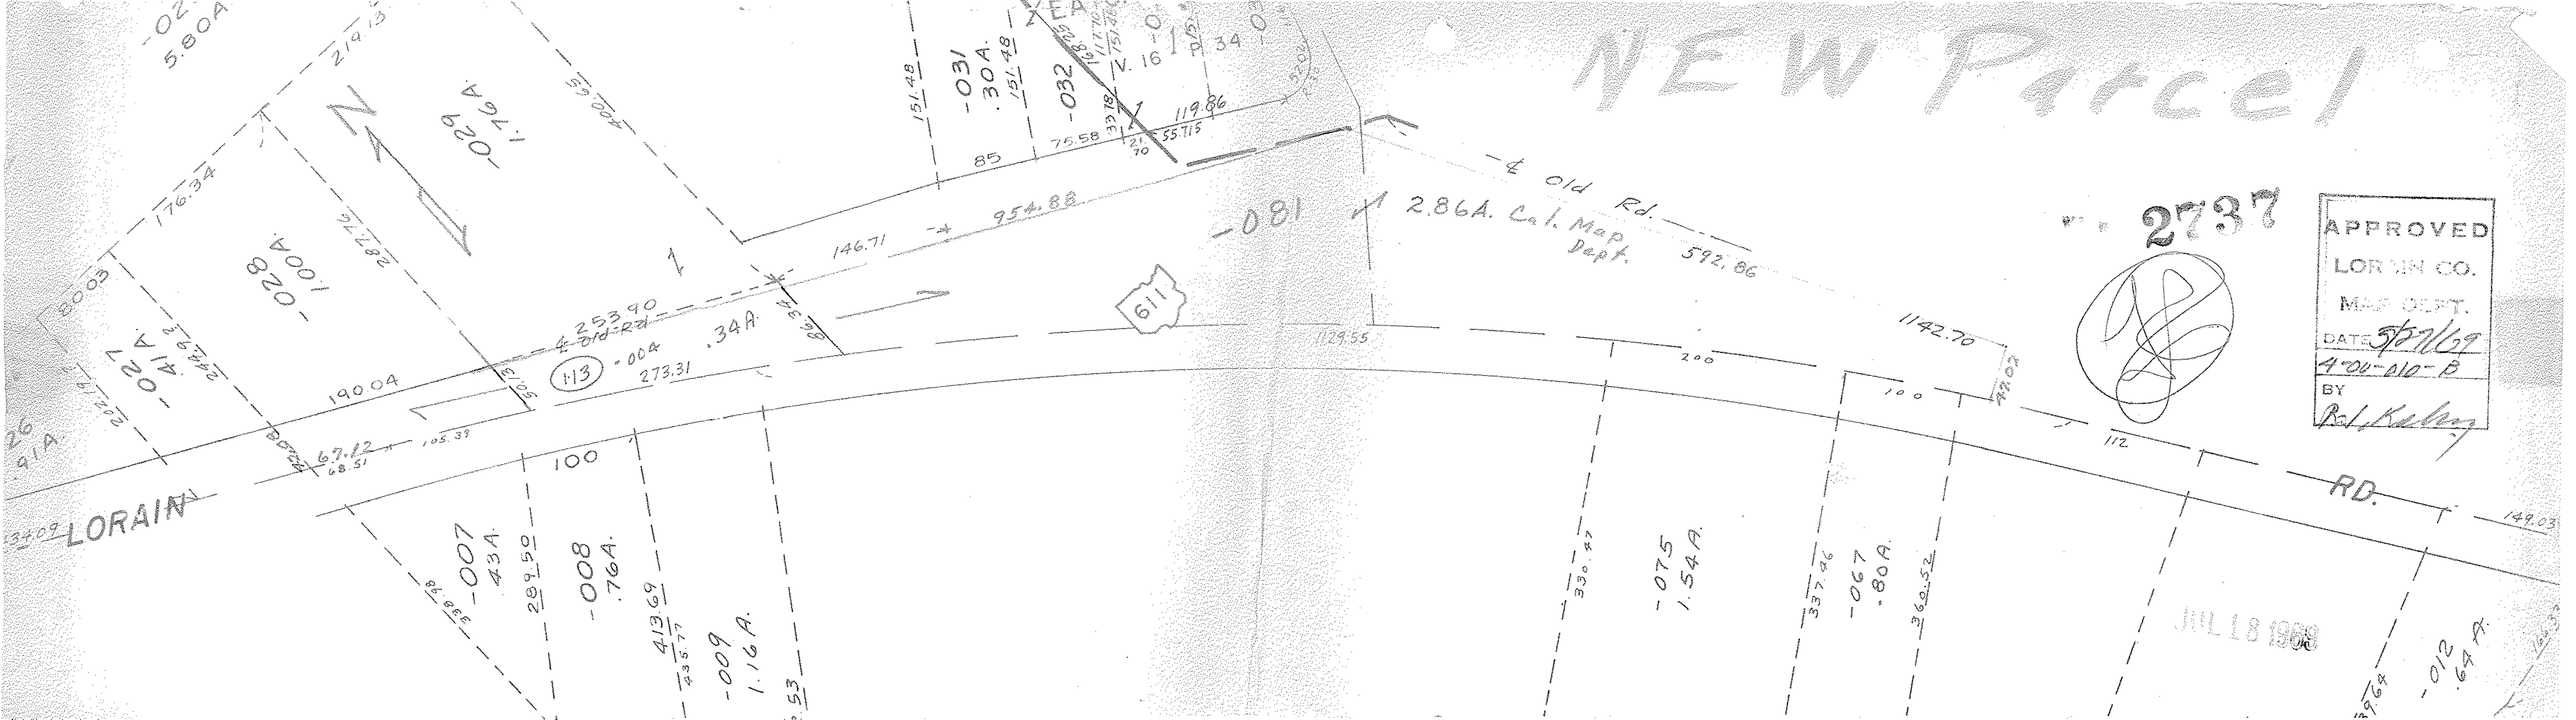
NEW Parcel
2737
APPROVED
LORAIN CO.
MAP DEPT.
DATE 5/27/69
4-00-010-B
BY
-029
5.80A.
-031
.30A.
-032
-081
2.86A. Cal. Map Dept.
-004
.34A.
-007
.43A.
-008
.76A.
-009
1.16A.
-075
1.54A.
-067
.80A.
-012
.64A.
611
LORAIN RD.
OLD Rd.
JUL 18 1969