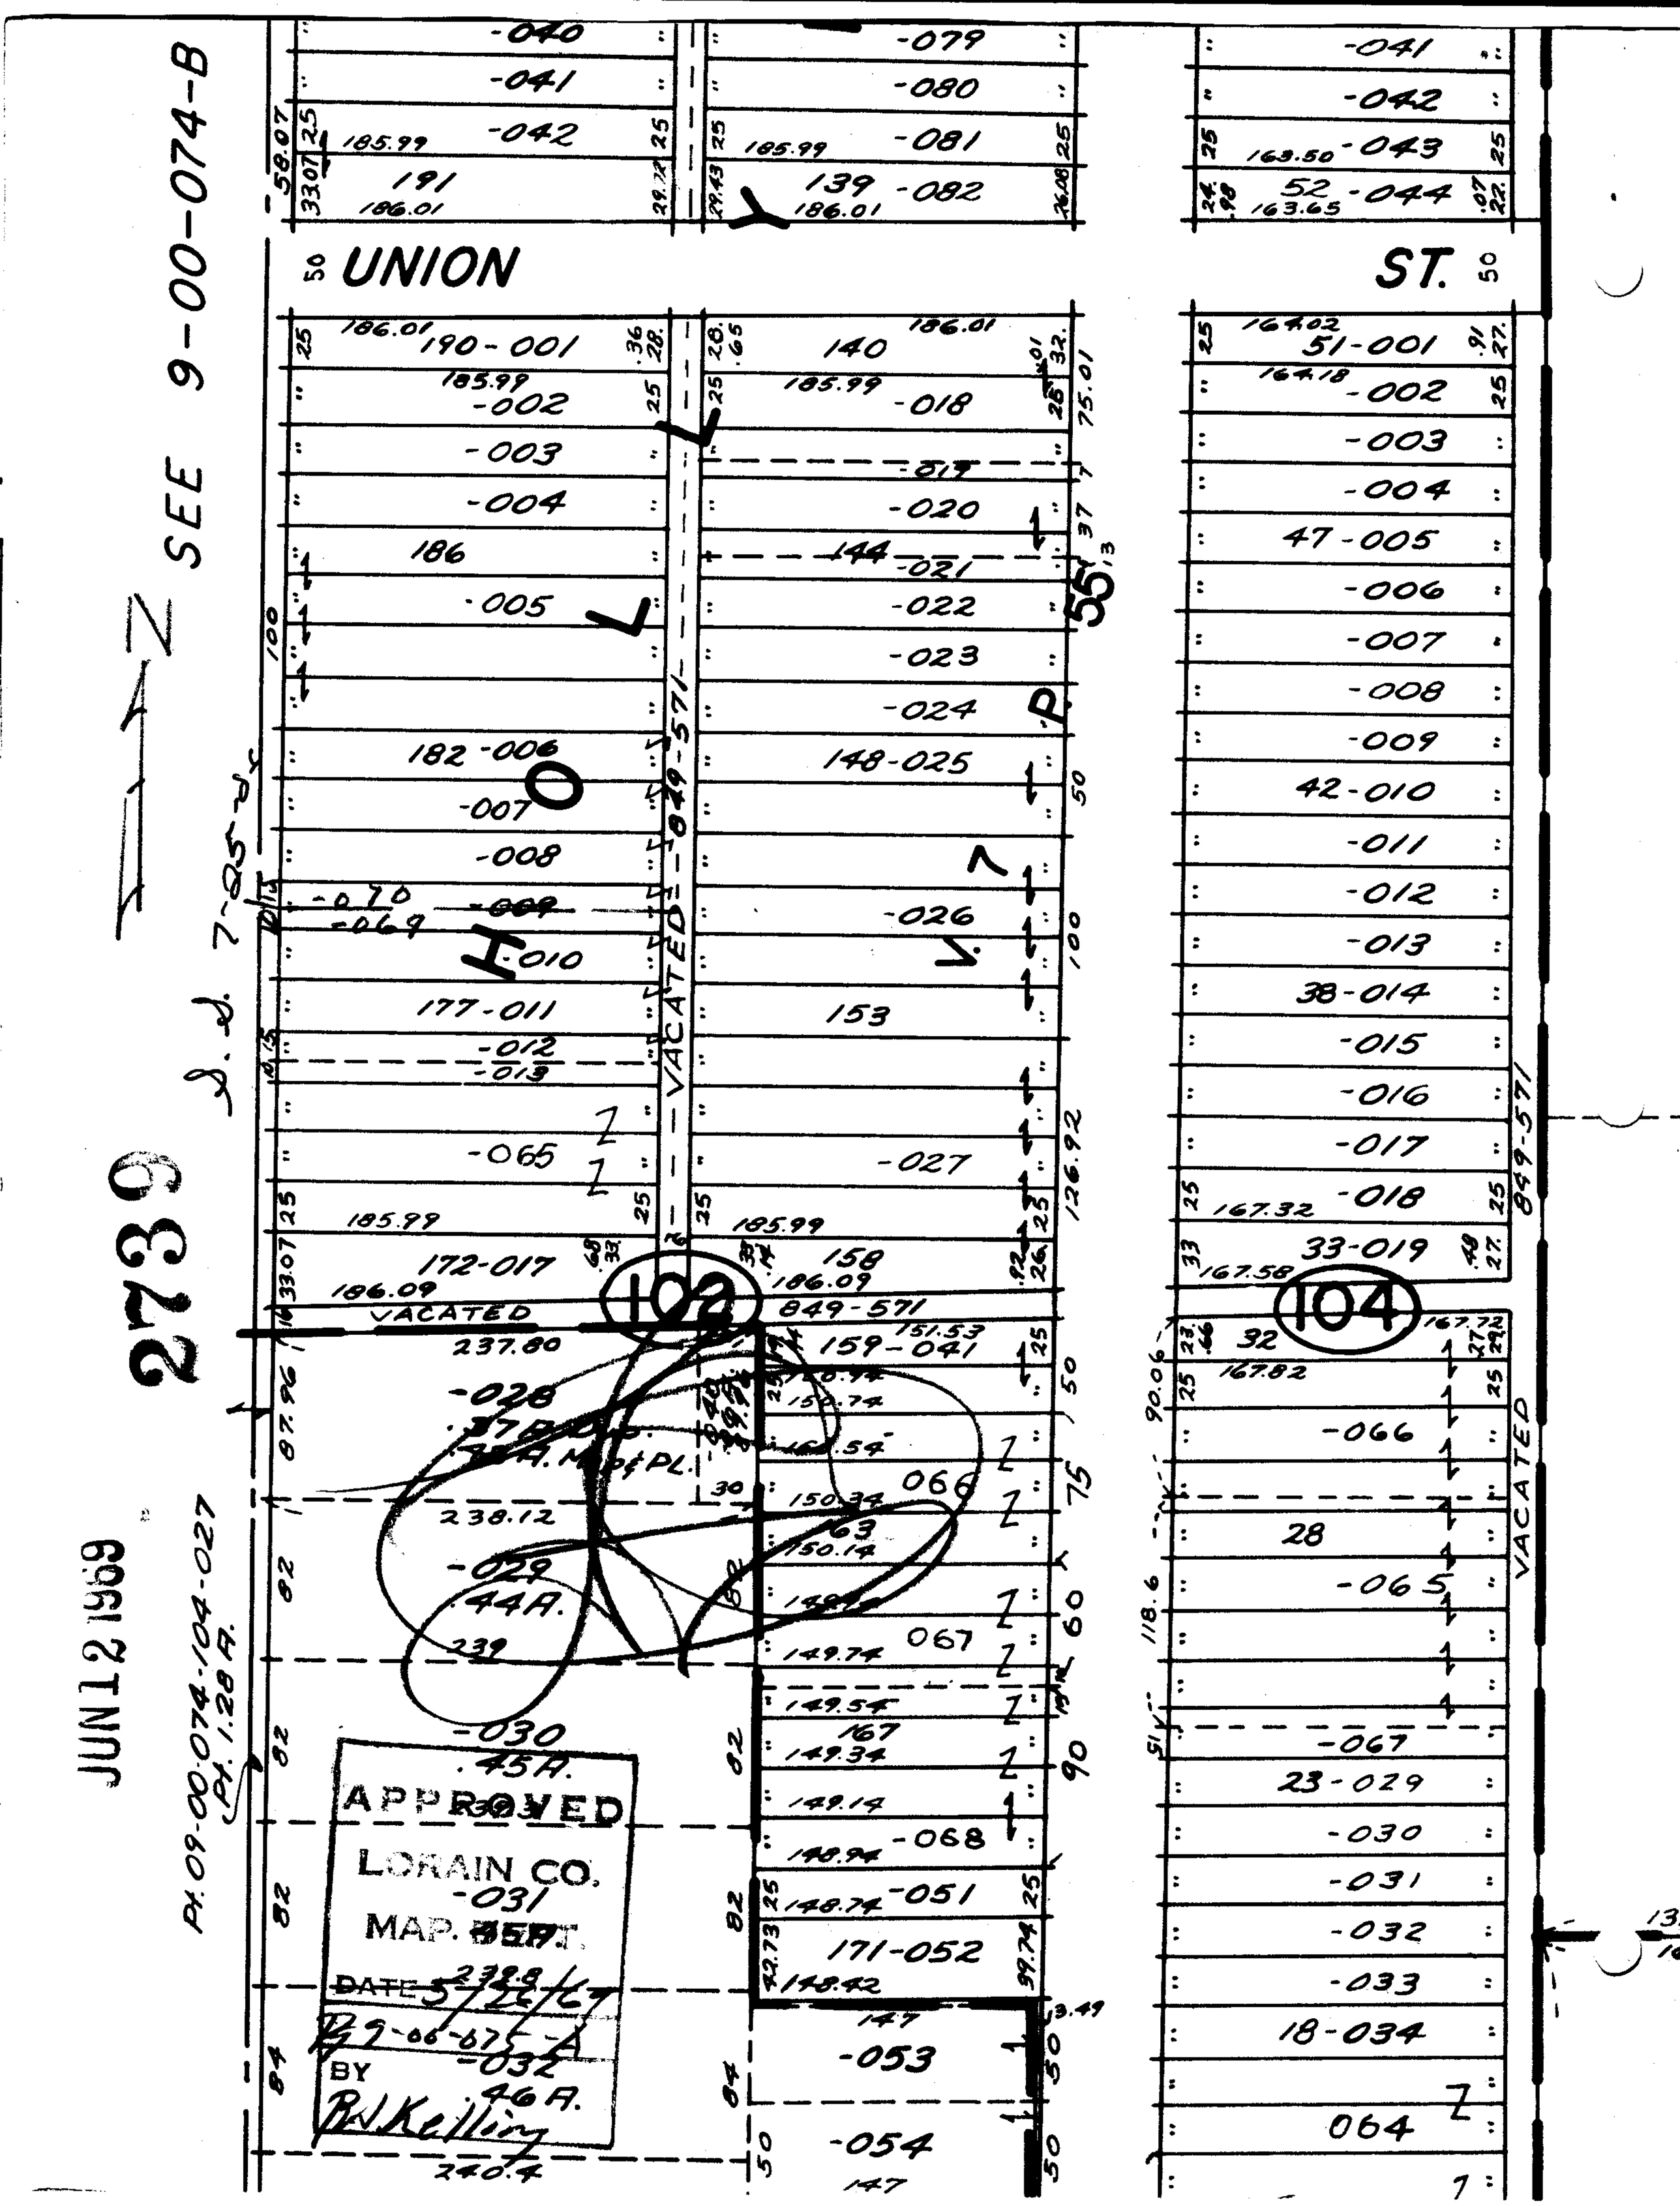

UNION
ST.
SEE 9-00-074-B
2739
JUN 12 1969
Pt. 09-00-074-104-027
Pt. 1.28 A.
VACATED
849-571
102
104
APPROVED
LORAIN CO.
MAP. DEPT.
DATE 5/26/67
BY
R.J. Kelling