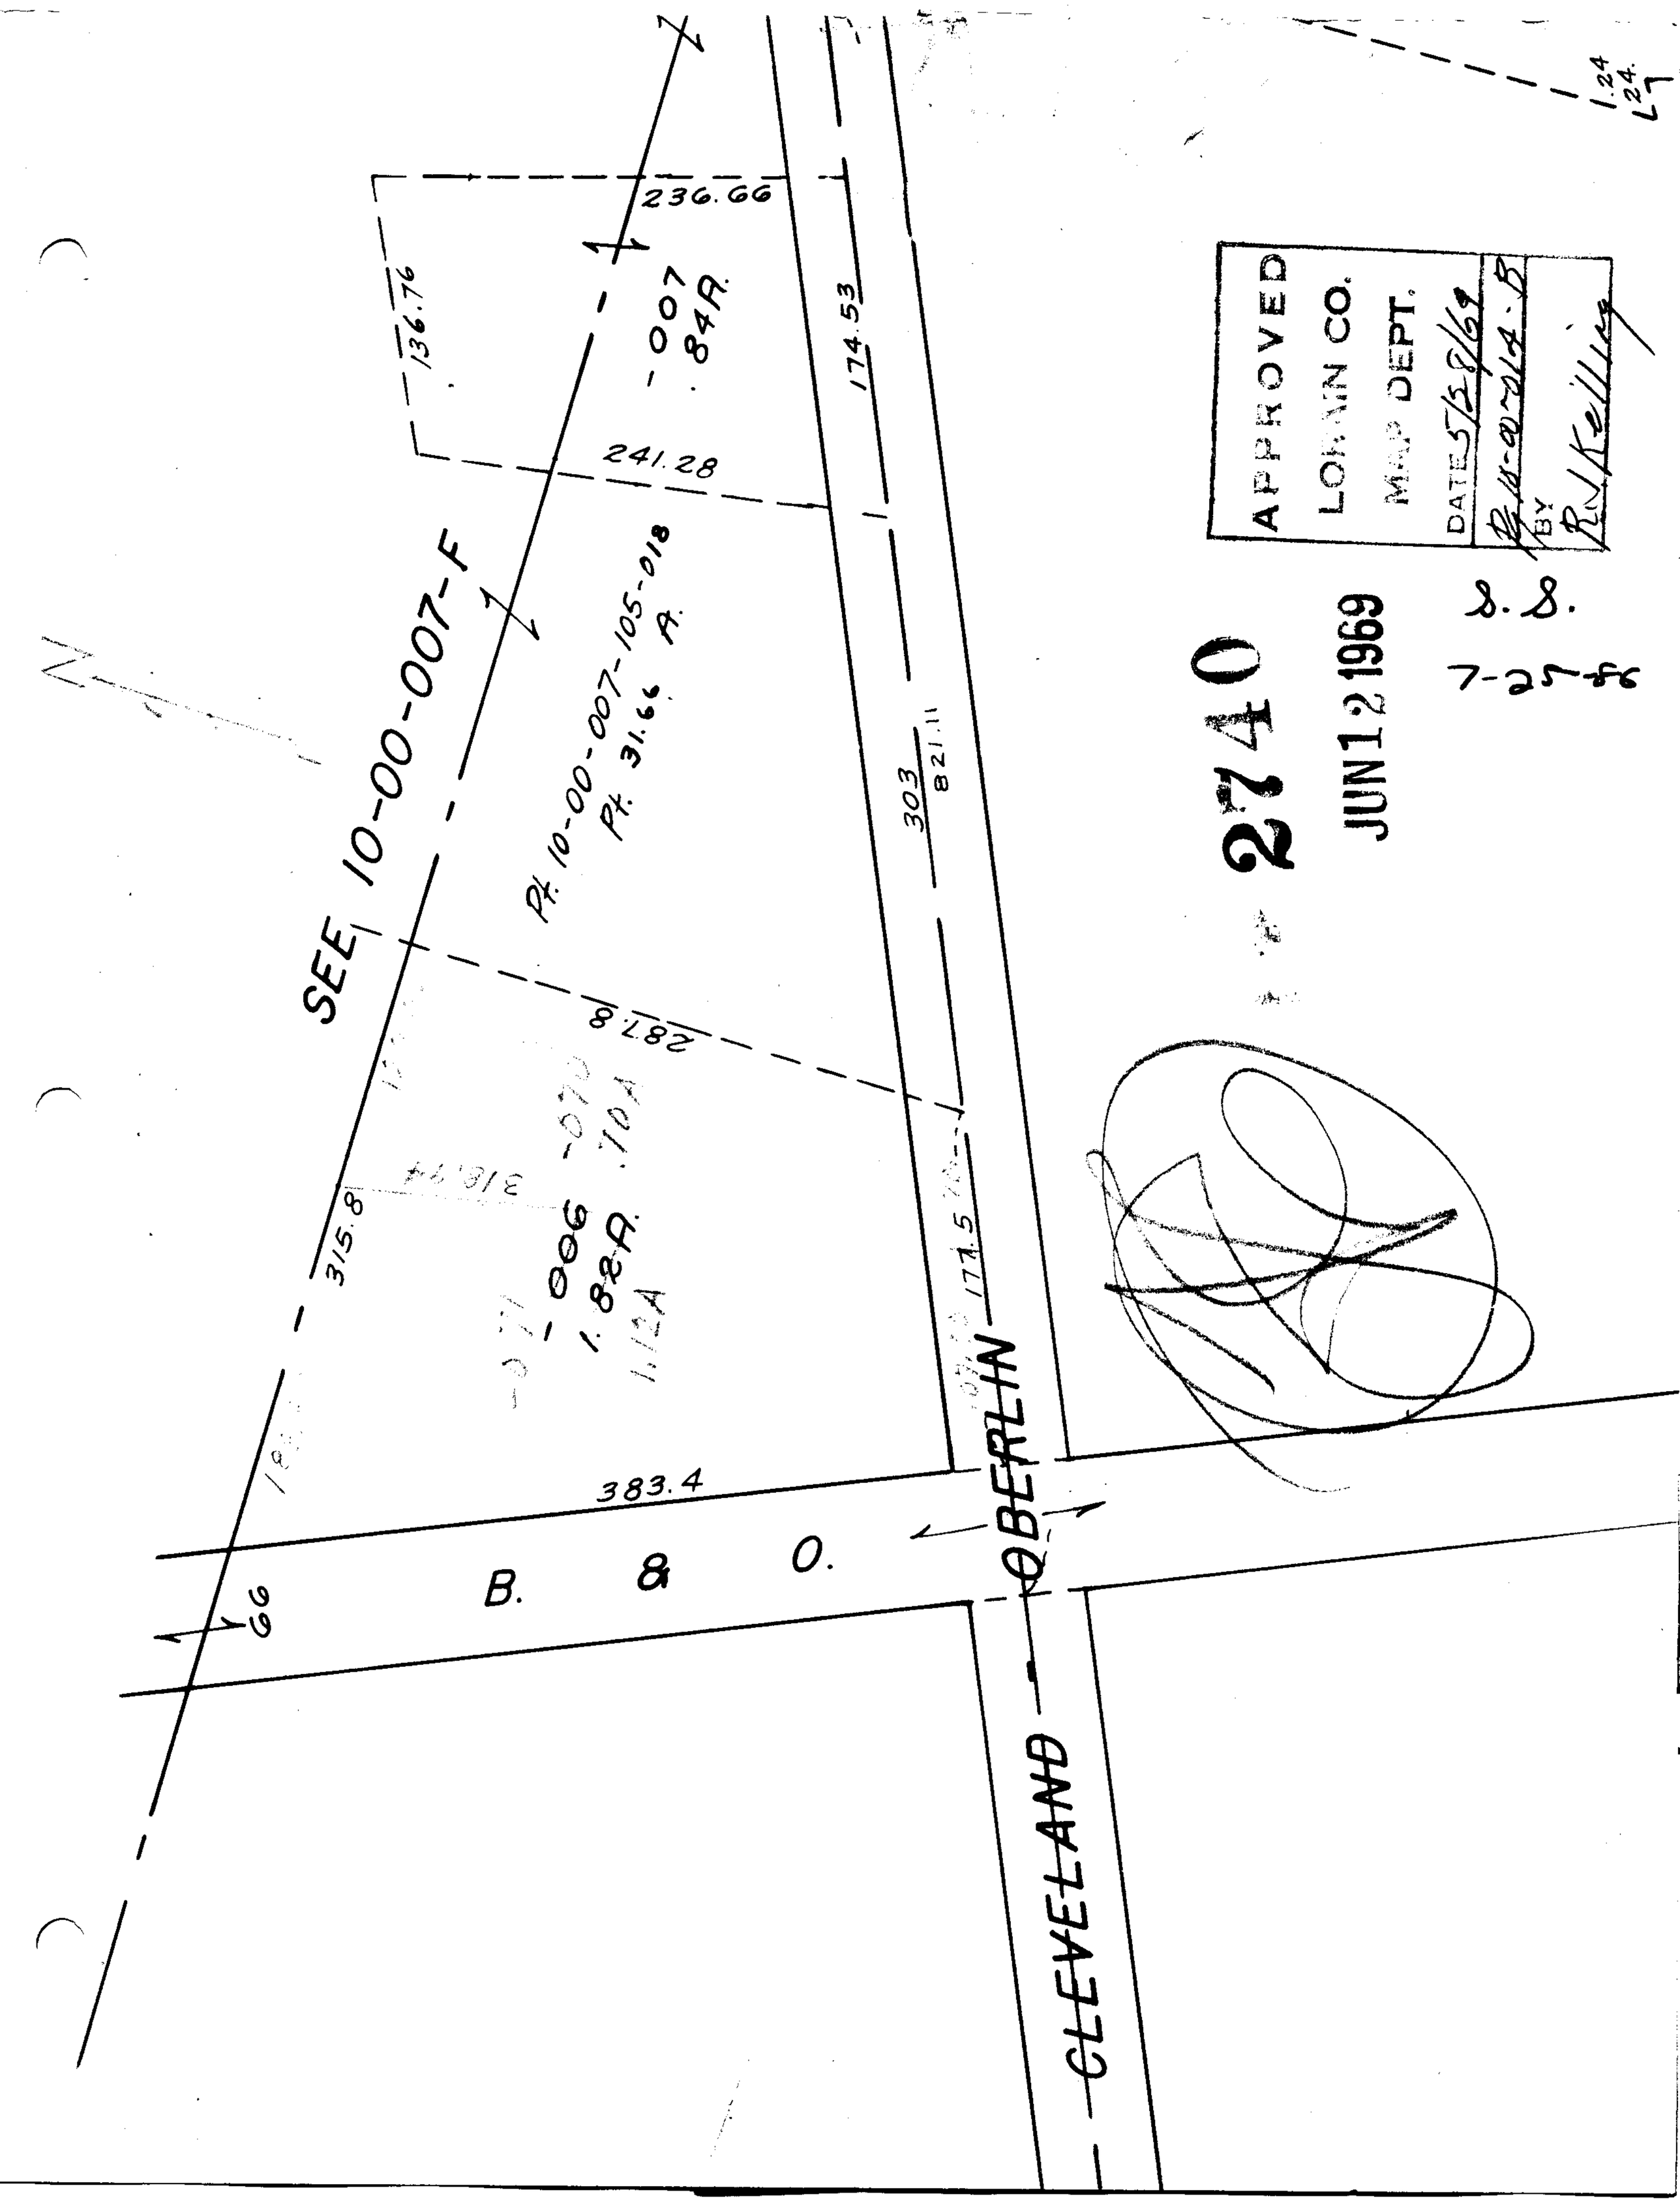

236.66
136.76
-007
84A.
174.53
241.28
SEE 10-00-007-F
Pt. 10-00-007-105-018
Pt. 31.66 A.
303
821.11
287.8
-006
1.82A.
315.8
177.5
383.4
B. & O.
66
OBERLIN
CLEVELAND
APPROVED
LORAIN CO.
MAP DEPT.
DATE 5/28/69
BY
S.S.
7-25-86
2740
JUN 12 1969