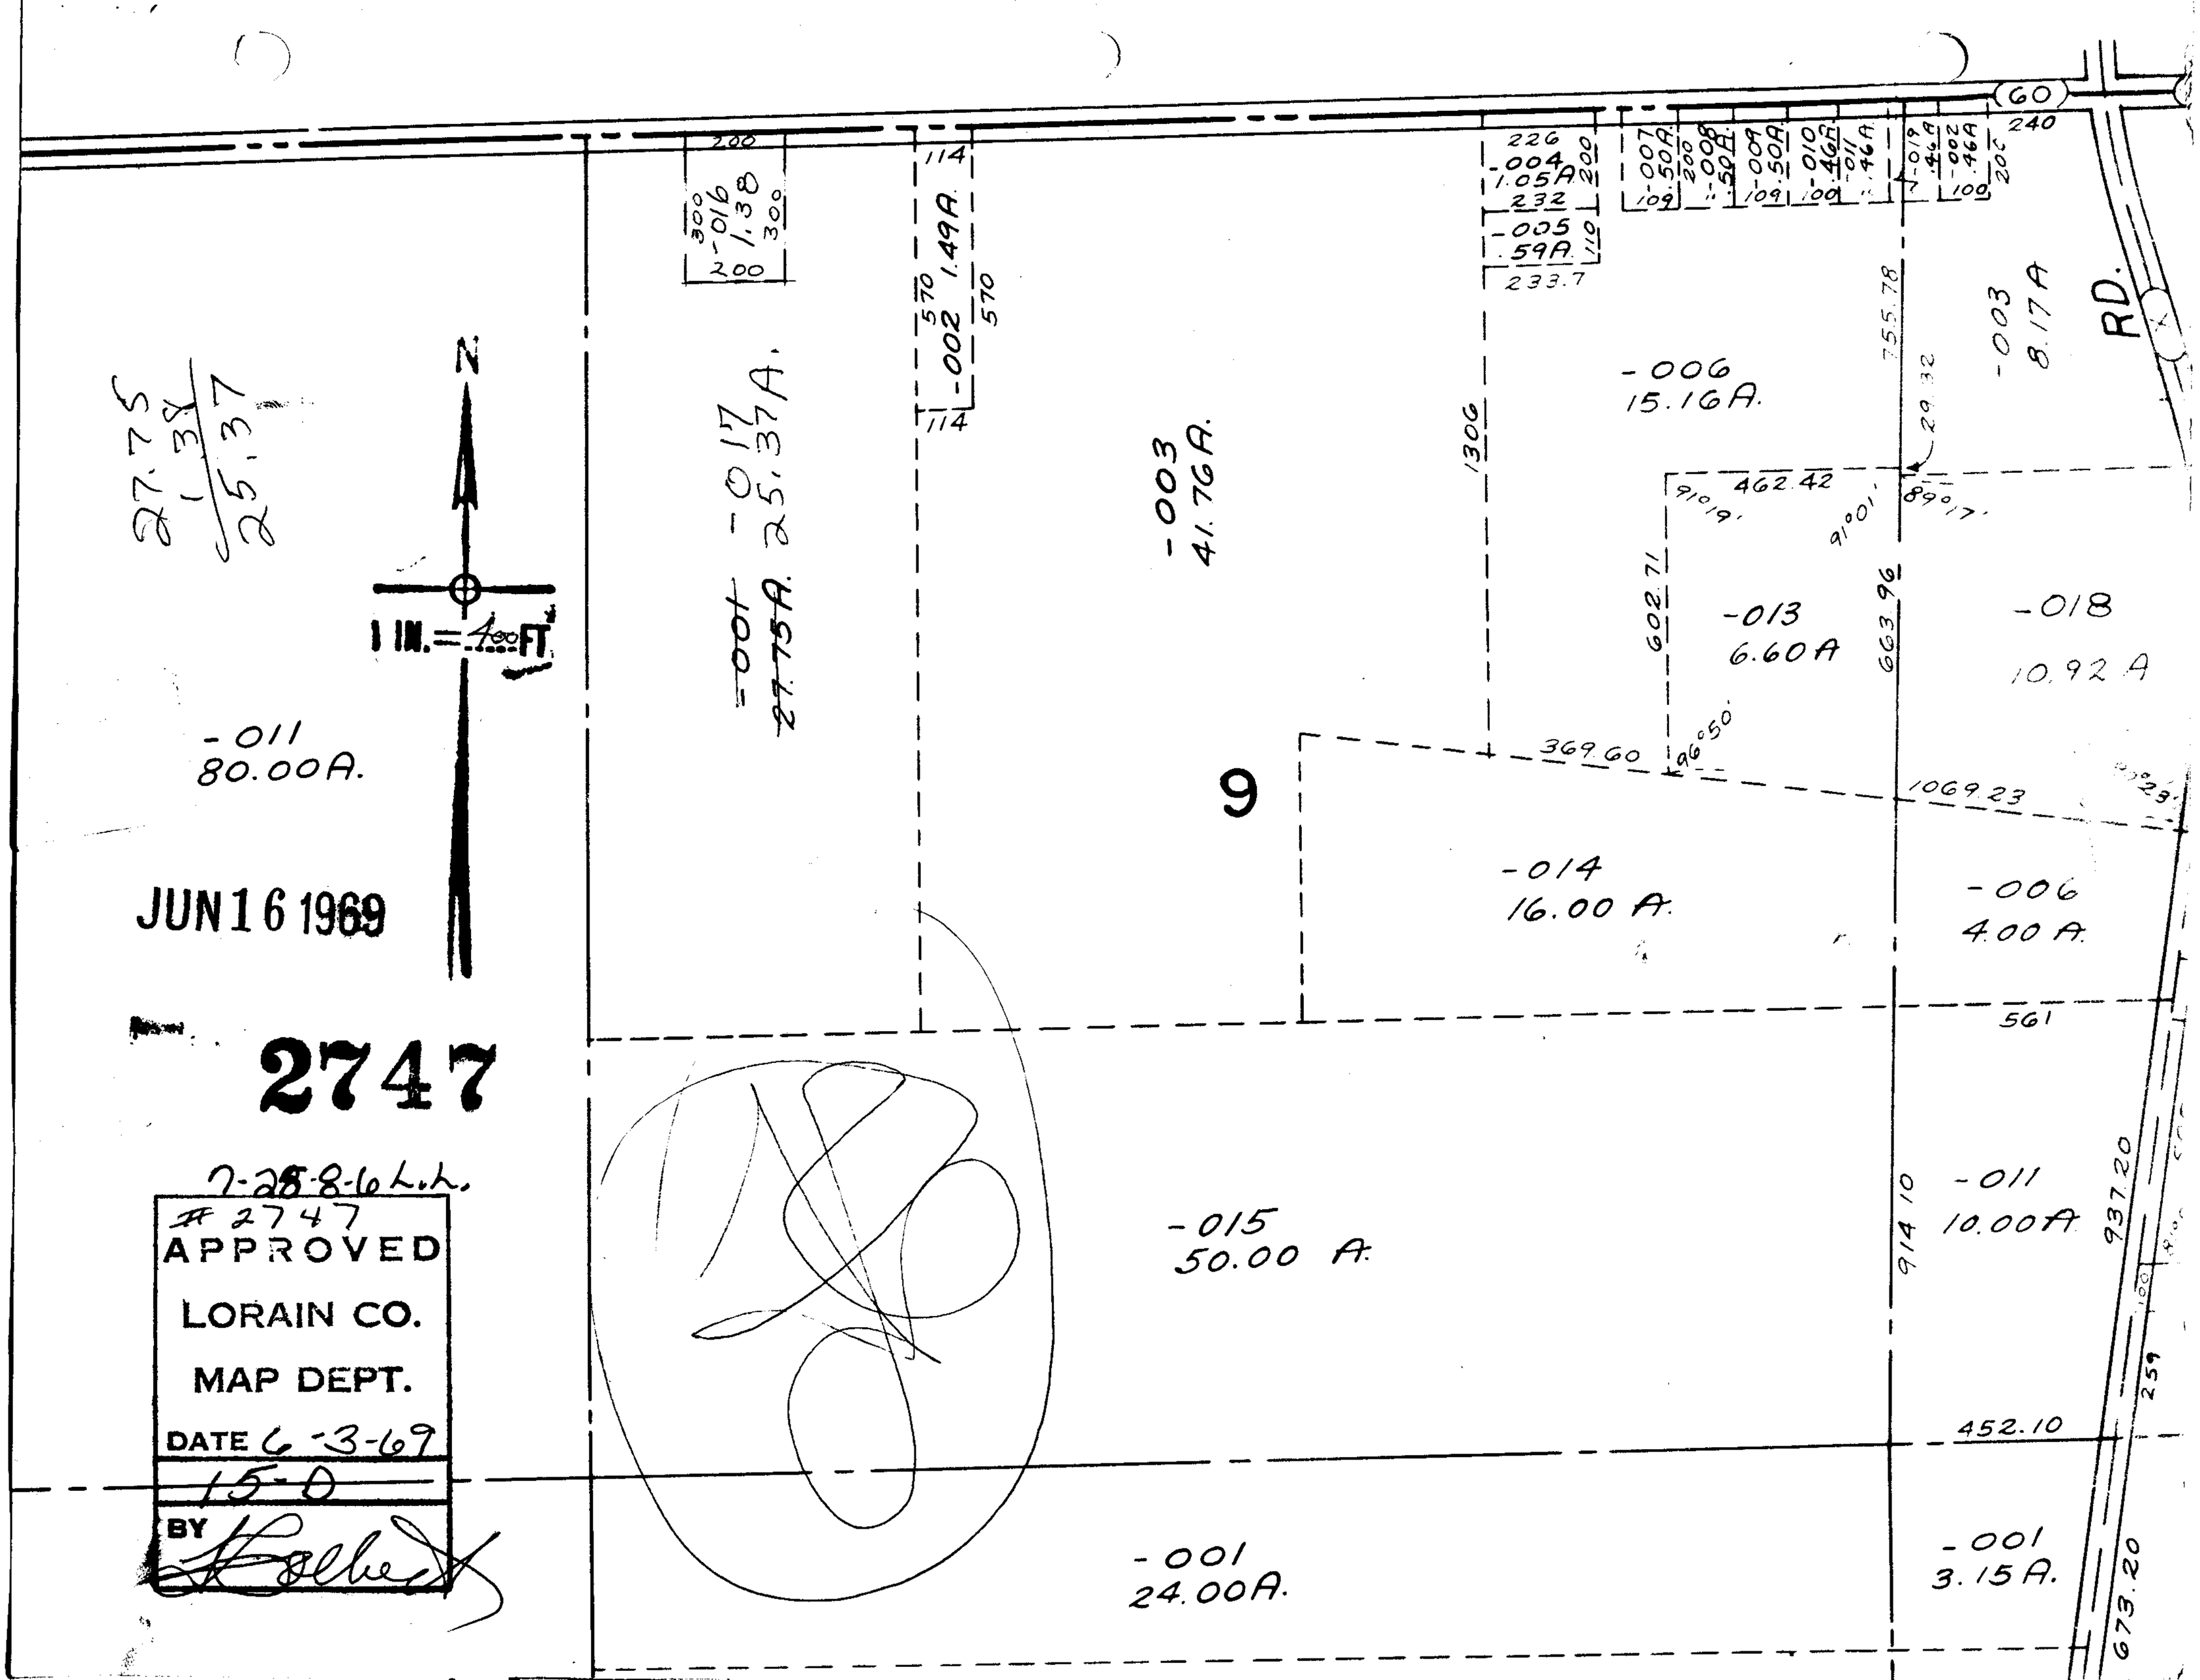

JUN 16 1969

2747

7-28-8-6 L.L.

#2747
APPROVED
LORAIN CO.
MAP DEPT.
DATE 6-3-69
15-0
BY